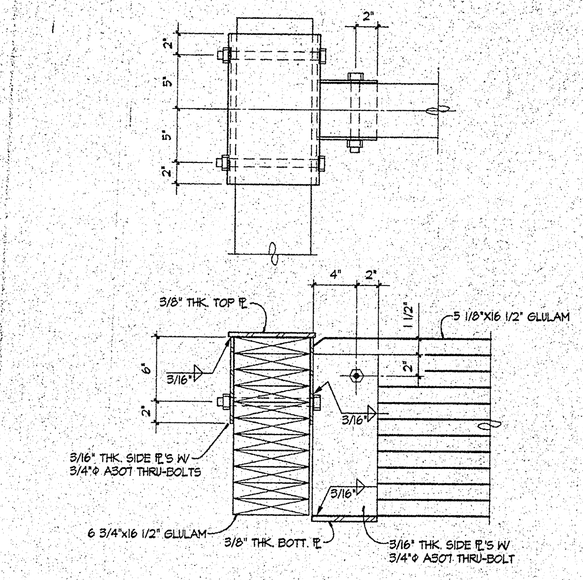

1 SECTION
1 1/2" = 1'-0"

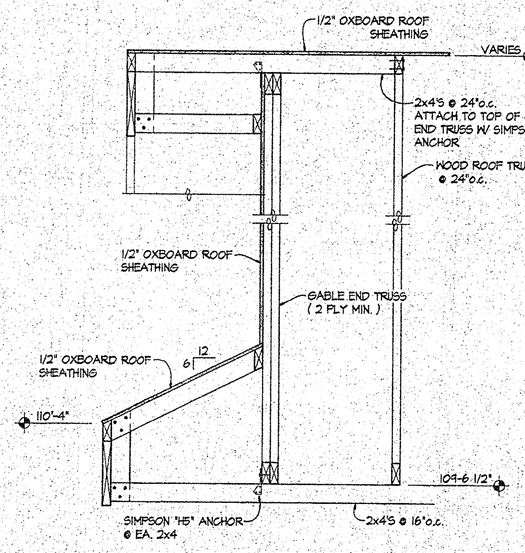

2 SECTION
1 1/2" = 1'-0"

Add'l sheet 2 thru 5 as shown on SD-53
Thru SD-56 - Add'l A

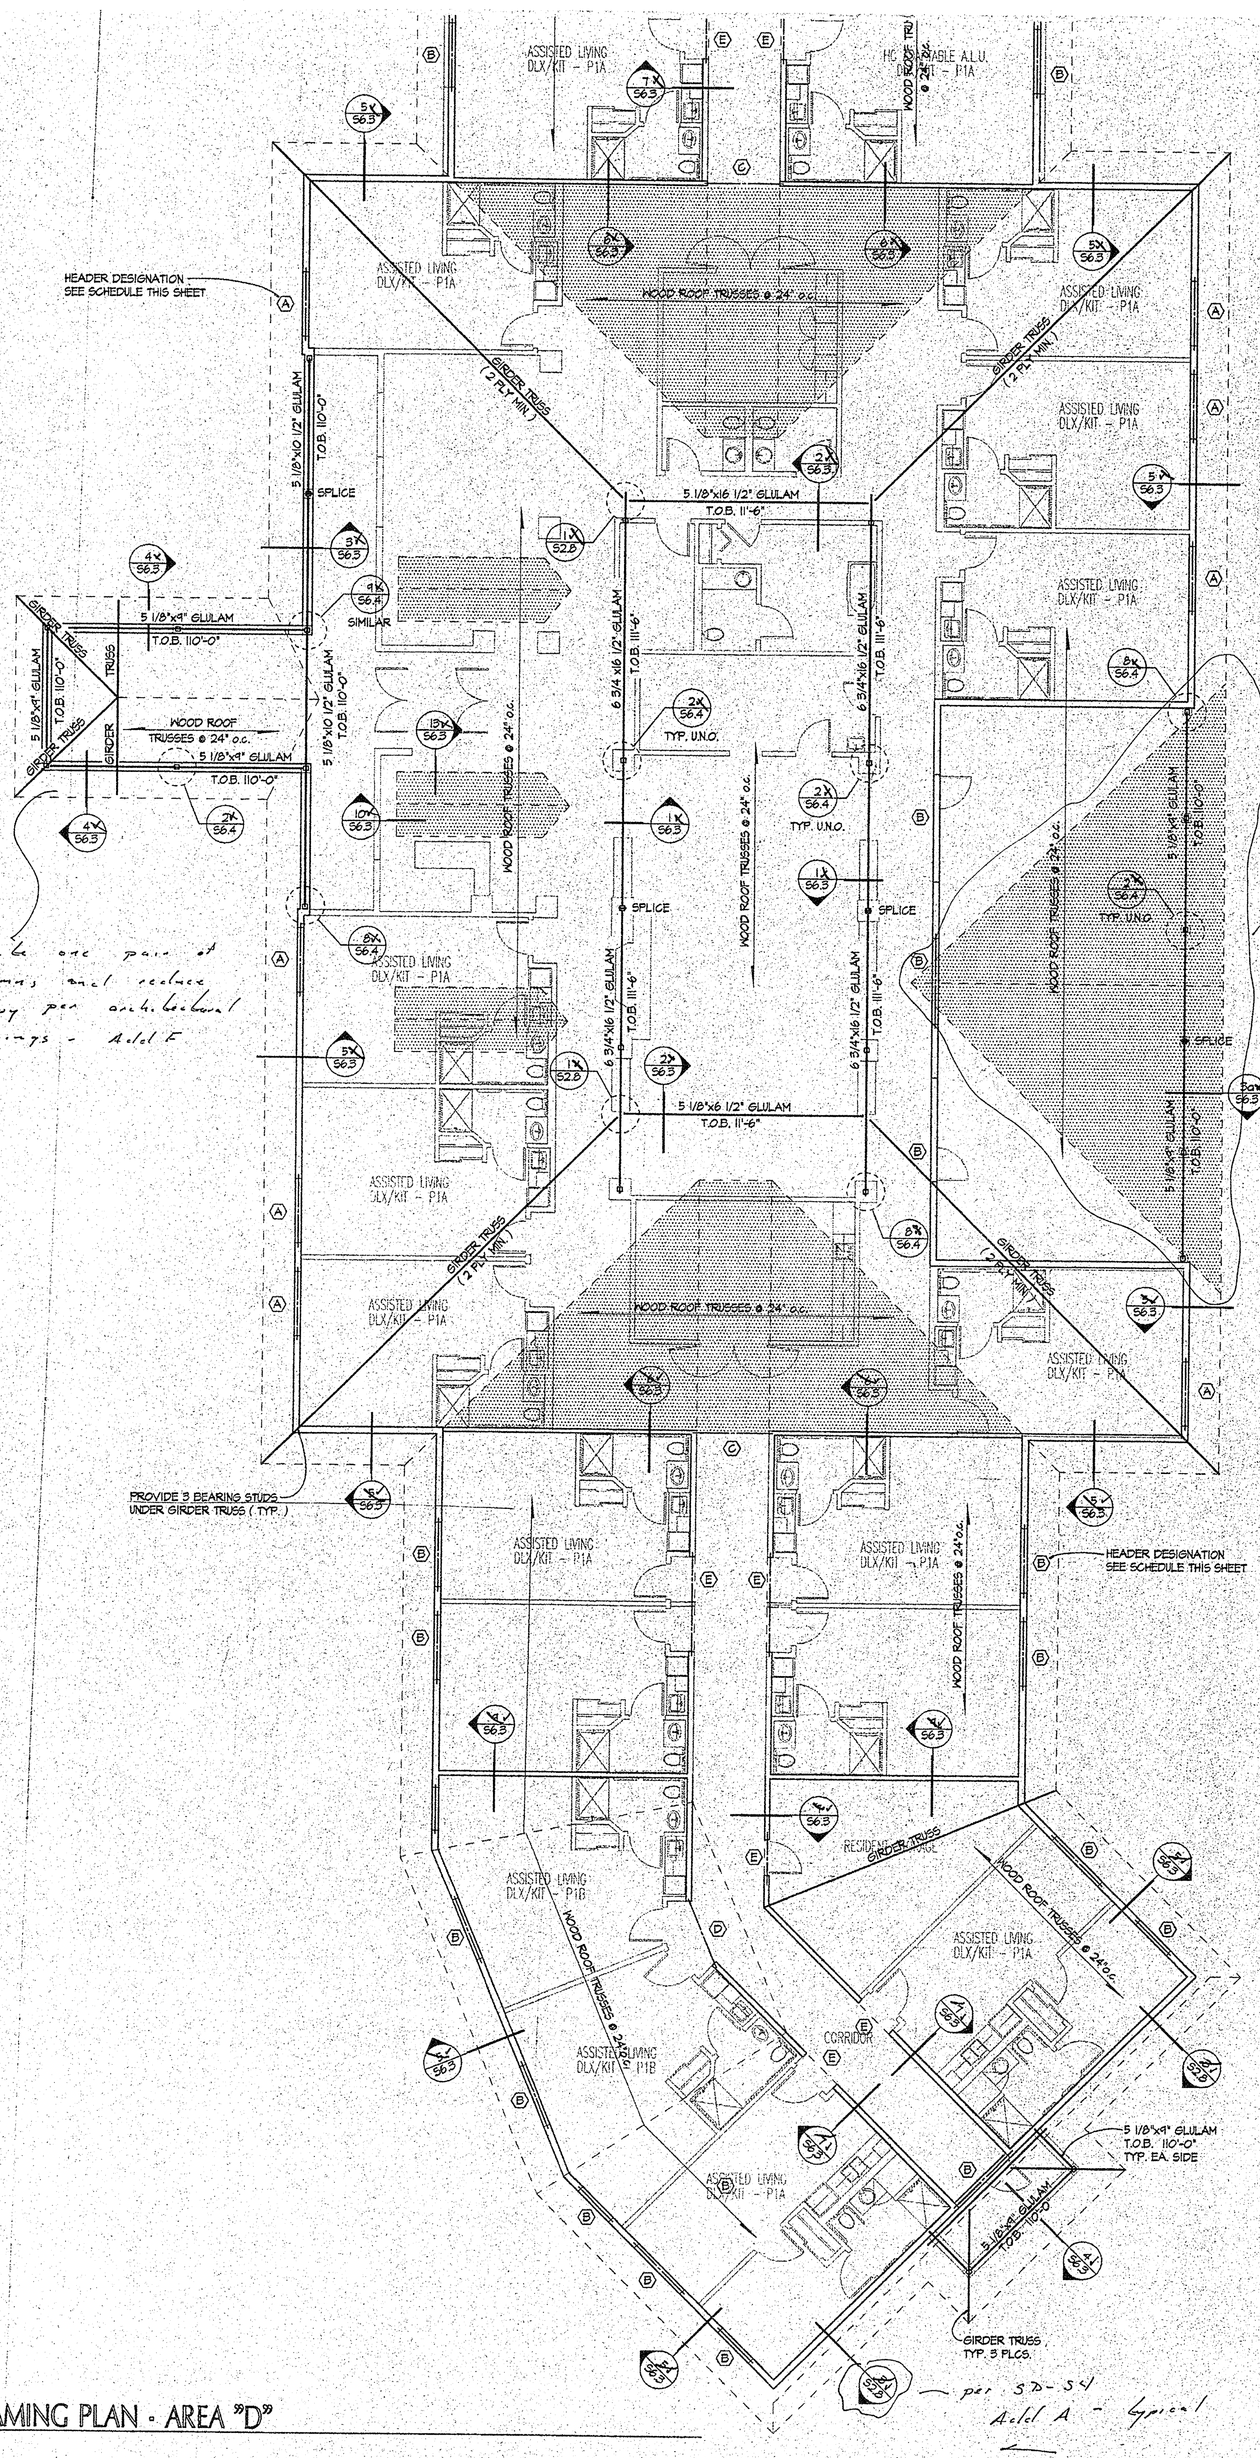

Delete one pair of columns and reduce canopy per arch. backup drawings - Add'l F

Delete gable - per Add'l F

110 - 0 1/2
11 1/4
109 - 1 1/4

ASSISTED LIVING ROOF FRAMING PLAN - AREA "D"
NORTH 1/8" = 1'-0"

NOTE : SEE STRUCTURAL NOTES ON SHEET S2.0

HEADER SCHEDULE			
MARK	HEADER	BEARING STUDS F.F.	JAMB STUDS F.F.
A	3 - 2 x 10'S	2 - 2 x 6'S	1 - 2 x 6
B	3 - 2 x 8'S	1 - 2 x 6	1 - 2 x 6
C	2 - 2 x 12'S	2 - 2 x 4'S	1 - 2 x 4
D	2 - 2 x 10'S	2 - 2 x 4'S	1 - 2 x 4
E	2 - 2 x 8'S	1 - 2 x 4	1 - 2 x 4
F	2 - 1 3/4" x 9 1/2" MICROLAMS	2 - 2 x 4'S	1 - 2 x 4
G	2 - 1 3/4" x 11 7/8" MICROLAMS	3 - 2 x 4'S	1 - 2 x 4

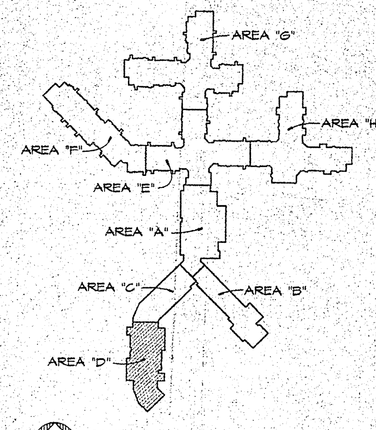

KEY PLAN
NORTH NO SCALE

These documents have been prepared for the CHRISTWOOD RETIREMENT CENTER project. They are not suitable for use on other projects or in other locations without the express written consent and permission of RDG Schutte Wilscam Birge Inc. Reproduction is prohibited.
© RDG Schutte Wilscam Birge

STATE OF LOUISIANA
MITCHELL HYMANS
No. 32410
REGISTERED PROFESSIONAL ENGINEER
CIVIL ENGINEERING
THOMPSON, ENGLEBERT & DORNER, INC.
STRUCTURAL ENGINEERS

RDG Schutte Wilscam Birge
8805 Indian Hills Drive Suite 100 Omaha, Nebraska 68114 402-392-0133 Fax: 402-392-0423
ARCHITECTURE INTERIOR DESIGN PLANNING

CHRISTWOOD
A CONTINUING CARE RETIREMENT FACILITY
COVINGTON LOUISIANA

DATE: 25NOVEMBER1994
PROJECT #: 9204100
FILE: 2:5

S2.8

RENAISSANCE DESIGN GROUP • RENAISSANCE DESIGN GROUP • RENAISSANCE DESIGN GROUP • RENAISSANCE DESIGN GROUP • RENAISSANCE DESIGN GROUP • RENAISSANCE DESIGN GROUP • RENAISSANCE DESIGN GROUP • RENAISSANCE DESIGN GROUP • RENAISSANCE DESIGN GROUP • RENAISSANCE DESIGN GROUP • RENAISSANCE DESIGN GROUP • RENAISSANCE DESIGN GROUP