


EXISTING RIGHT SIDE ELEVATION
 SCALE: 1/8"=1'-0"

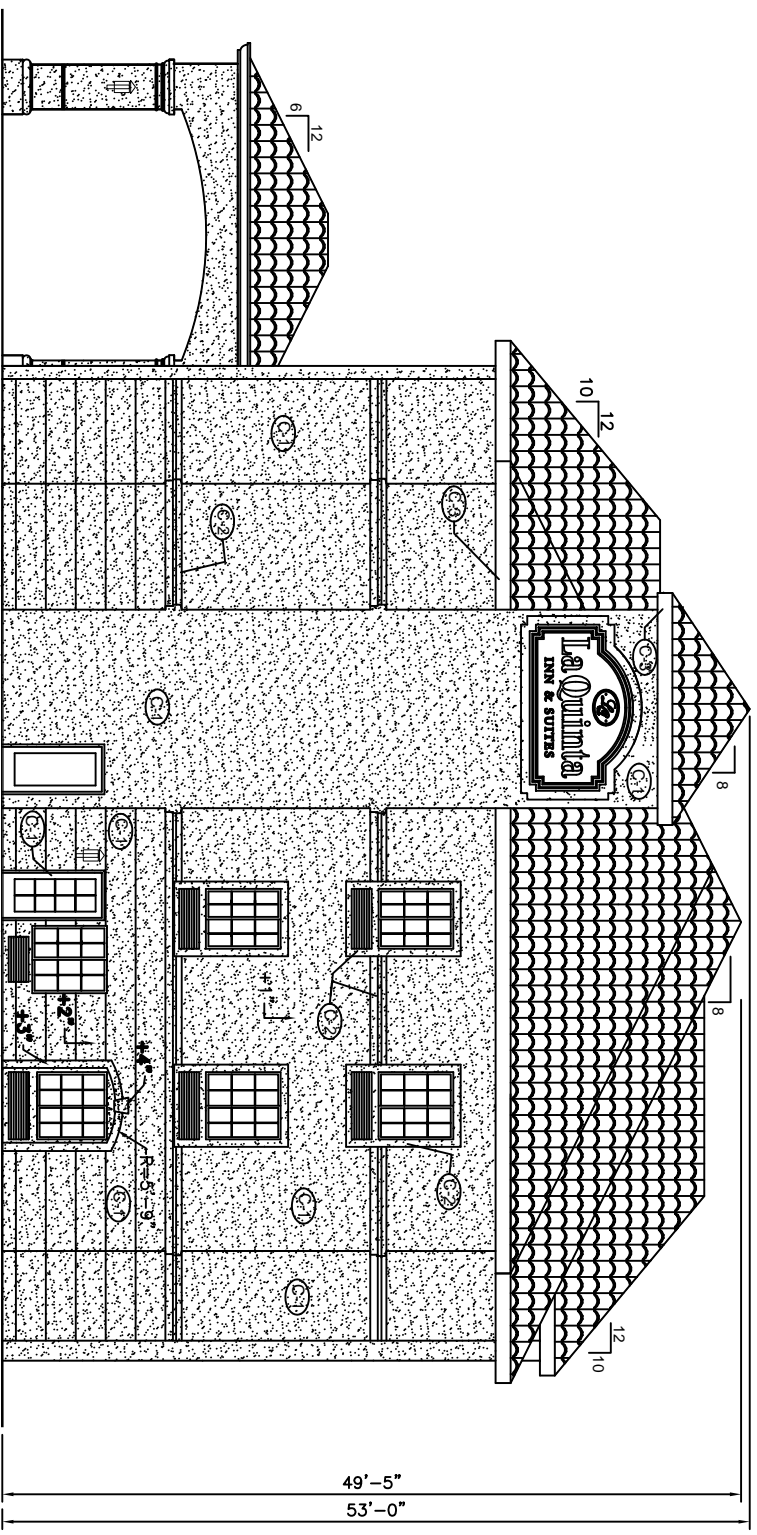

NEW RIGHT SIDE ELEVATION
 SCALE: 1/8"=1'-0"