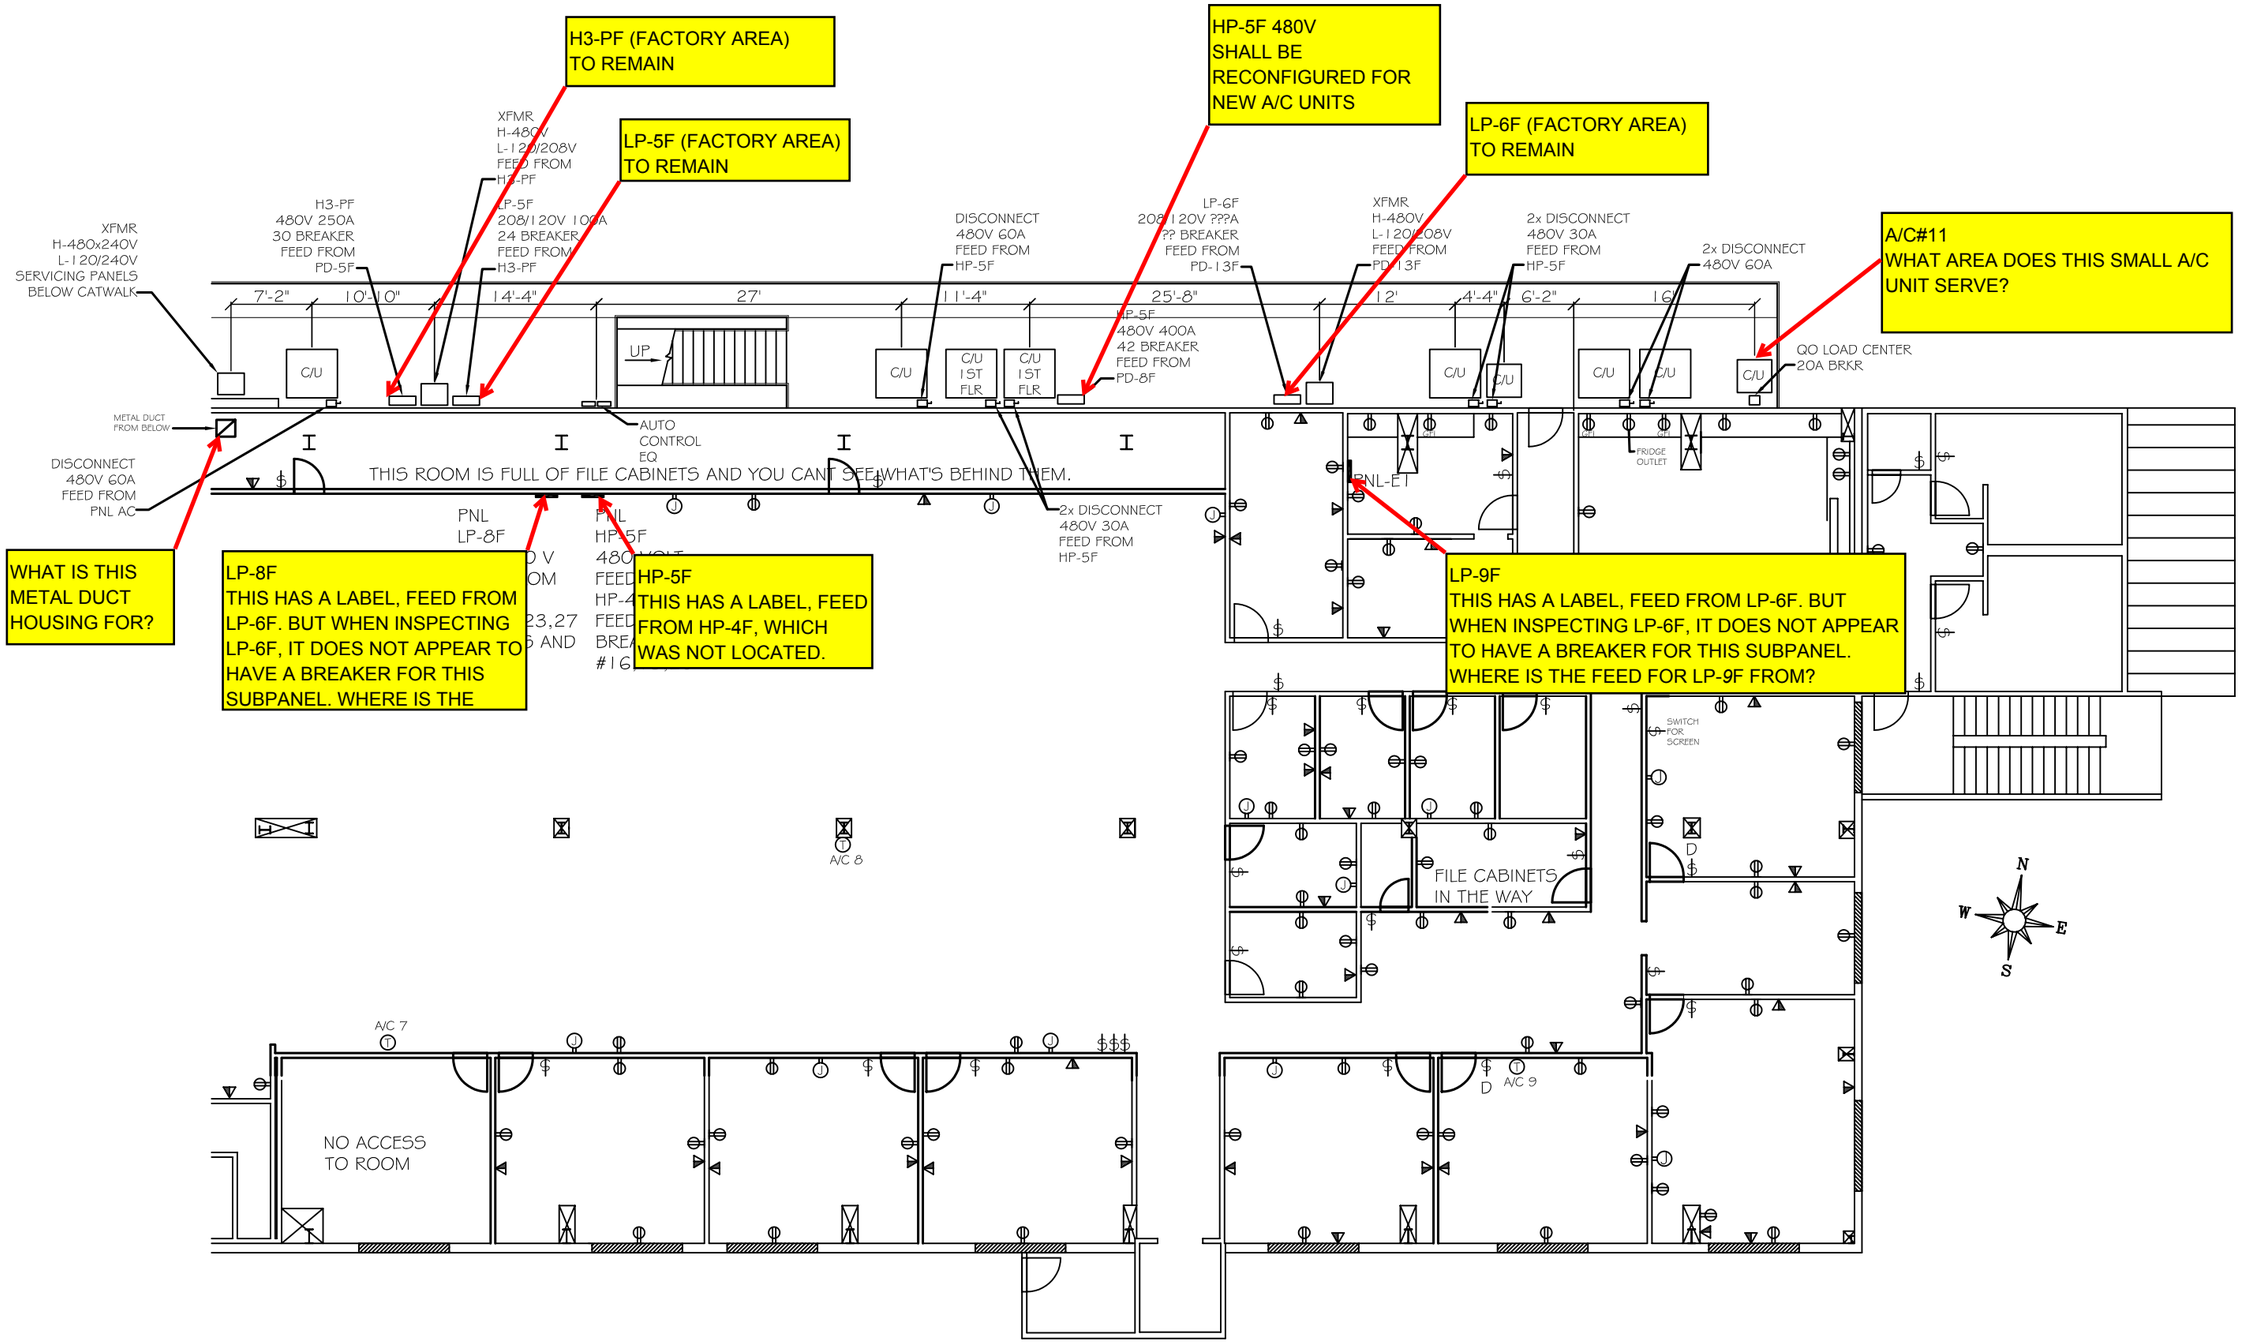
H3-PF (FACTORY AREA) TO REMAIN
LP-5F (FACTORY AREA) TO REMAIN
HP-5F 480V SHALL BE RECONFIGURED FOR NEW A/C UNITS
LP-6F (FACTORY AREA) TO REMAIN
A/C#11 WHAT AREA DOES THIS SMALL A/C UNIT SERVE?
WHAT IS THIS METAL DUCT HOUSING FOR?
LP-8F THIS HAS A LABEL, FEED FROM LP-6F. BUT WHEN INSPECTING LP-6F, IT DOES NOT APPEAR TO HAVE A BREAKER FOR THIS SUBPANEL. WHERE IS THE
HP-5F THIS HAS A LABEL, FEED FROM HP-4F, WHICH WAS NOT LOCATED.
LP-9F THIS HAS A LABEL, FEED FROM LP-6F. BUT WHEN INSPECTING LP-6F, IT DOES NOT APPEAR TO HAVE A BREAKER FOR THIS SUBPANEL. WHERE IS THE FEED FOR LP-9F FROM?
XFMR H-480x240V L-120/240V SERVICING PANELS BELOW CATWALK
H3-PF 480V 250A 30 BREAKER FEED FROM PD-5F
XFMR H-480V L-120/208V FEED FROM H3-PF
LP-5F 208/120V 100A 24 BREAKER FEED FROM H3-PF
DISCONNECT 480V 60A FEED FROM HP-5F
LP-6F 208/120V ???A ?? BREAKER FEED FROM PD-13F
LP-5F 480V 400A 42 BREAKER FEED FROM PD-8F
XFMR H-480V L-120/208V FEED FROM PD-13F
2x DISCONNECT 480V 30A FEED FROM HP-5F
2x DISCONNECT 480V 60A
QO LOAD CENTER 20A BRKR
7'-2"
10'-10"
14'-4"
27'
11'-4"
25'-8"
12'
4'-4"
6'-2"
16'
C/U
C/U 1ST FLR
UP
METAL DUCT FROM BELOW
DISCONNECT 480V 60A FEED FROM PNL AC
AUTO CONTROL EQ
THIS ROOM IS FULL OF FILE CABINETS AND YOU CANT SEE WHAT'S BEHIND THEM.
PNL LP-8F
PNL HP-5F
2x DISCONNECT 480V 30A FEED FROM HP-5F
PNL-ET
FRIDGE OUTLET
SWITCH FOR SCREEN
FILE CABINETS IN THE WAY
A/C 8
A/C 7
A/C 9
NO ACCESS TO ROOM
N
W
E
S