


3 HAIRLINE CRACKS IN
HALLWAY ceiling

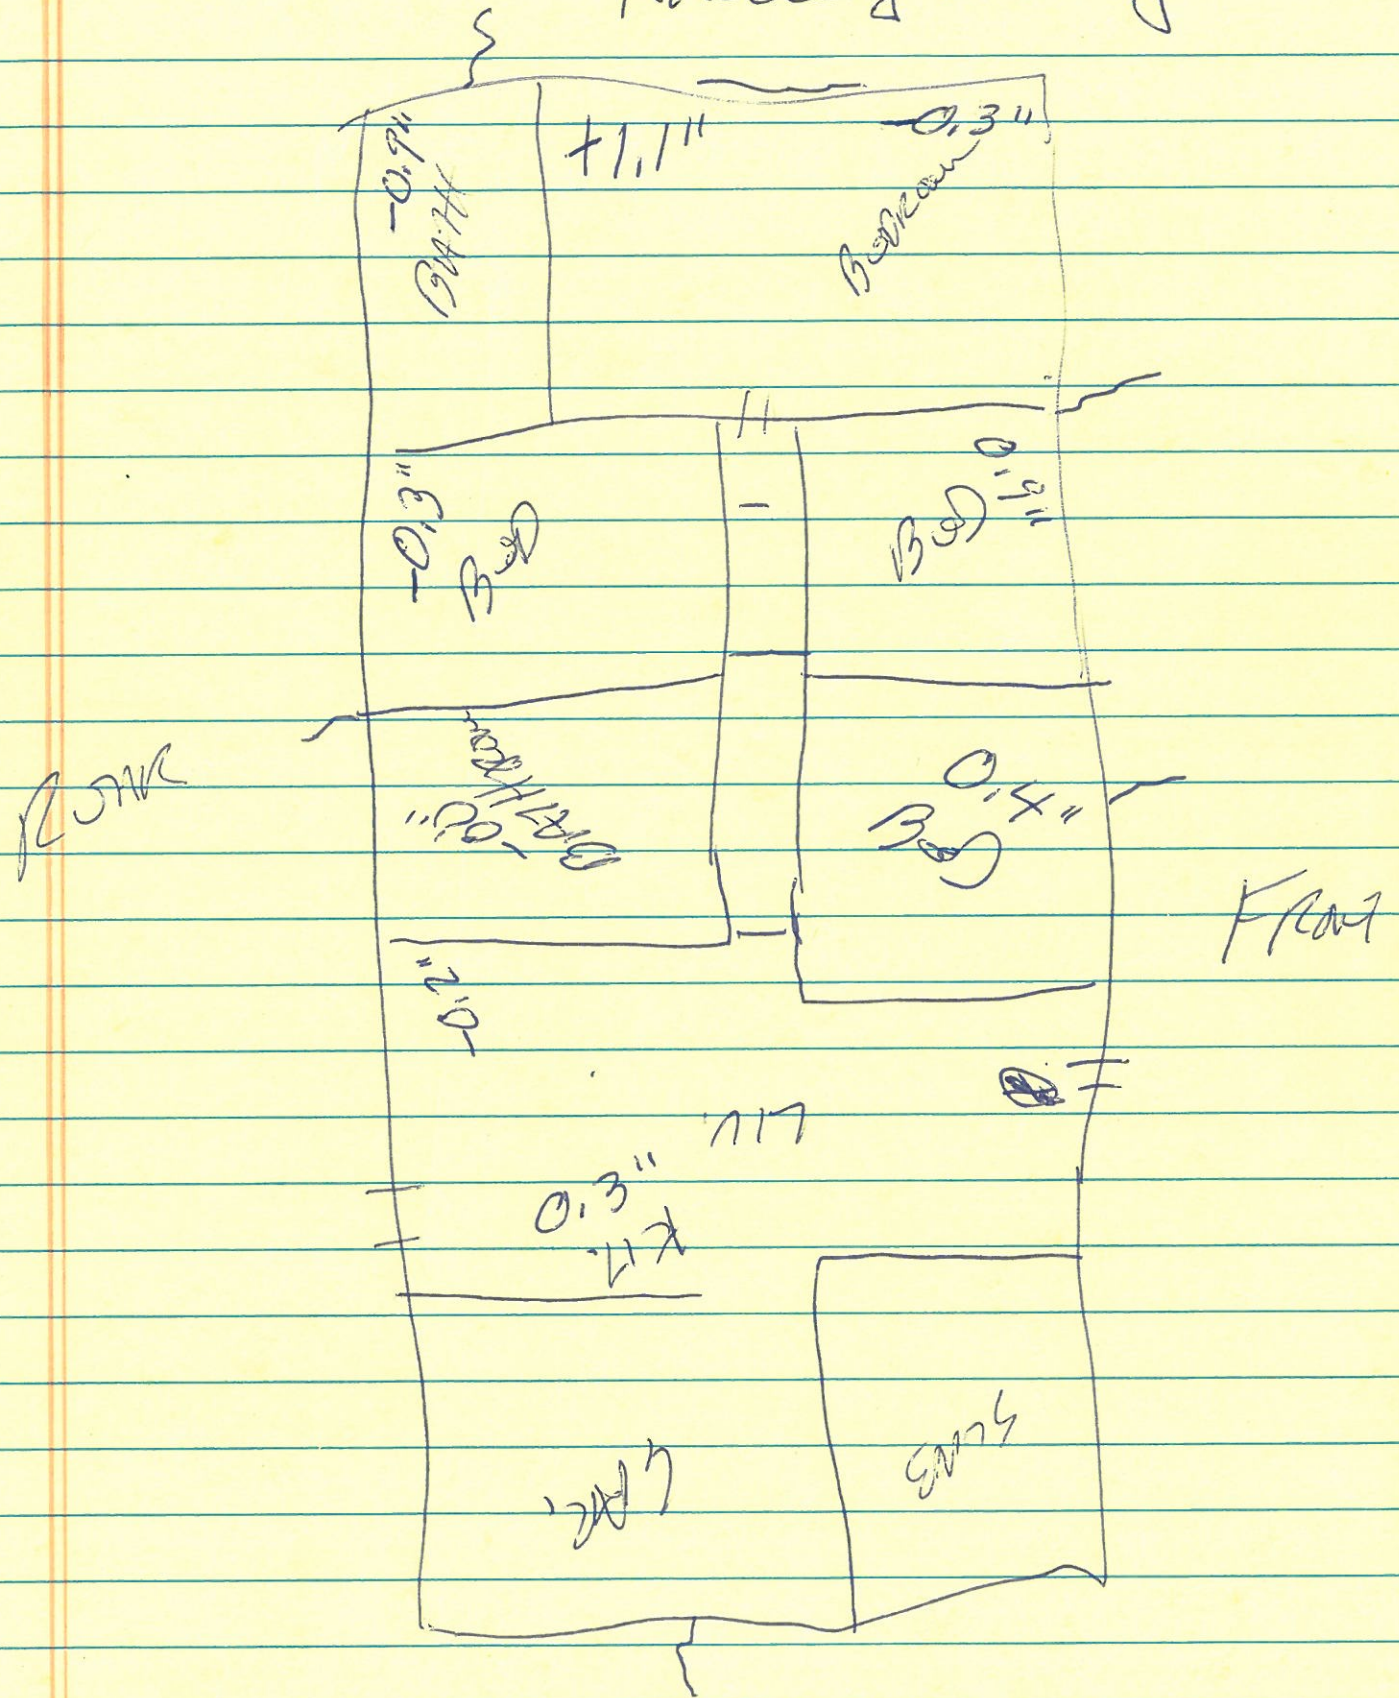

Rocky Taylor 985-960-6651

dntrkracer@yahoo.com

4821 MAGNOLIA DRIVE

SLIDELL, LA. 70458