

# Dammon Engineering, Inc.

dammonengineering.com

1095 Florida Ave.  
Slidell, LA 70458

P.O. Box 2830  
Slidell, LA 70459

985-649-5832  
FAX 985-641-5950

November 21, 2008

Mr. Otis Ramke  
Office of State Fire Marshal  
8181 Independence Blvd.  
Baton Rouge, LA 70806

L.A. S.F.M. PLAN REVIEW  
PC# 337937 REVIEWER \_\_\_\_\_  
READING FILE DATE MO \_\_\_\_\_ YR \_\_\_\_\_  
ORIG TO: \_\_\_\_\_  
SENDER \_\_\_\_\_ APPL. \_\_\_\_\_ OWNER \_\_\_\_\_  
CC'S \_\_\_\_\_  
COPY WHAT PGS. \_\_\_\_\_  
B.R. \_\_\_\_\_ N.O.  ALEX \_\_\_\_\_ LAF. \_\_\_\_\_  
SHREVE \_\_\_\_\_ HO. FILE \_\_\_\_\_ HO. DEPT. \_\_\_\_\_  
DET FILE \_\_\_\_\_ HR FILE \_\_\_\_\_ NON-REQ. SYST. \_\_\_\_\_  
OTHER \_\_\_\_\_

RE: P0337937  
HIGHLANDS INDUSTRIAL PARK

*MODIFICATION APPEARS  
TO BE ACCEPTABLE  
Otis Ramke, ~  
11/24/08*

Dear Mr. Ramke,

With regard to the above referenced project. Changes in the office layout have been changed. The allowed travel distance for a single exit in business is 100 ft. The change in office layout created a maximum travel distance of 82'-6" for this project.

Please see attached.

If you have any questions, please feel free to call.

Sincerely,



David Dammon  
Project Manager


337937

REVIEWED FOR  
STATE FIRE MARSHAL  
AS PER REVIEW LETTER  
BY: OTIS V. RAMKE  
*O. Ramke, Jr.*

BAY #3

DC	
1	3/0/0
2	3/0/0
3	1/0/0
4	3-3/4
5	3/0/0
6	0
7	0
8	0

WHDC	
A	3/0/0
B	0

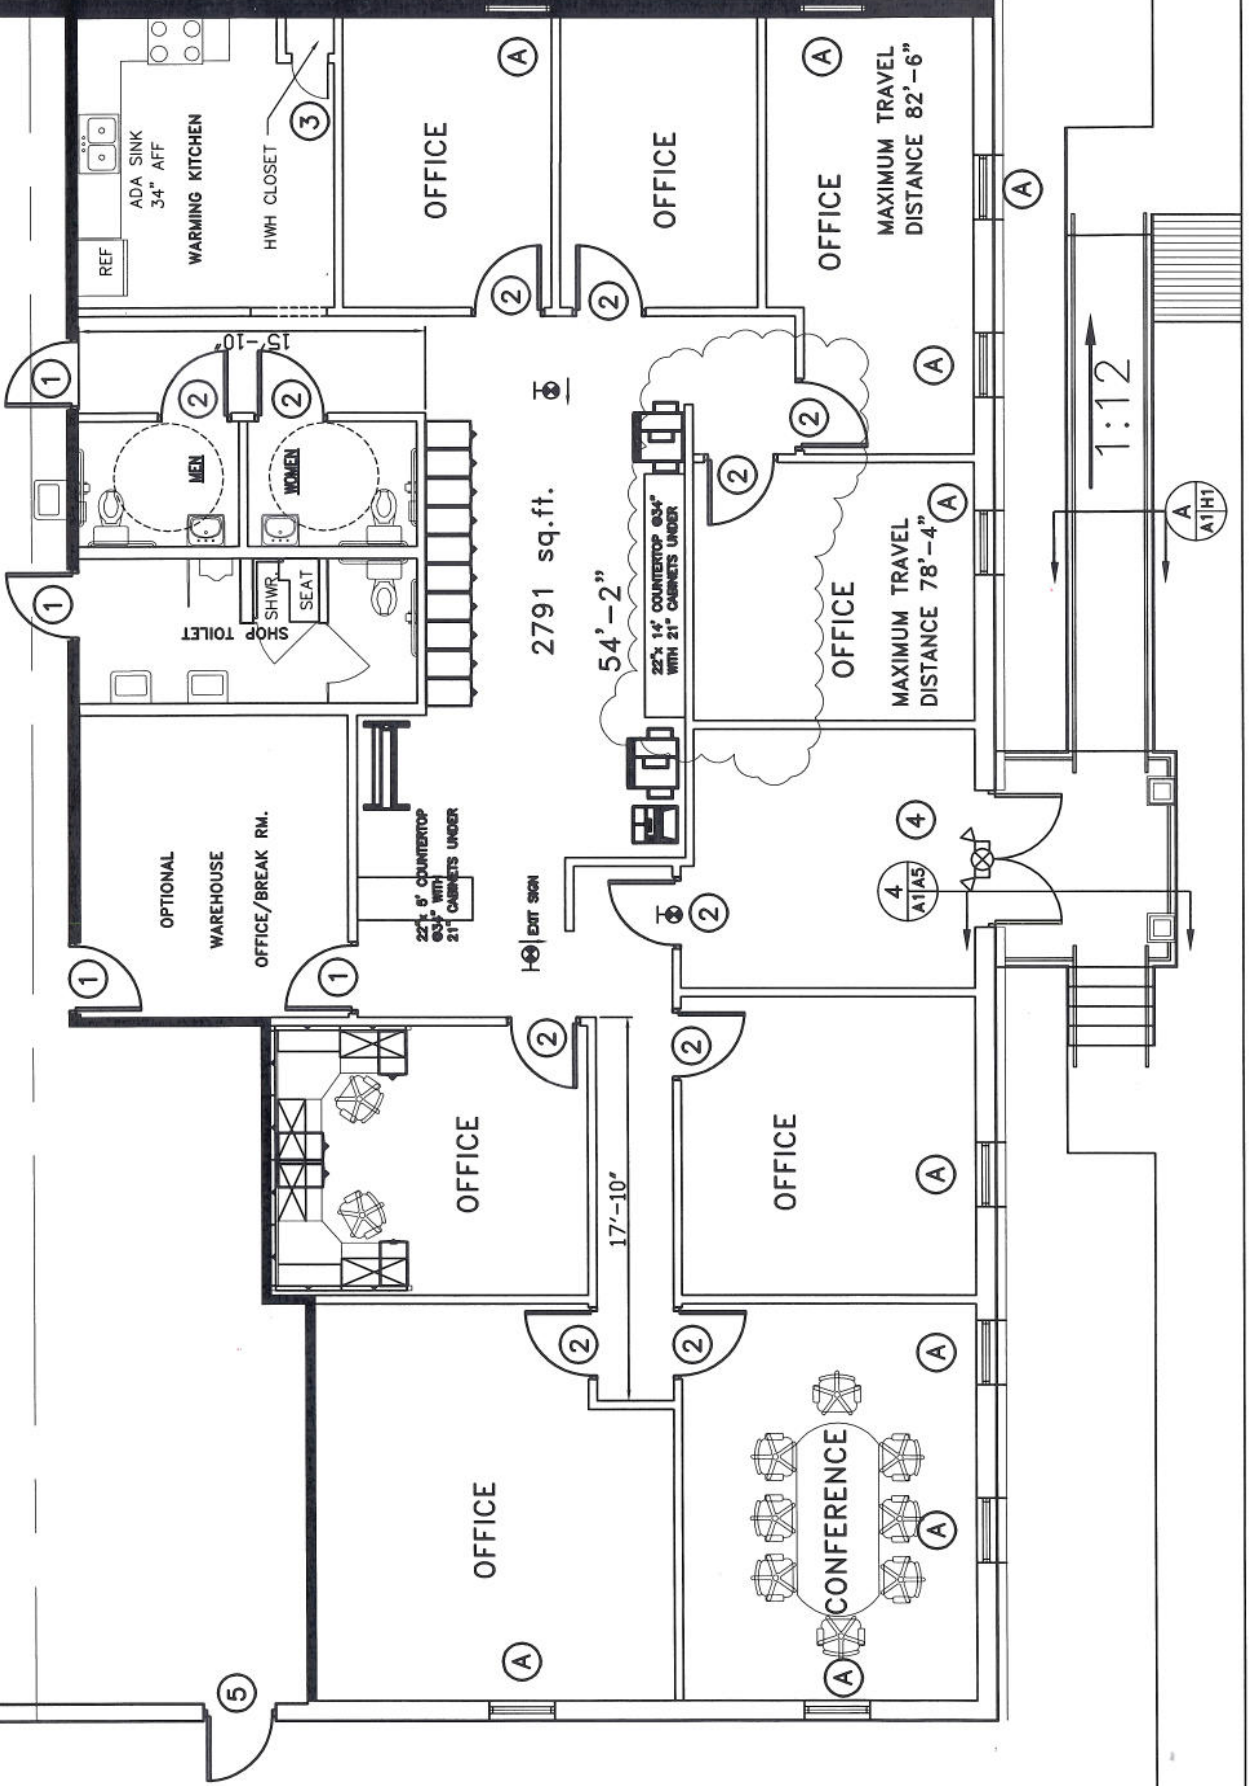

2