


FILE NAME: \\s:\otms\mwh\2016\2016-06-16\2016-06-16.dwg PLOT DATE: 6/11/16

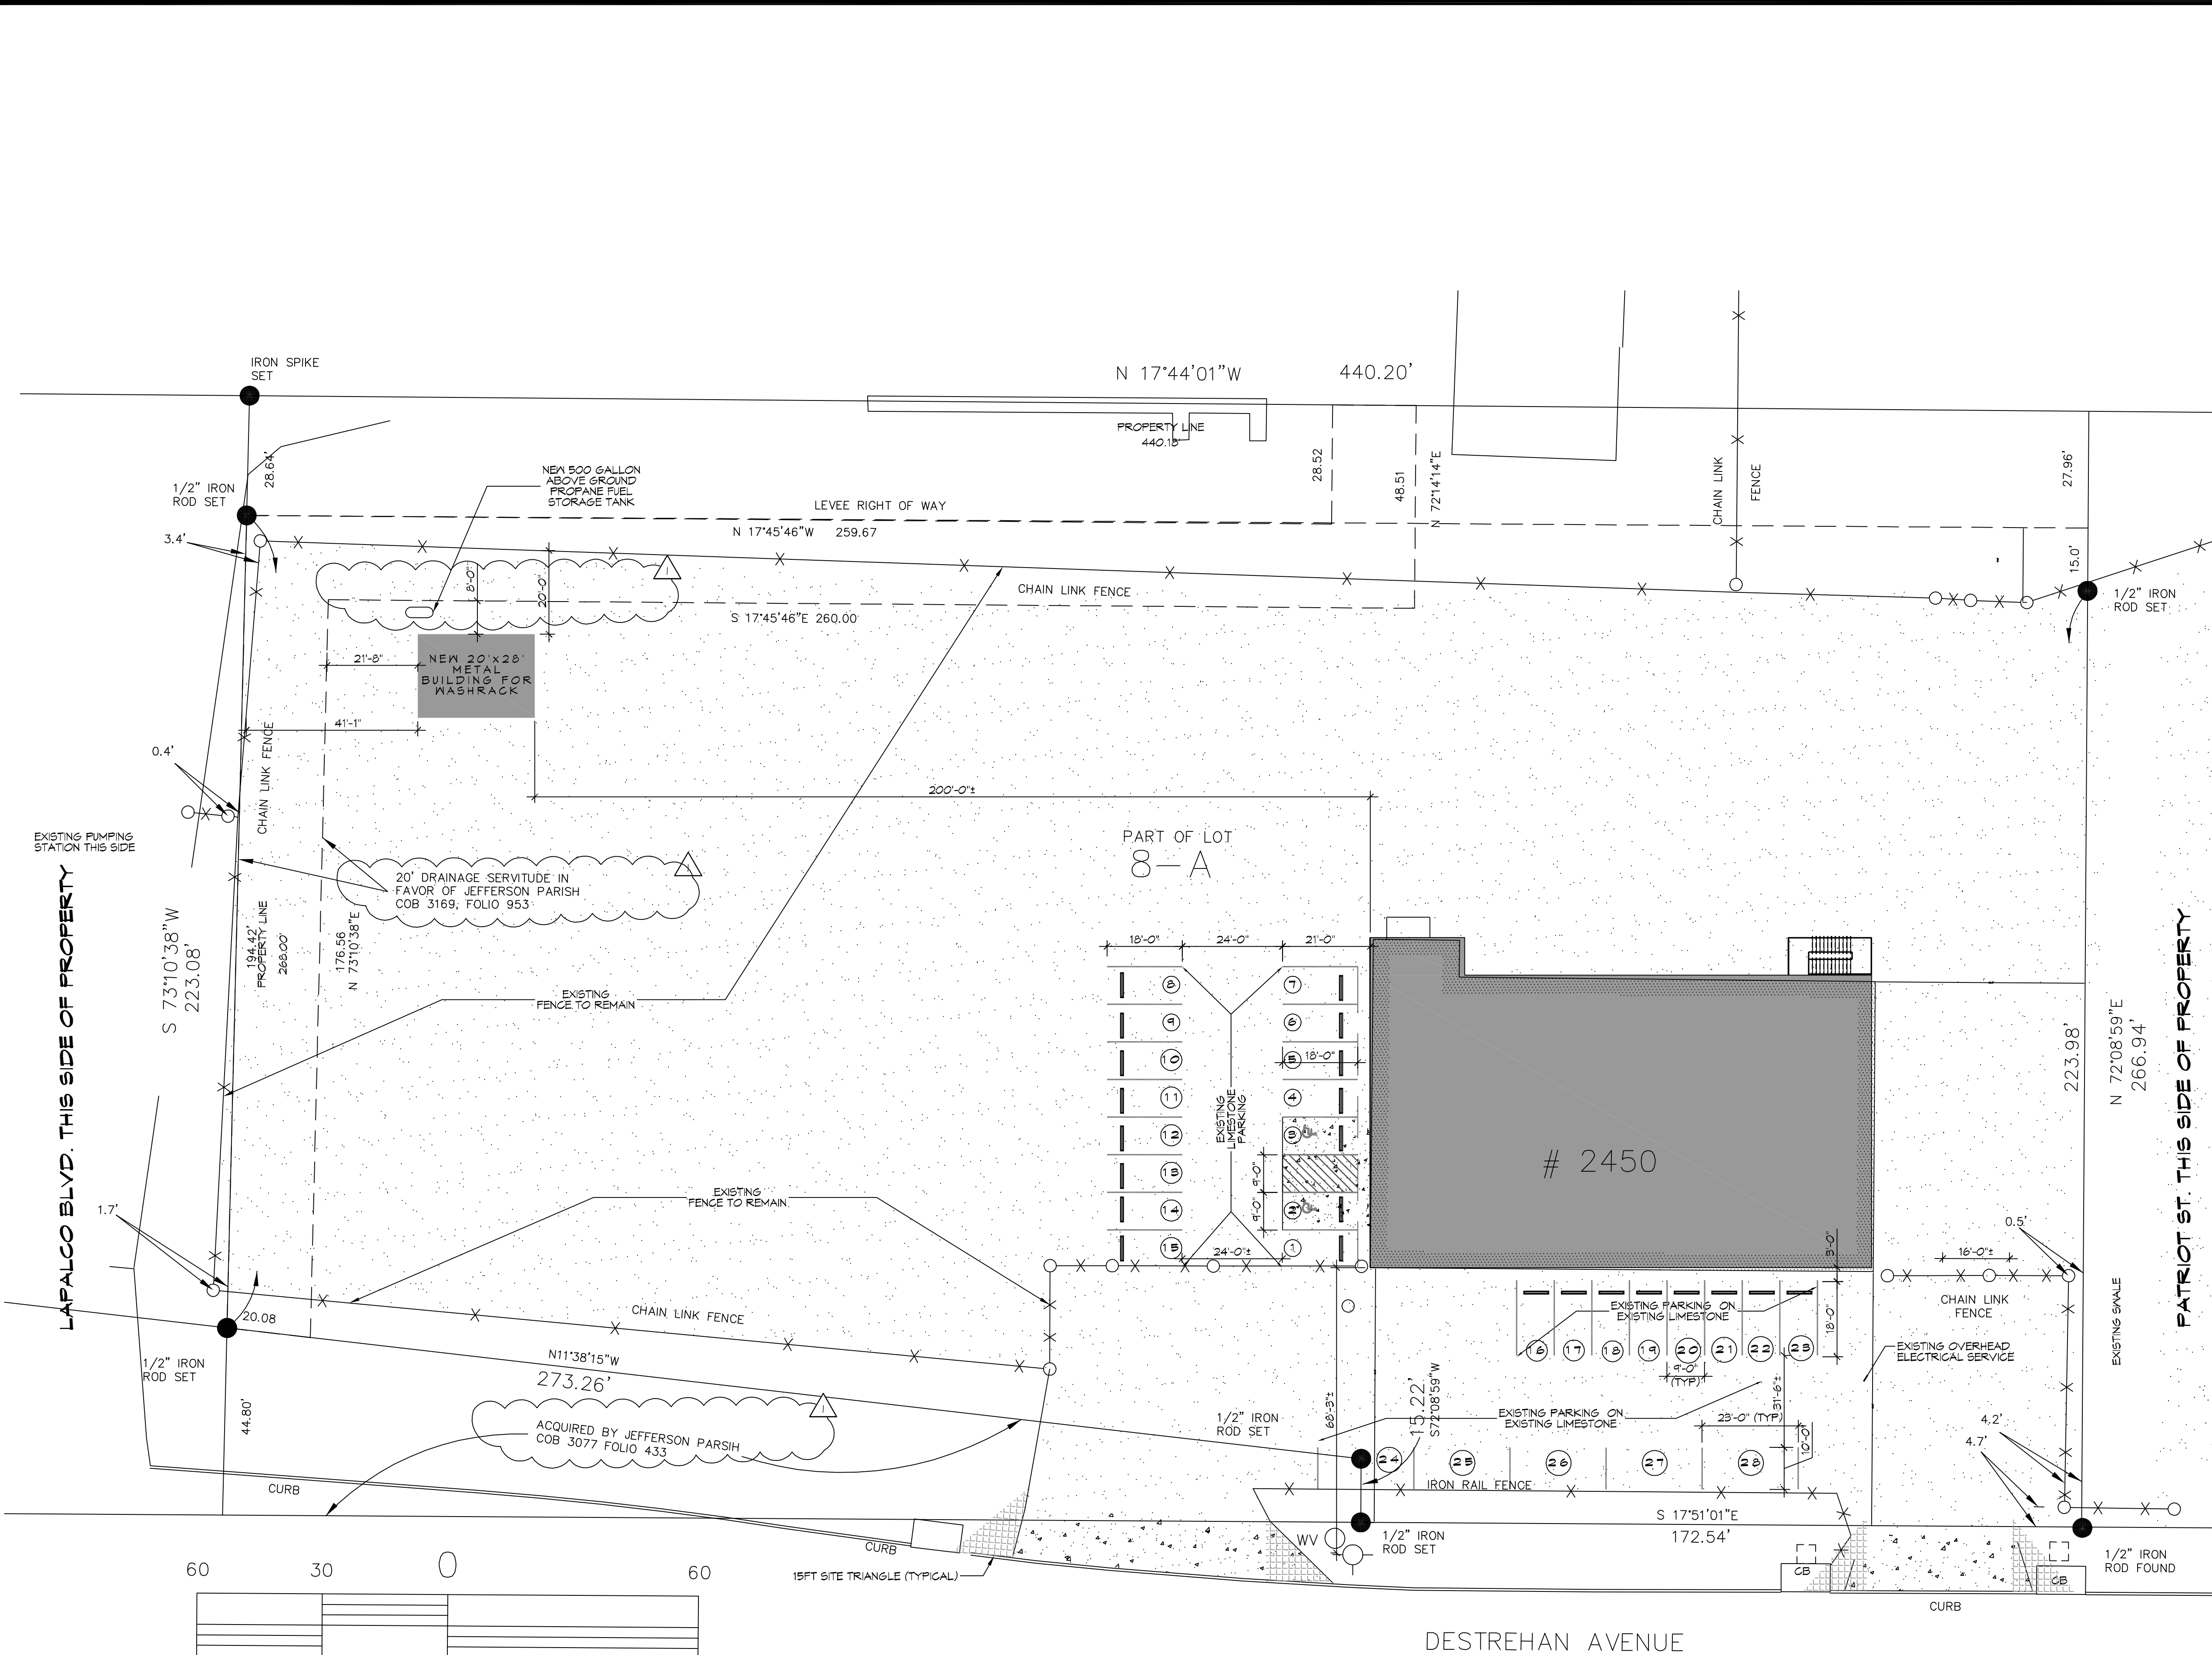

GENERAL SITE NOTES

1. ALL WORK SHALL CONFORM TO 2012 IBC CODE.

LEGEND

- EXISTING FIRE HYDRANT
- EXISTING WATER METER
- EXISTING POWER POLE
- EXISTING SANITARY SEWER LIFT STATION
- PROPERTY LINE
- FENCE
- EASEMENT

DAMMON ENGINEERING, INC.

554 Old Spanish Trail, Slidell, LA 70458 (985) 649-5832

www.dammonengineering.com
Info@dammonengineering.com
Slidell, LA 70458

Chief Engineer: Brian Misch
Slidell, LA 70458

#	DESCRIPTION	DATE
1	UPDATE PLAN WITH SERVICES	6/11/16

SEAL:

BRIAN A. MISCH
License No. 20117
6/1/2016

BLU LINE RENTALS

2450 DESTREHAN AVENUE
HARVEY, LOUISIANA 70059

JOB No: 2274 DATE: 13 APRIL 2016
DRAWN BY: DPD CHECKED BY: BAN

SHEET TITLE:
SITE PLAN

DRAWING NUMBER:
C101

SHEET No: 2 of 6

SCALE IN FEET

15FT SITE TRIANGLE (TYPICAL)

1 SITE PLAN
SCALE: 1" = 20'

SURVEY BY DUFRENE SURVEYING,
DATED 5/16/2016, UNDER
DOCUMENT T-5288-S2