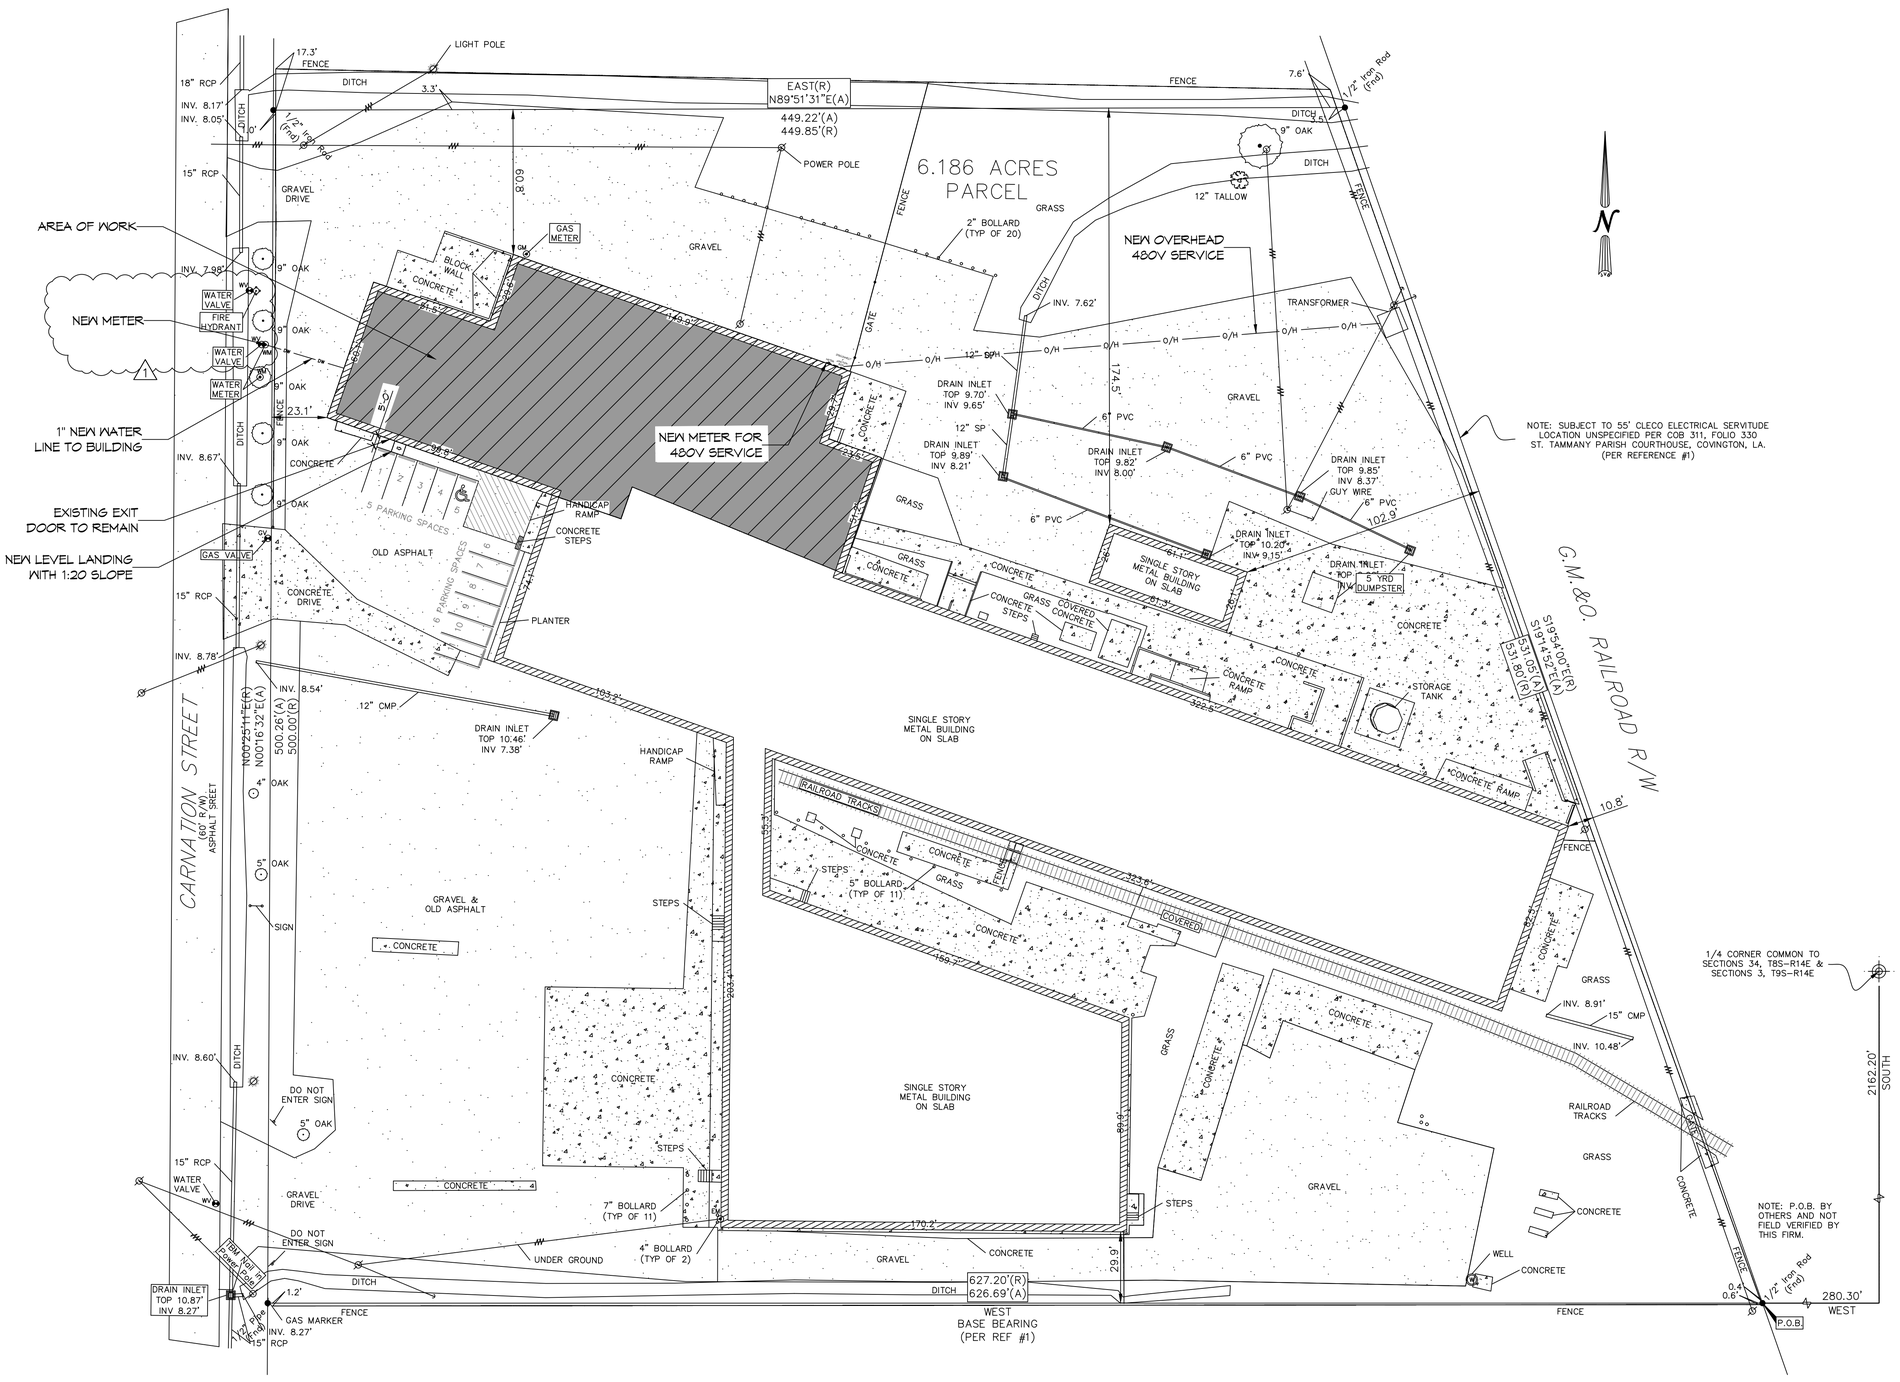

8 SITE PLAN

SCALE: 1" = 30'-0"

DAMMON ENGINEERING, INC.
554 Old Spanish Trail Slidell, LA 70458 (985) 649-5832
www.dammonengineering.com
info@dammonengineering.com
PH: 985.649.5832

Chief Engineer: Brian Mistich, PE
554 Old Spanish Trail
Slidell, LA 70458

#	DESCRIPTION	DATE
1	Added New Water Meter	5/5/2023

REVISIONS

SEAL: BRIAN A. MISTICH, License No. 30187, STATE OF LOUISIANA, PROFESSIONAL ENGINEER, 5/5/2023

OFFICE BUILD-OUT INSIDE WAREHOUSE
CARNATION PROPERTIES, L.L.C.
516 CARNATION ST
SLIDELL, LA

JOB No: 24'14 DATE: 3/28/2023
DRAWN BY: CHECKED BY:

SHEET TITLE: SITE PLAN

DRAWING NUMBER: C101

SHEET No: 4 of 8