

LEGEND	
	NEW METAL STUD AND GNB PARTITION
	EXIST METAL STUD AND GNB PARTITION TO REMAIN
	SMOKE-RATED PARTITION
	ONE-HOUR FIRE-RATED PARTITION

GENERAL NOTES

1. NEW SMOKE PARTITION SHALL EXTEND FROM FINISHED FLOOR TO THE UNDERSIDE OF ROOF ABOVE.

DAMMON
ENGINEERING, INC.

Architects & Engineers

www.dammonengineering.com
info@dammonengineering.com
554 Old Spanish Trail
Slidell, LA 70458
PH: 985.641.5932
F: 985.641.5950

#	DESCRIPTION	DATE

SEAL:

FRENCH MARKET COLLECTIONS TENANT SEPARATION

PROPERTIES, L.L.C.



646 SARANATION ST
SLIDELL, LA

JOB No: 2215 DATE: 7/9/2014
DRAWN BY: DPD CHECKED BY: KJK

SHEET TITLE:
ARCHITECTURAL FLOOR PLAN

DRAWING NUMBER:
A1

SHEET No: 3 of 3

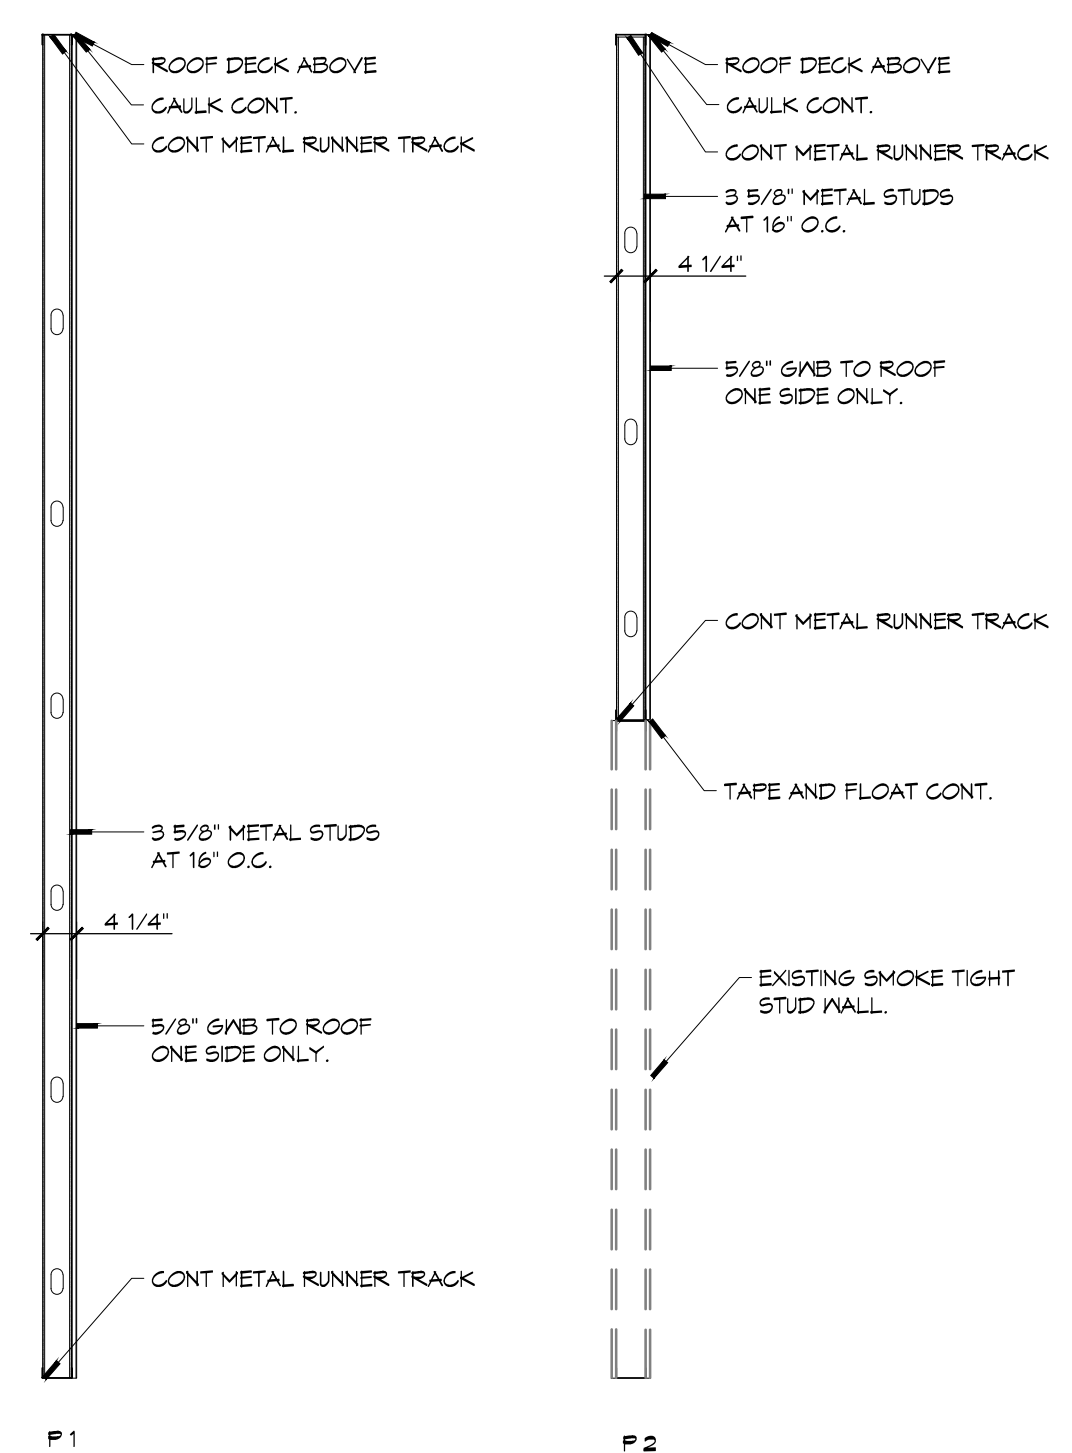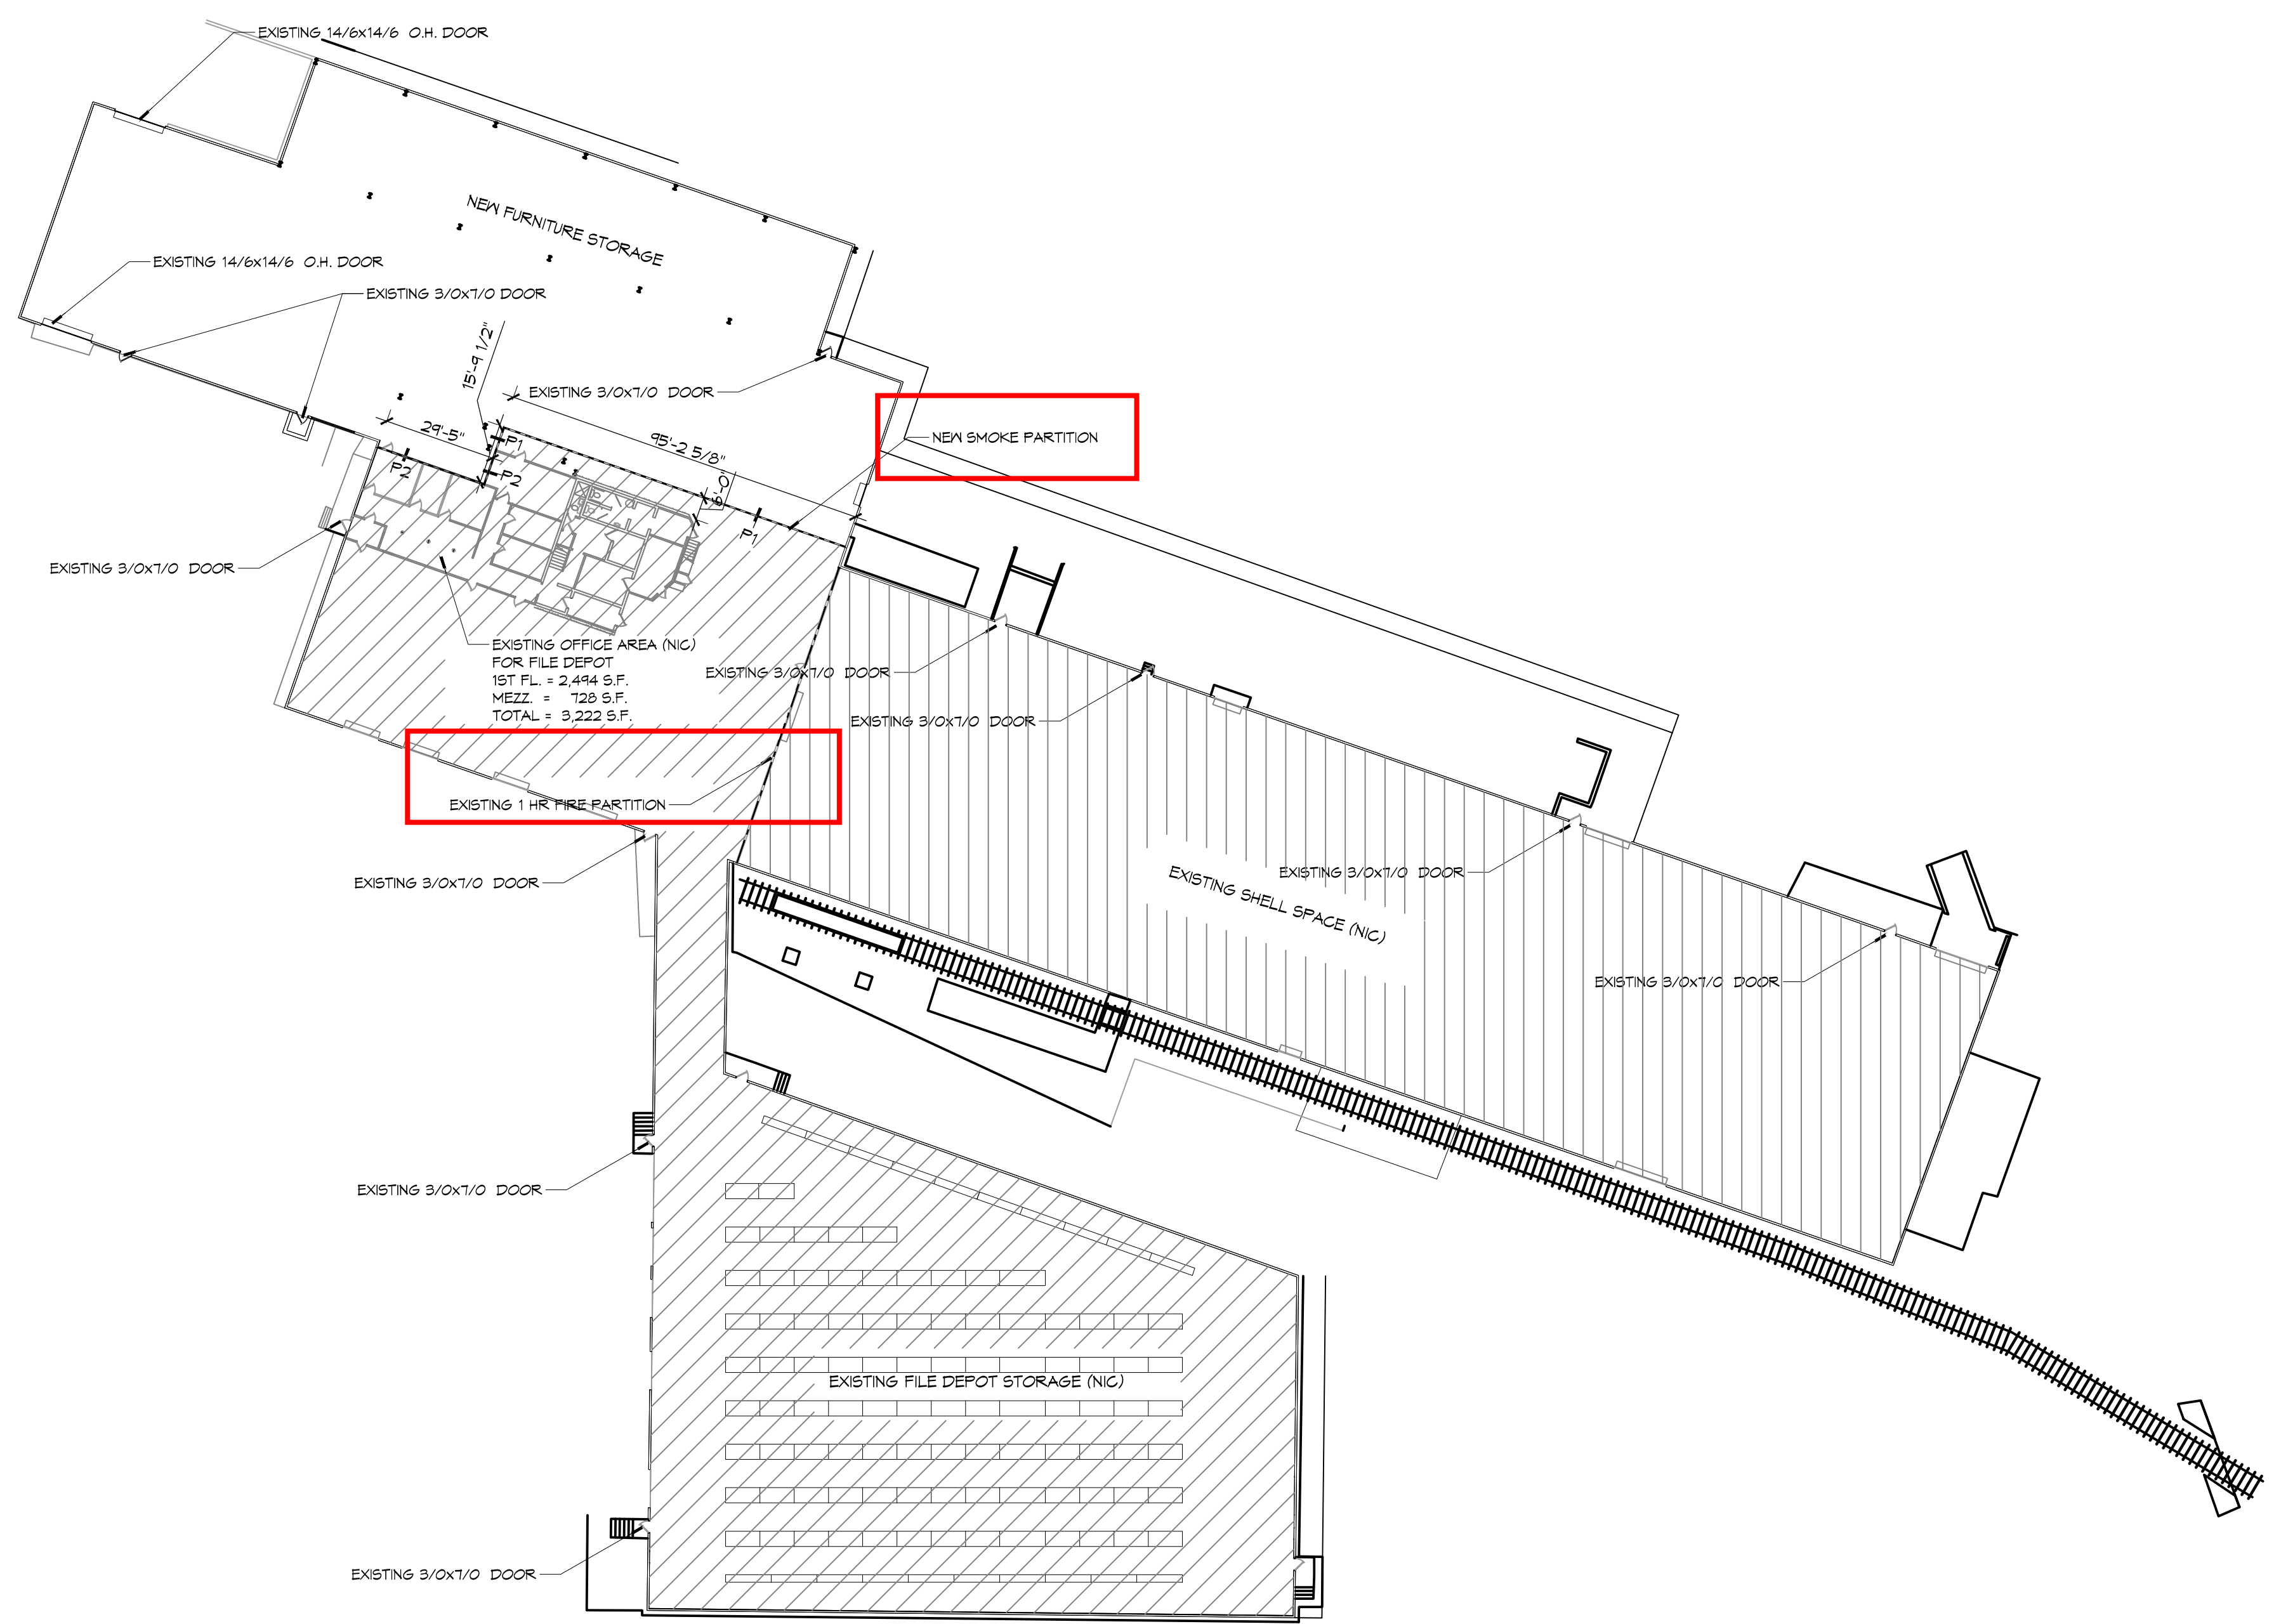

P1 & P2
- GNB SHALL EXTEND FROM THE FINISHED FLOOR TO THE UNDERSIDE OF THE ROOF DECK ABOVE.
- JOINTS MADE WITHIN OR AT THE PERIMETER OF SMOKE PARTITIONS SHALL BE PROTECTED WITH A JOINT SYSTEM THAT IS CAPABLE OF LIMITING THE TRANSFER OF SMOKE.

ARCHITECTURAL FLOOR PLAN
SCALE: 1/32" = 1'-0"