



RIGHT SIDE ELEVATION

SCALE: 3/16" = 1'-0"

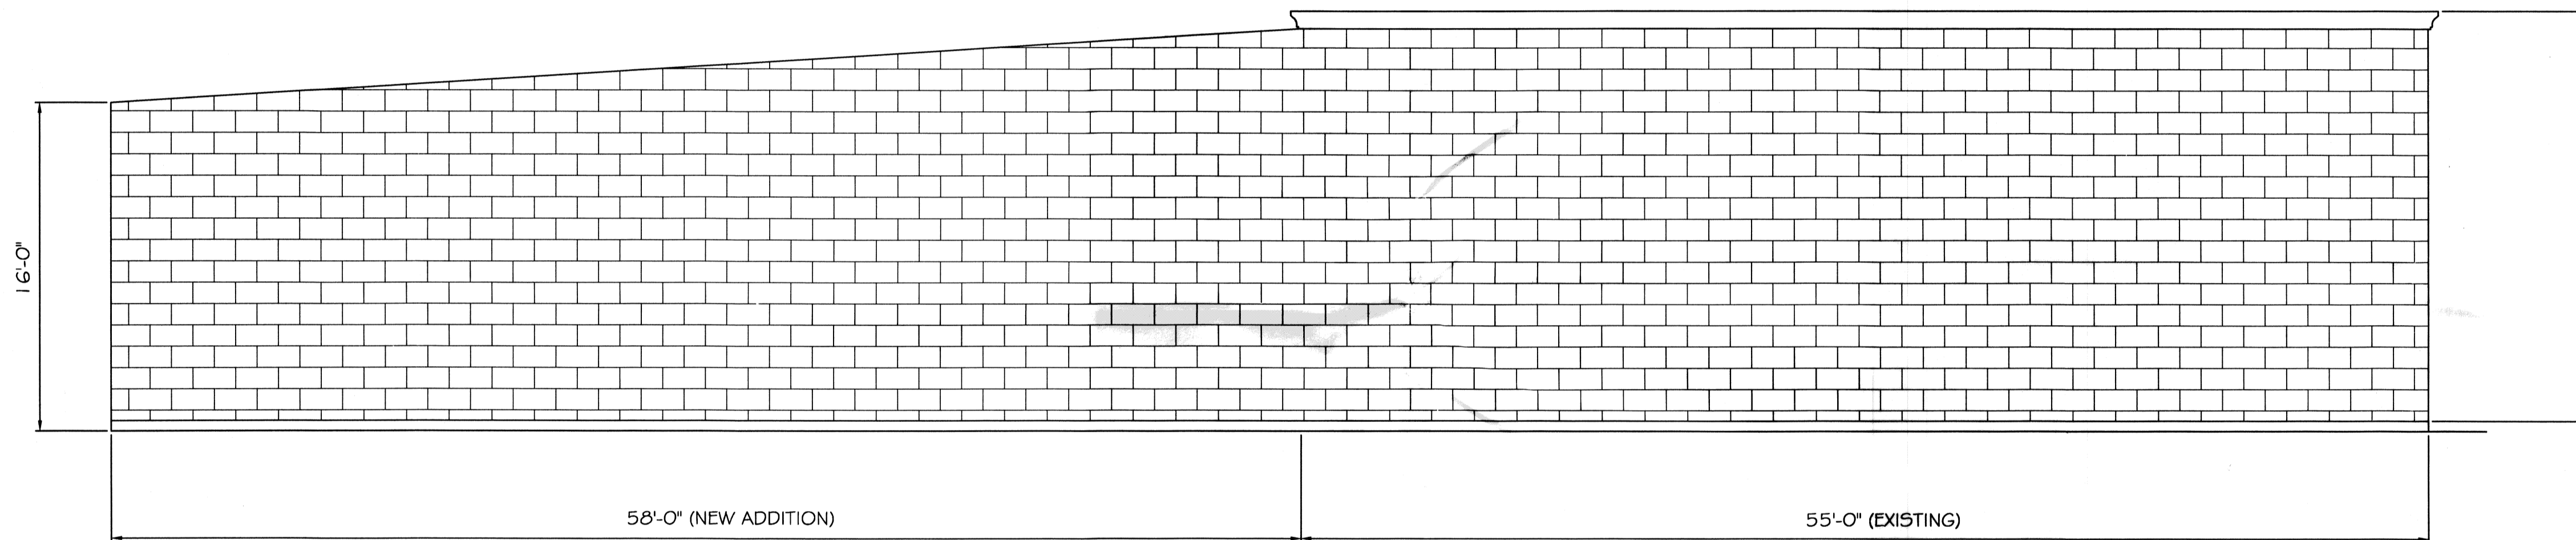


REAR SIDE ELEVATION

SCALE: 3/16" = 1'-0"

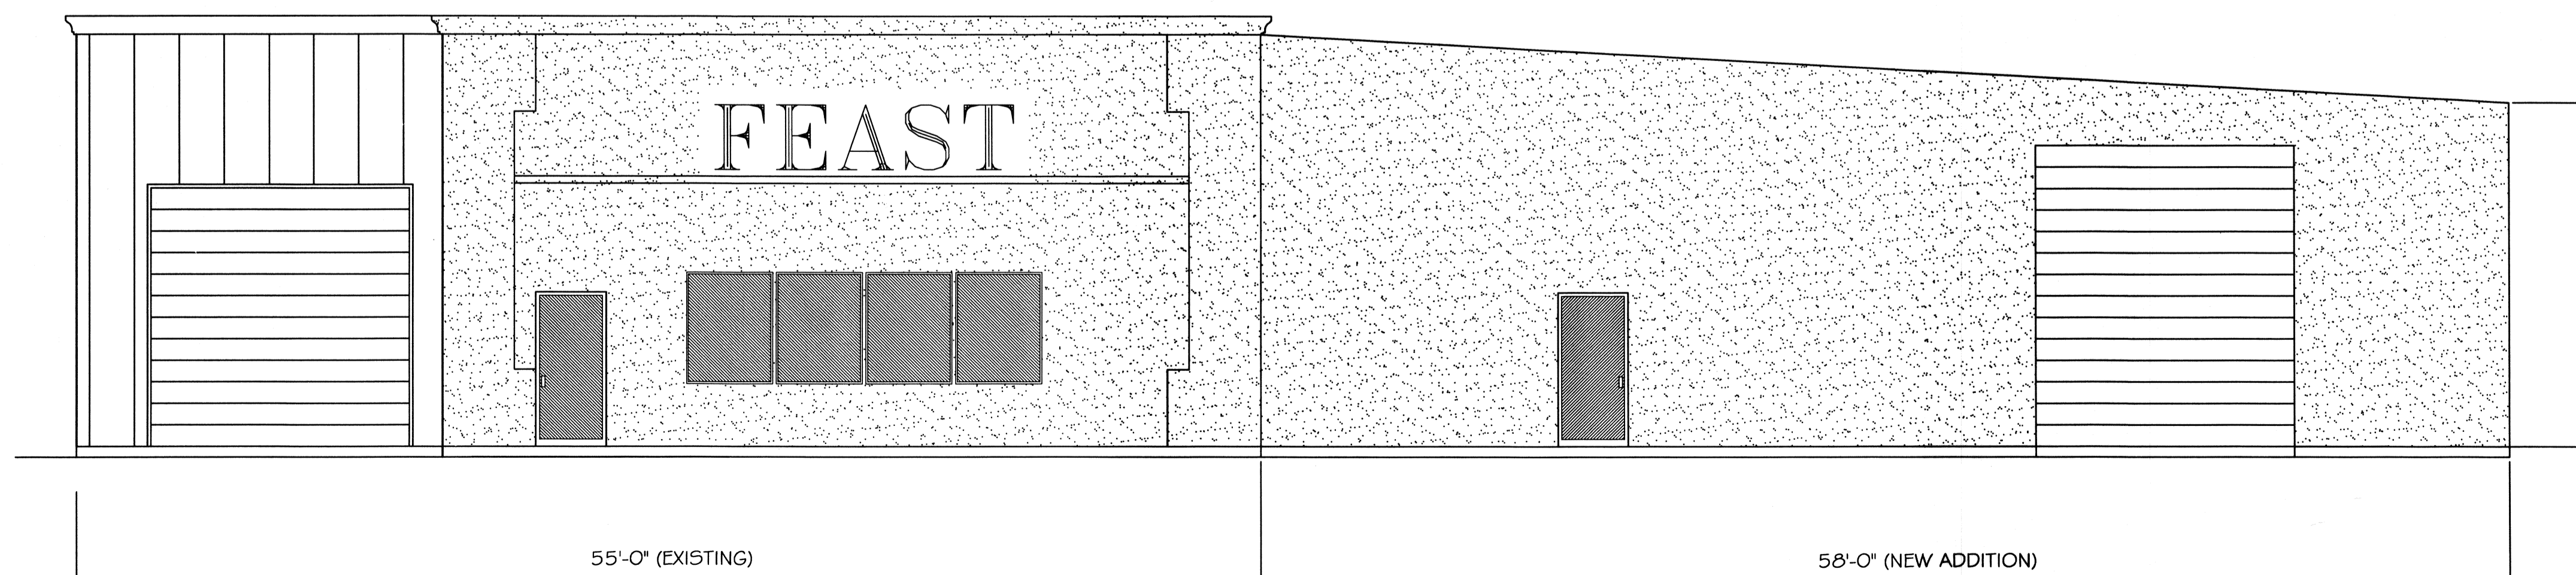

FRONT SIDE ELEVATION

SCALE: 3/16" = 1'-0"

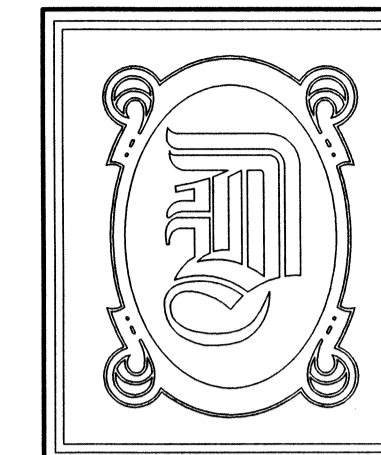

**DAMMON
ENGINEERING, INC.**

CHIEF ENGINEER
EMMETT
DAMMON, P.E.

CHIEF ARCHITECT
ROBERT
WILTSE

554 OLD SPANISH TRAIL
SLIDELL, LA. 70458
OFFICE: 985-649-5832
FAX: 985-641-5950

WEBSITE:
WWW.DAMMONENGINEERING.COM

EMAIL:
DAMMONENG@BELLSOUTH.NET

ARCHITECTURE

ENGINEERING

STUDIES

PLANNING

INVESTIGATION

EXPERT WITNESS

**NEW
ADDITION**

FEAST CATERING
109 TAO5 ST
SLIDELL
LA

**BUILDING
ELEVATIONS**

Robert Wiltse

4 1 4 7 5 7
REVIEWED FOR
STATE FIRE MARSHAL
AS PER REVIEW LETTER
BY: WILLIAM D. JONES, ARCHITECT, CBO
William D. Jones

REV:

SCALE: AS NOTED

JOB#: 2140

DATE: 04-20-12

SHEET

A-3

OF