LEGEND

- $ – SWITCH
- 3$ – THREE-WAY SWITCH
- – DUPLEX OUTLET
- GFI – GFI OUTLET
- WP GFI – WEATHERPROOF OUTLET
- – OVEN OUTLET
- – LIGHT
- F11 – VENT/LIGHT
- F1 – 2 X 2 FLUORSCENT LIGHT
- F9 – RECESSED CAN LIGHT
- EX EXIT – ILLUM. EXIT SIGN – CLG. MOUNTED W/ 90 MIN. BACKUP
- – PULL CHAIN LIGHT IN ATTIC
- – INCANDESCENT CHANDELIER
- – TELEPHONE/COMPUTER/CABLE TV
- – POWER PANEL
- SD – SMOKE DETECTOR–U.L. #285 WIRED TO 110V. CIRCUIT
- T – THERMOSTAT
- J – JUNCTION BOX
- – DISCONNECT SWITCH
- WH – HOT WATER HEATER WITH DISCONNECT SWITCH
- EM – EMERGENCY LIGHT W/ 90 MIN BATTERY BACKUP
- F5 – WALL MTD. FLUORESCENT FIXTURE
- F8 – 250V HPS HIGH BAY LIGHT
- F10 – EXTERIOR LIGHT W/ 90 MINUTE BATTERY BACKUP
- F7 – EXTERIOR LIGHT

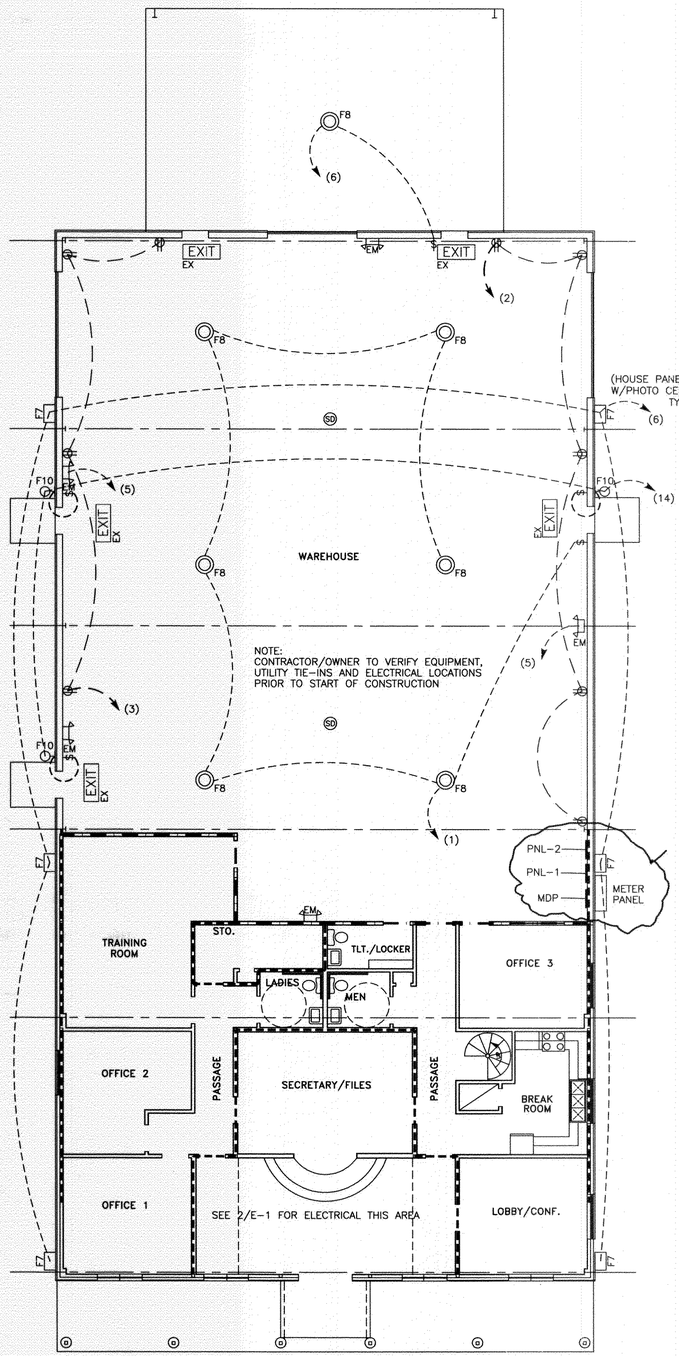

1 E–1 **OVERALL FIRST FLOOR ELECTRICAL PLAN**
1/8"=1'–0"

NOTE: CONTRACTOR/OWNER TO VERIFY EQUIPMENT, UTILITY TIE–INS AND ELECTRICAL LOCATIONS PRIOR TO START OF CONSTRUCTION

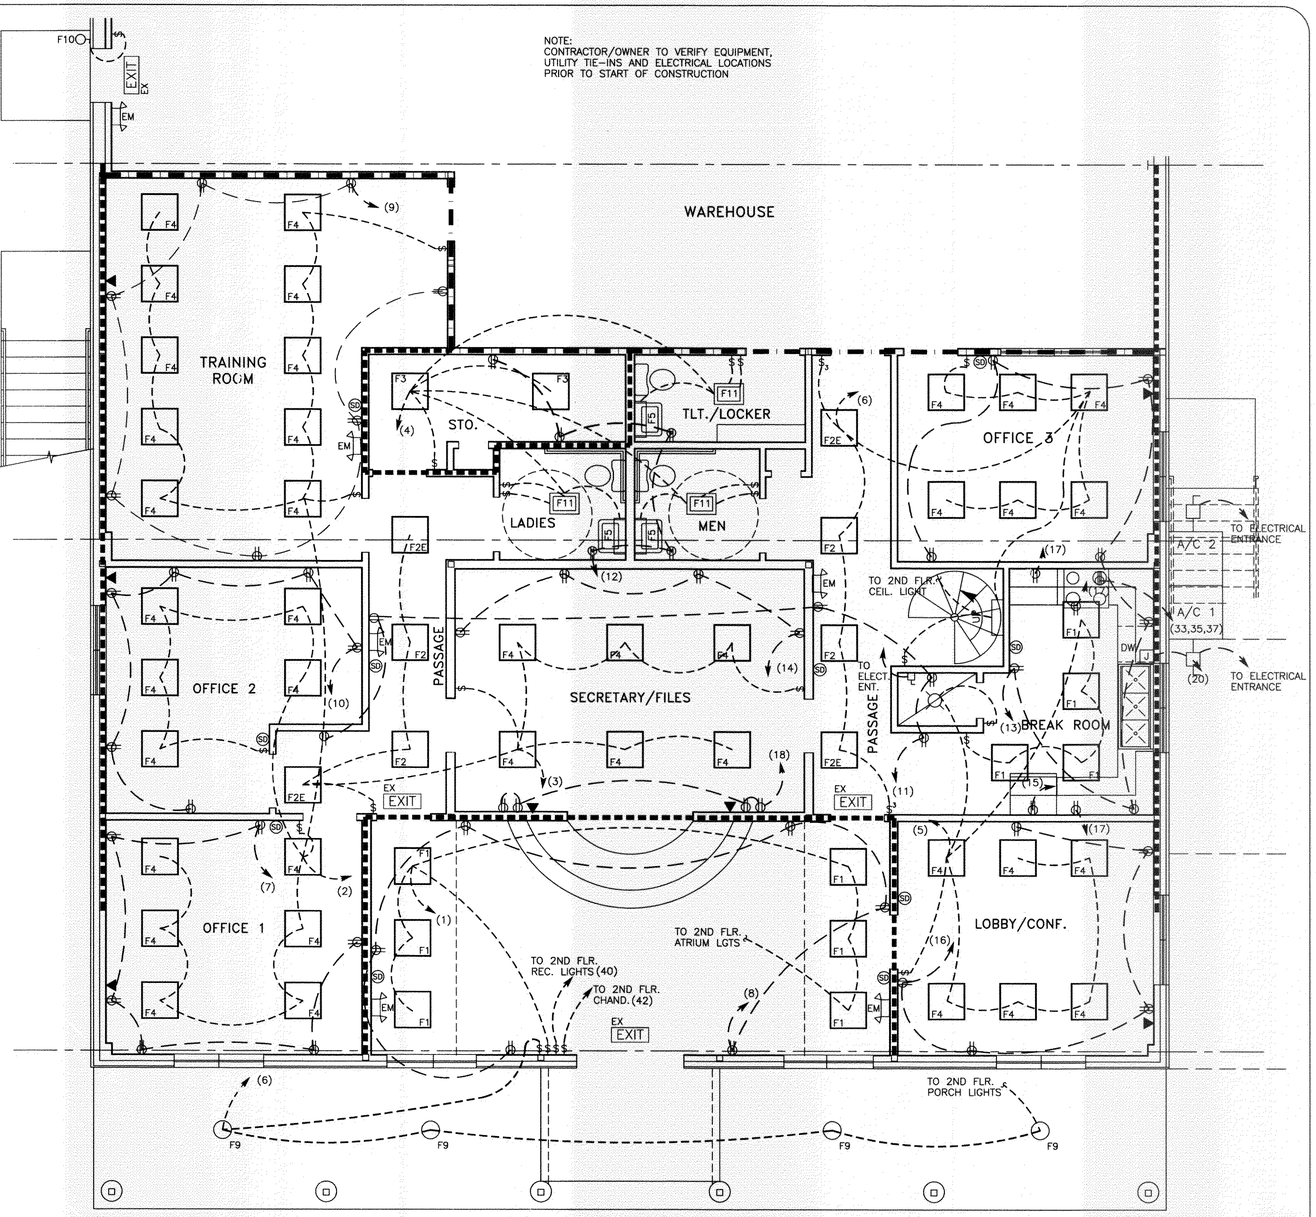

2 E–1 **ENLARGED OFFICE PLAN-FIRST FLOOR ELECTRICAL PLAN**
1/4"=1'–0"

LIGHTING FIXTURE SCHEDULE

TYPE	MFR.	CATALOG NUMBER	MOUNTING	LAMP TYPE
F1	AMER. FLUOR.	CW432RC	SURFACE	F32T8
F2	COOPER	2G220A–LTS–102–GL–U	RECESSED	T12
F2E	COOPER	2G220A–LTS–102–GLE–U	RECESSED	T12
F3	COOPER	W420A–LTS–120–LE3	SURFACE	F40CW/RS/WM
F4	COOPER	2G420A–LTS–120–GL	SURFACE	T12
F5	LITHONIA	WC 2 17 120 GEB10IS	SURFACE	1–FO17/35K
F6	LITHONIA	LF6 2/18DTT MVOLT GEB10/F6O2A TRW	RECESSED	2–PL 18/32K
F7	LITHONIA	TWP 175M TB LPI	SURFACE	1–175WMH
F8	LITHONIA	THC 400MP A15 TB	PENDANT	MP400U
F9				
F10				
F11				
EM	EELP	EM1	SURFACE	2–5.4W
EX	EELP	XE 1 R W EM	SURFACE	LED

REVISED 01–30–08
ADDED PNL

1ST FLR. ELECTRICAL PLAN

PYTHON CONSTRUCTION
TRACT 361 OF N. OAKLAWN
ST. TAMMANY PARISH, LA

OFFICE/WAREHOUSE

DAMMON ENGINEERING, INC.
1095 FLORIDA AVENUE 985–649–5832 SLIDELL, LA. 70458
DAMMONENGINEERING.COM

SCALE:AS NOTED
FILE:
JOB NO. 1595
DATE:03–08–05
SHEET 15
E–1
OF 21