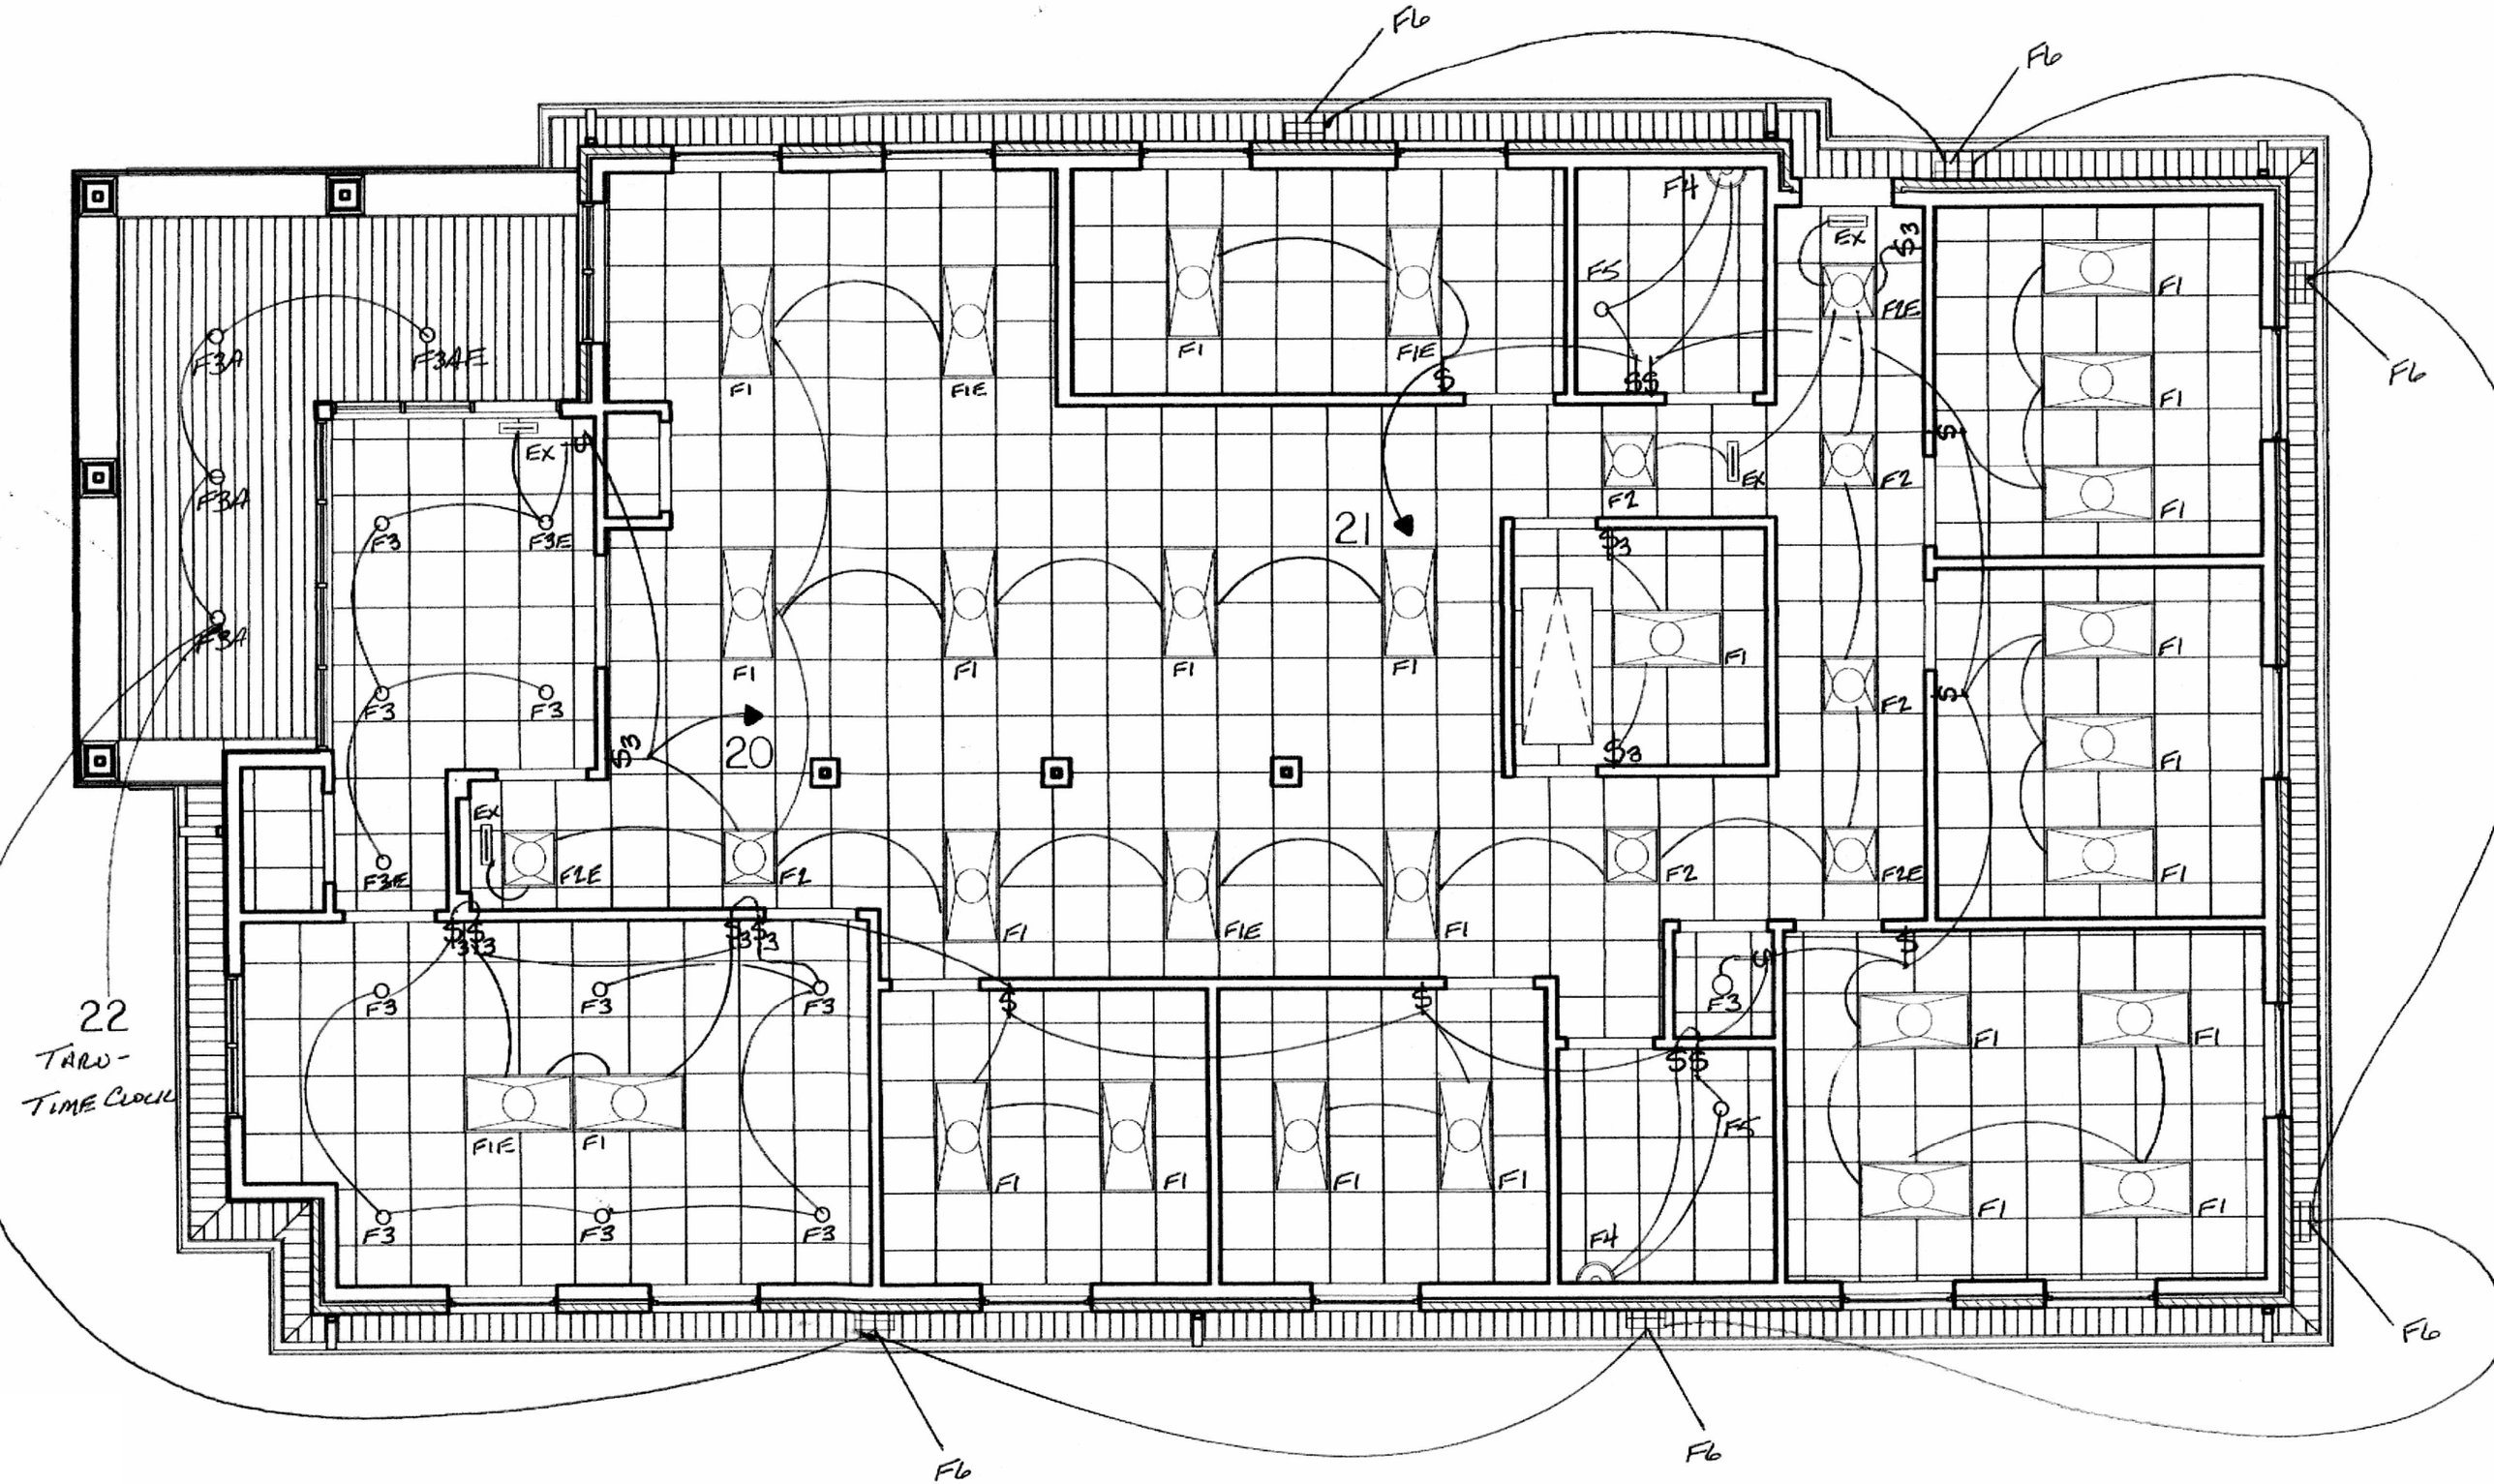
F6
F6
F6
F6
F6
F6
F1
F1E
F2
F2E
F3
F3E
F3A
F3AE
F4
F5
EX
$
$3
$4
$8
20
21
22
TARU-
TIME CLOCK