


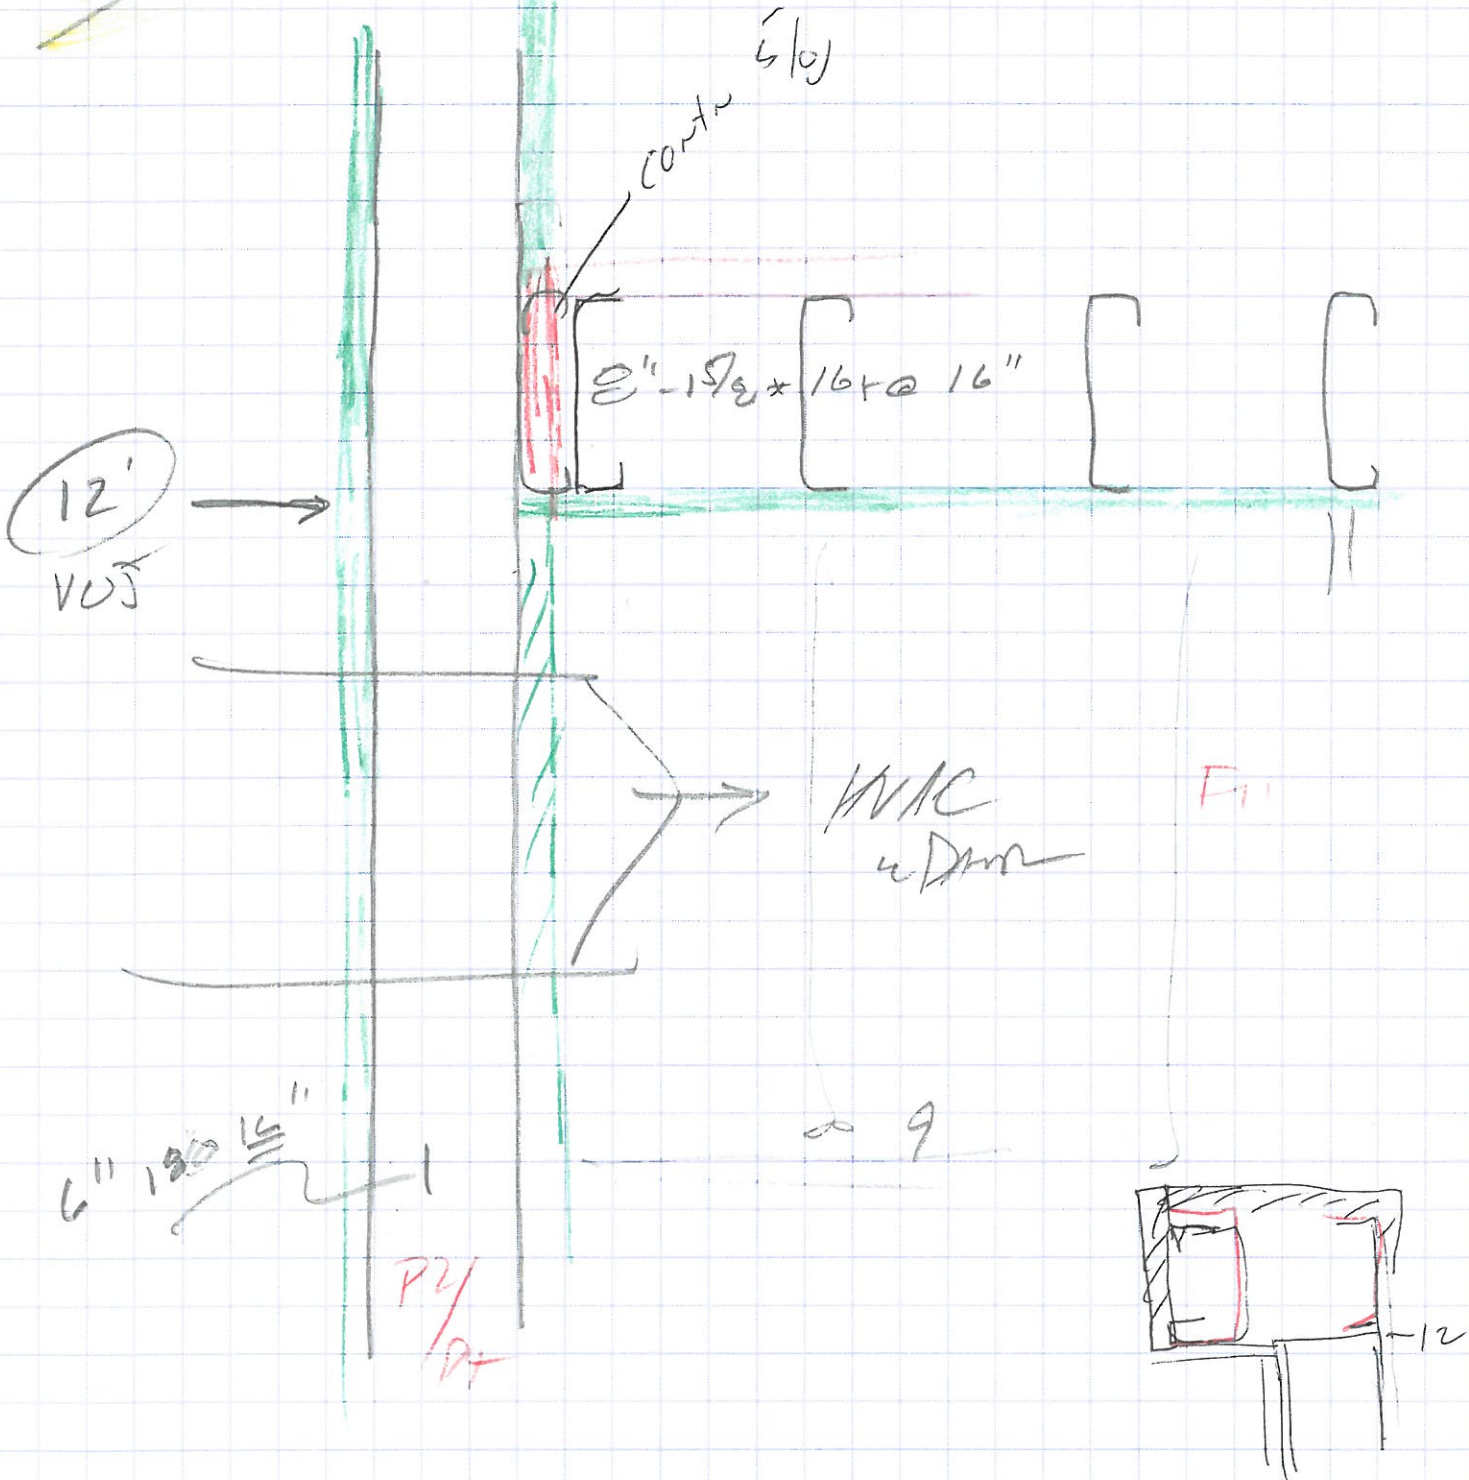

E1 @ FILE ROOM

Draw 10
20







P-

SIP Hem
Fly 10A office Down

10

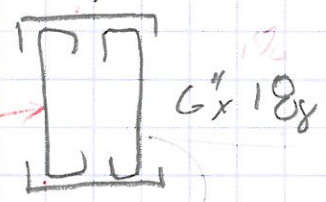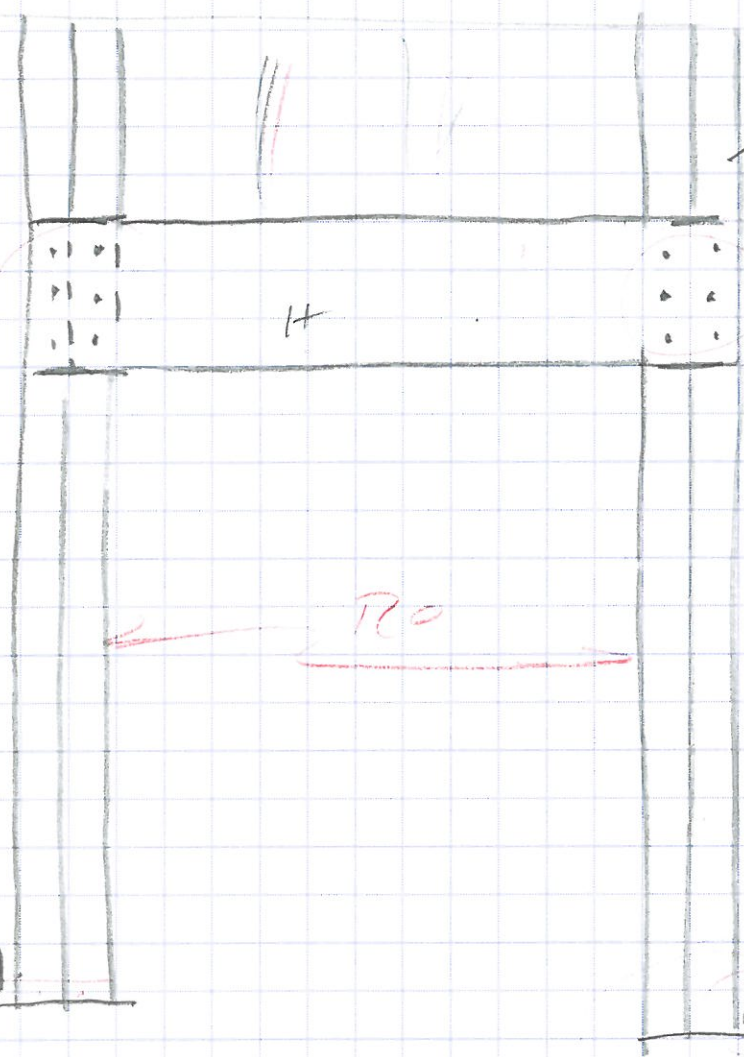

EXTEND
WEB
2 JOINT




clip max
OM



End used

SIDES ONLY


PCAR

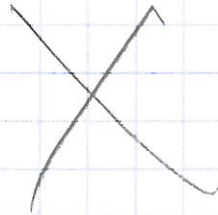

off

2 1/2 stud 205 @ 14

BRACE TO wind

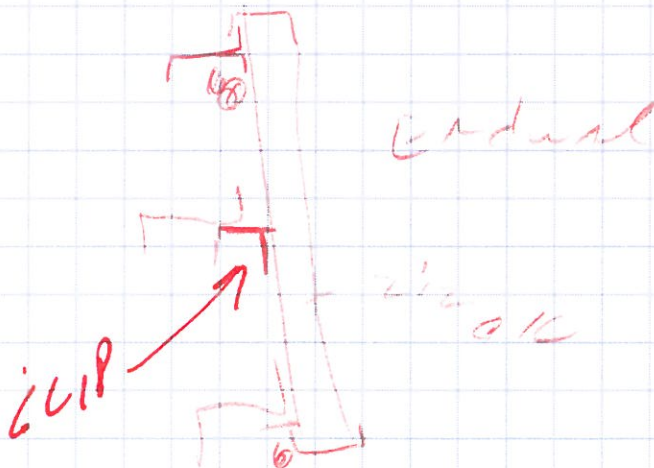



Acadian
Structural
Solutions, Inc.

42


Project Name _____

Sheet # _____ of _____


Calculated/Checked by _____

Scale _____ Date _____

Project # _____

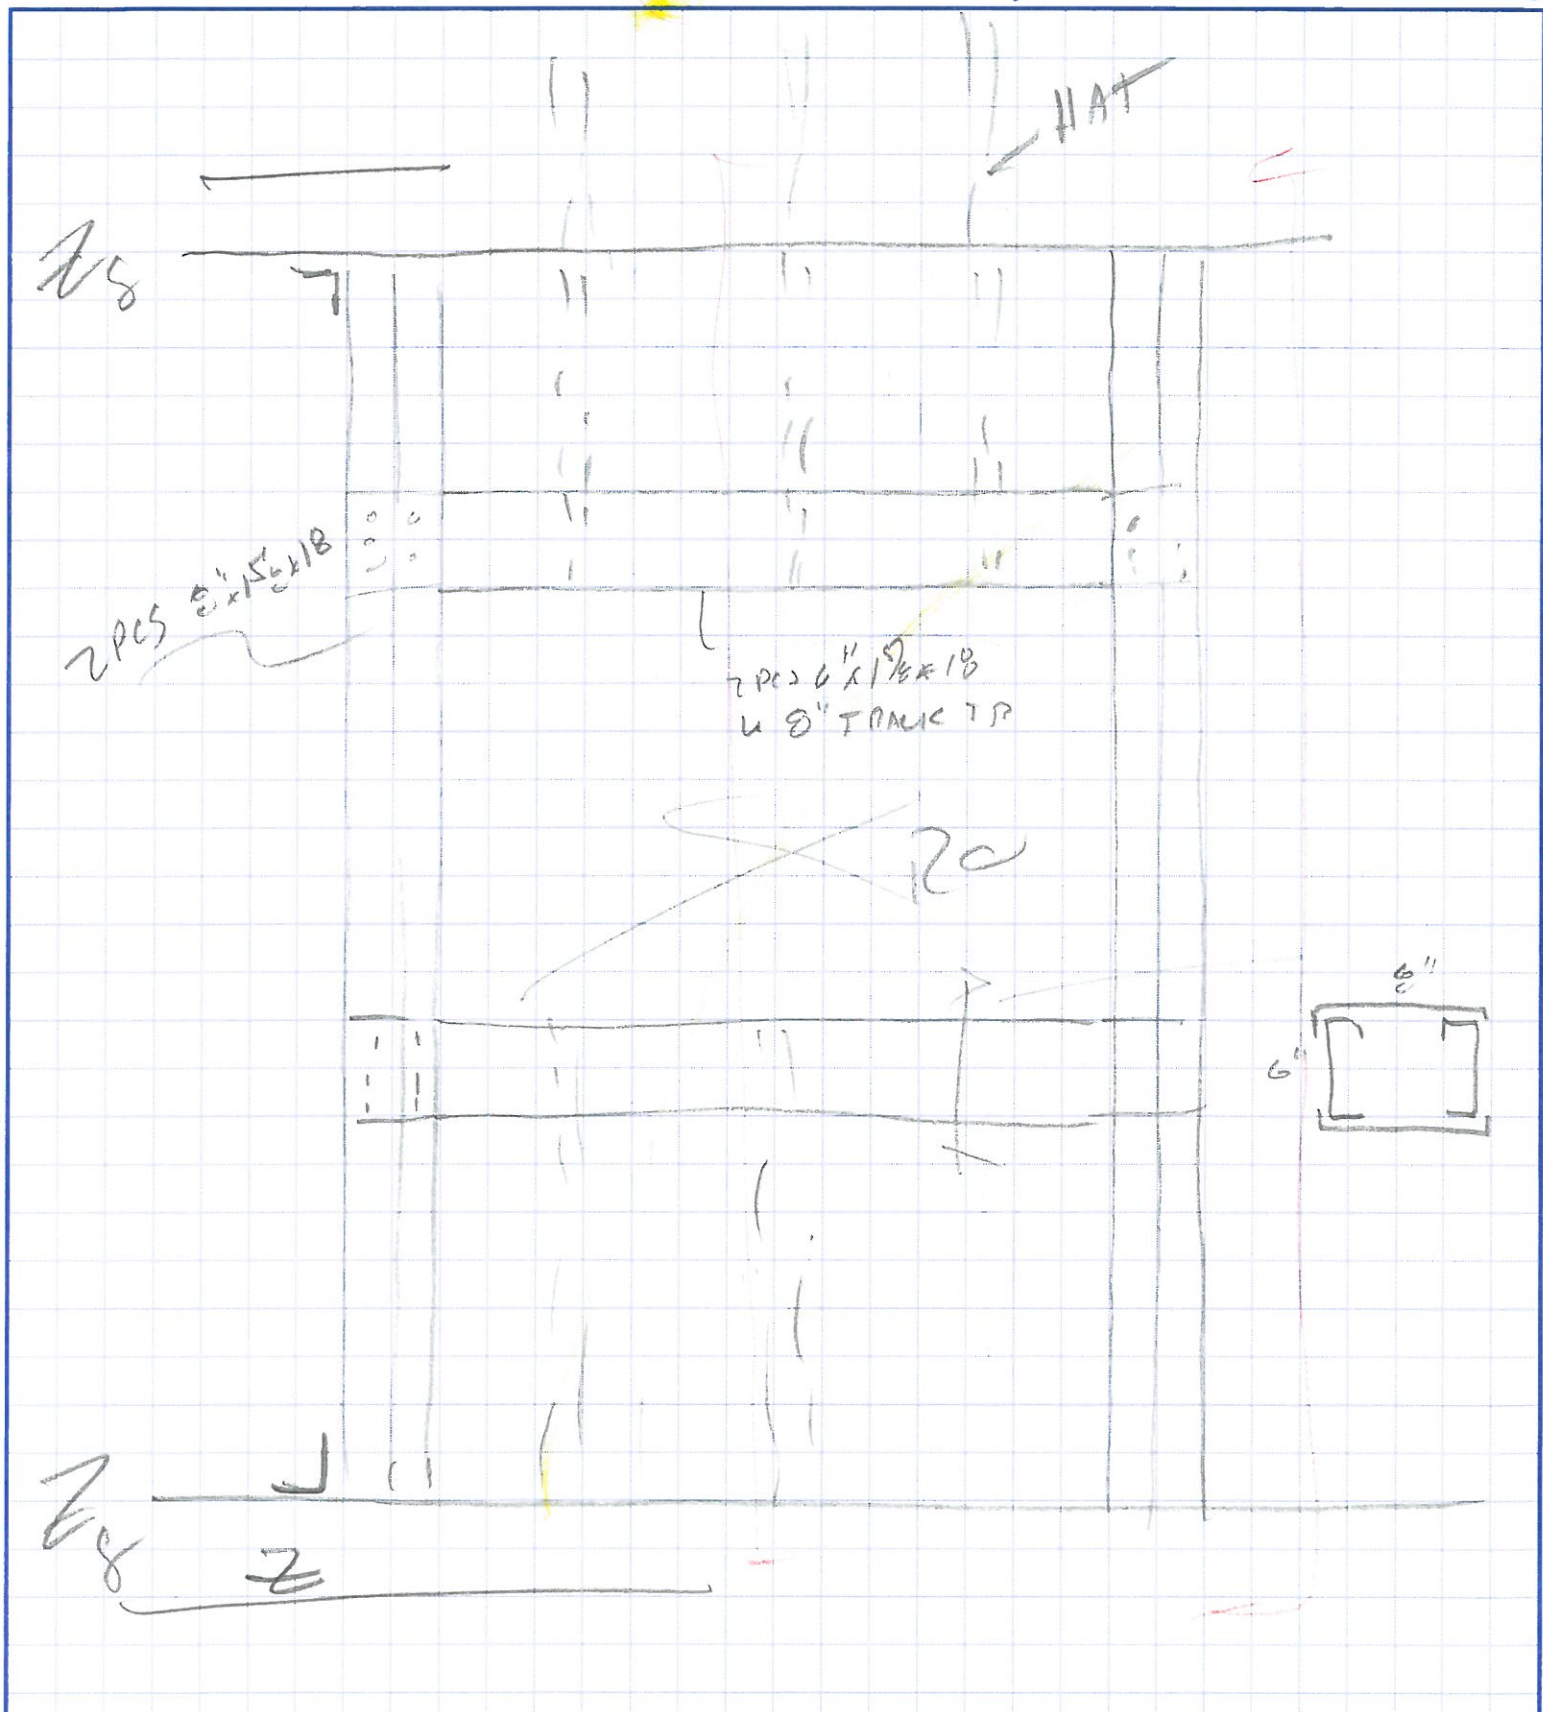

Typical EXT SIDE

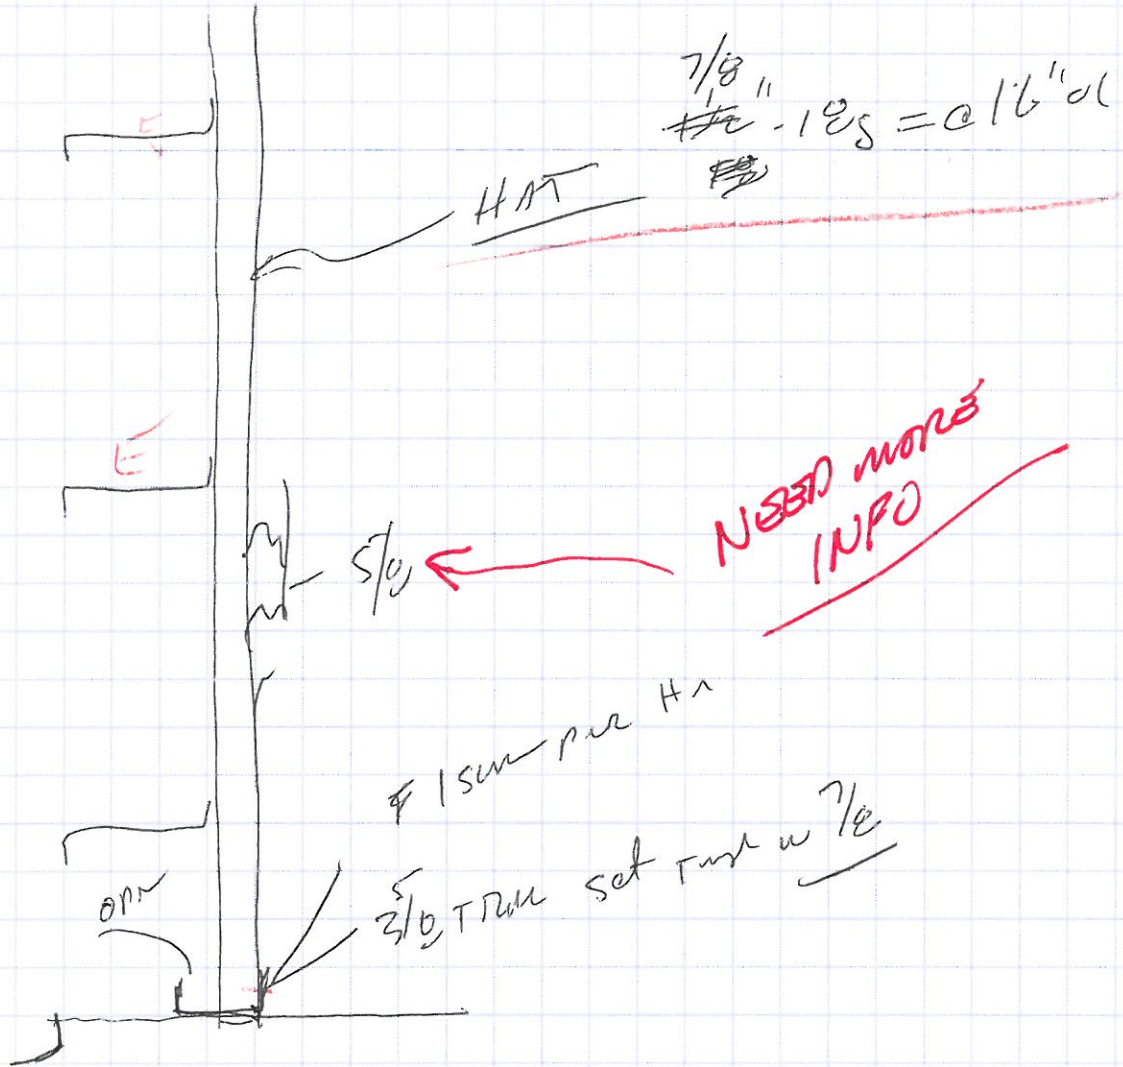


~~Typical~~ Typical Exten

SIDE

FRONT & REAR






Additional

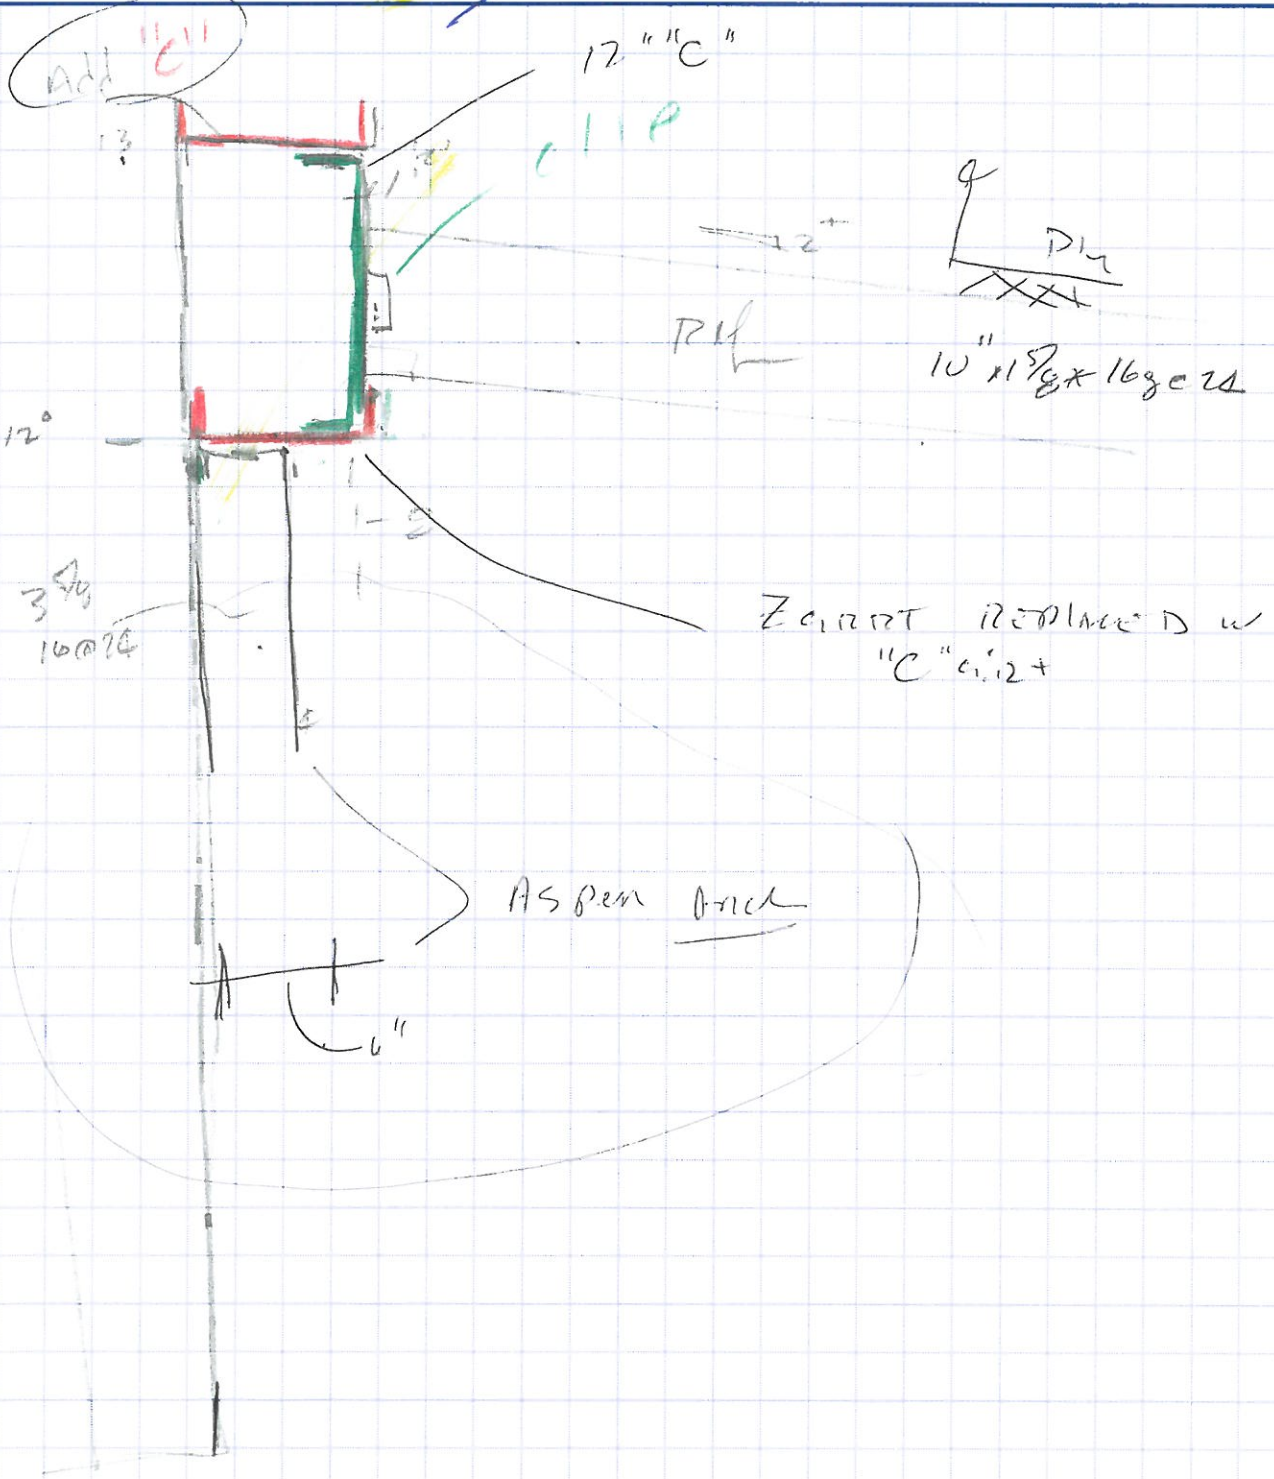



Mid 6" @ 16" 18g

TRUNK IN
DOWN

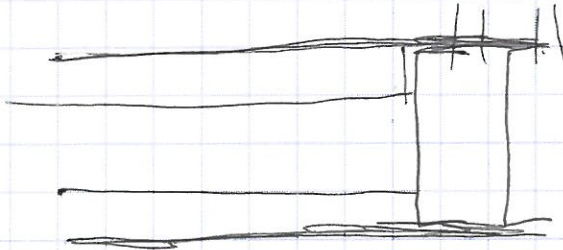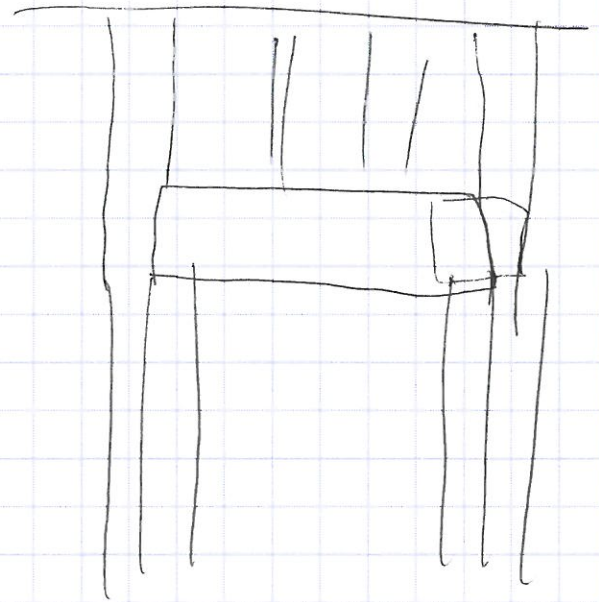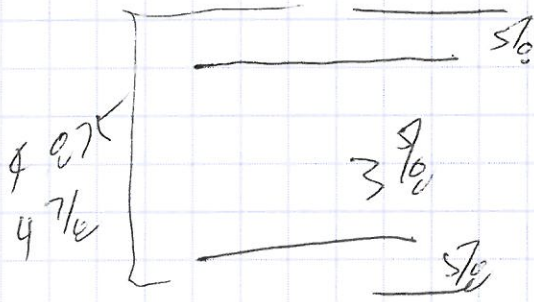

2 PCS 8" x 1 5/8" x 18g

3/5/8 TRUNK





SPRINK

116A DOOR

F

IN FILE ROOM

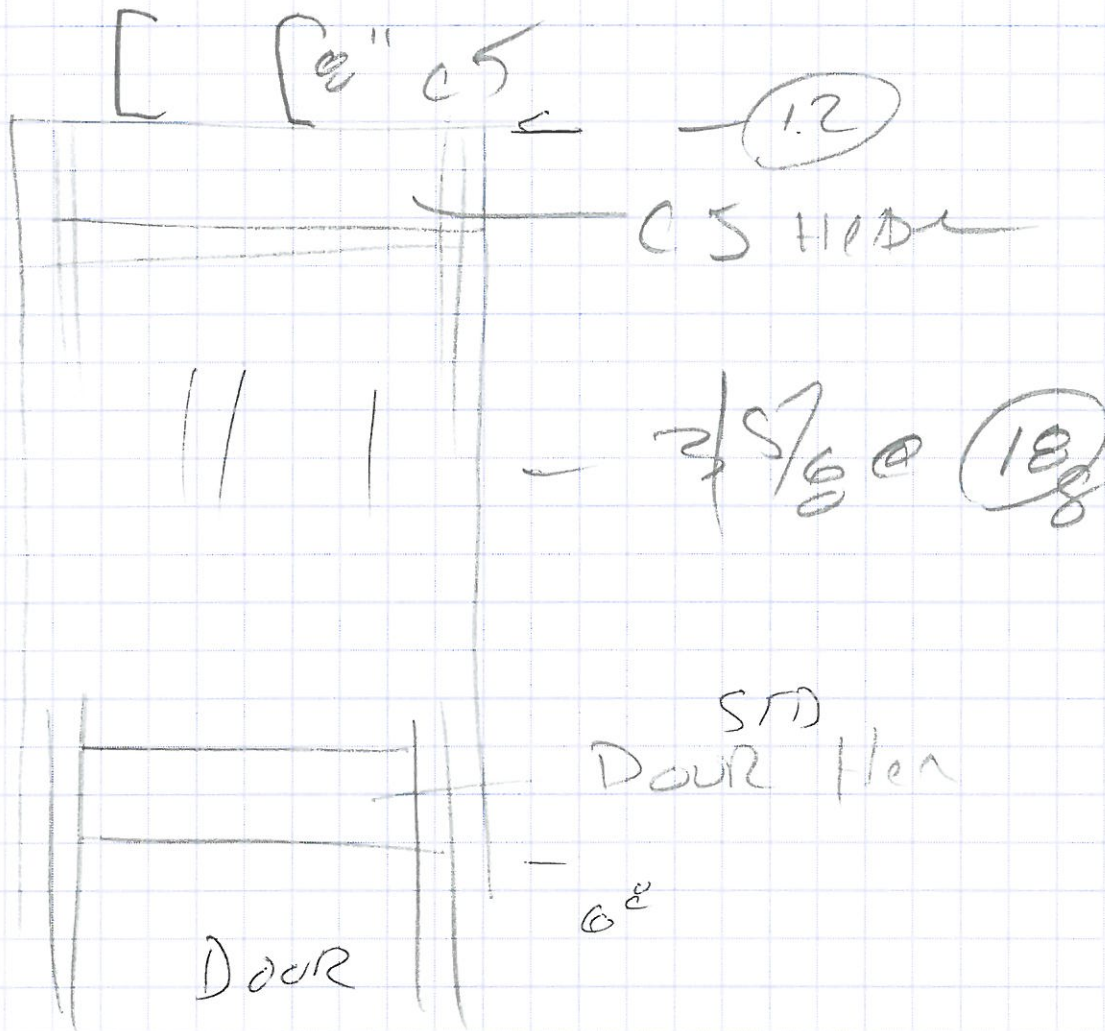


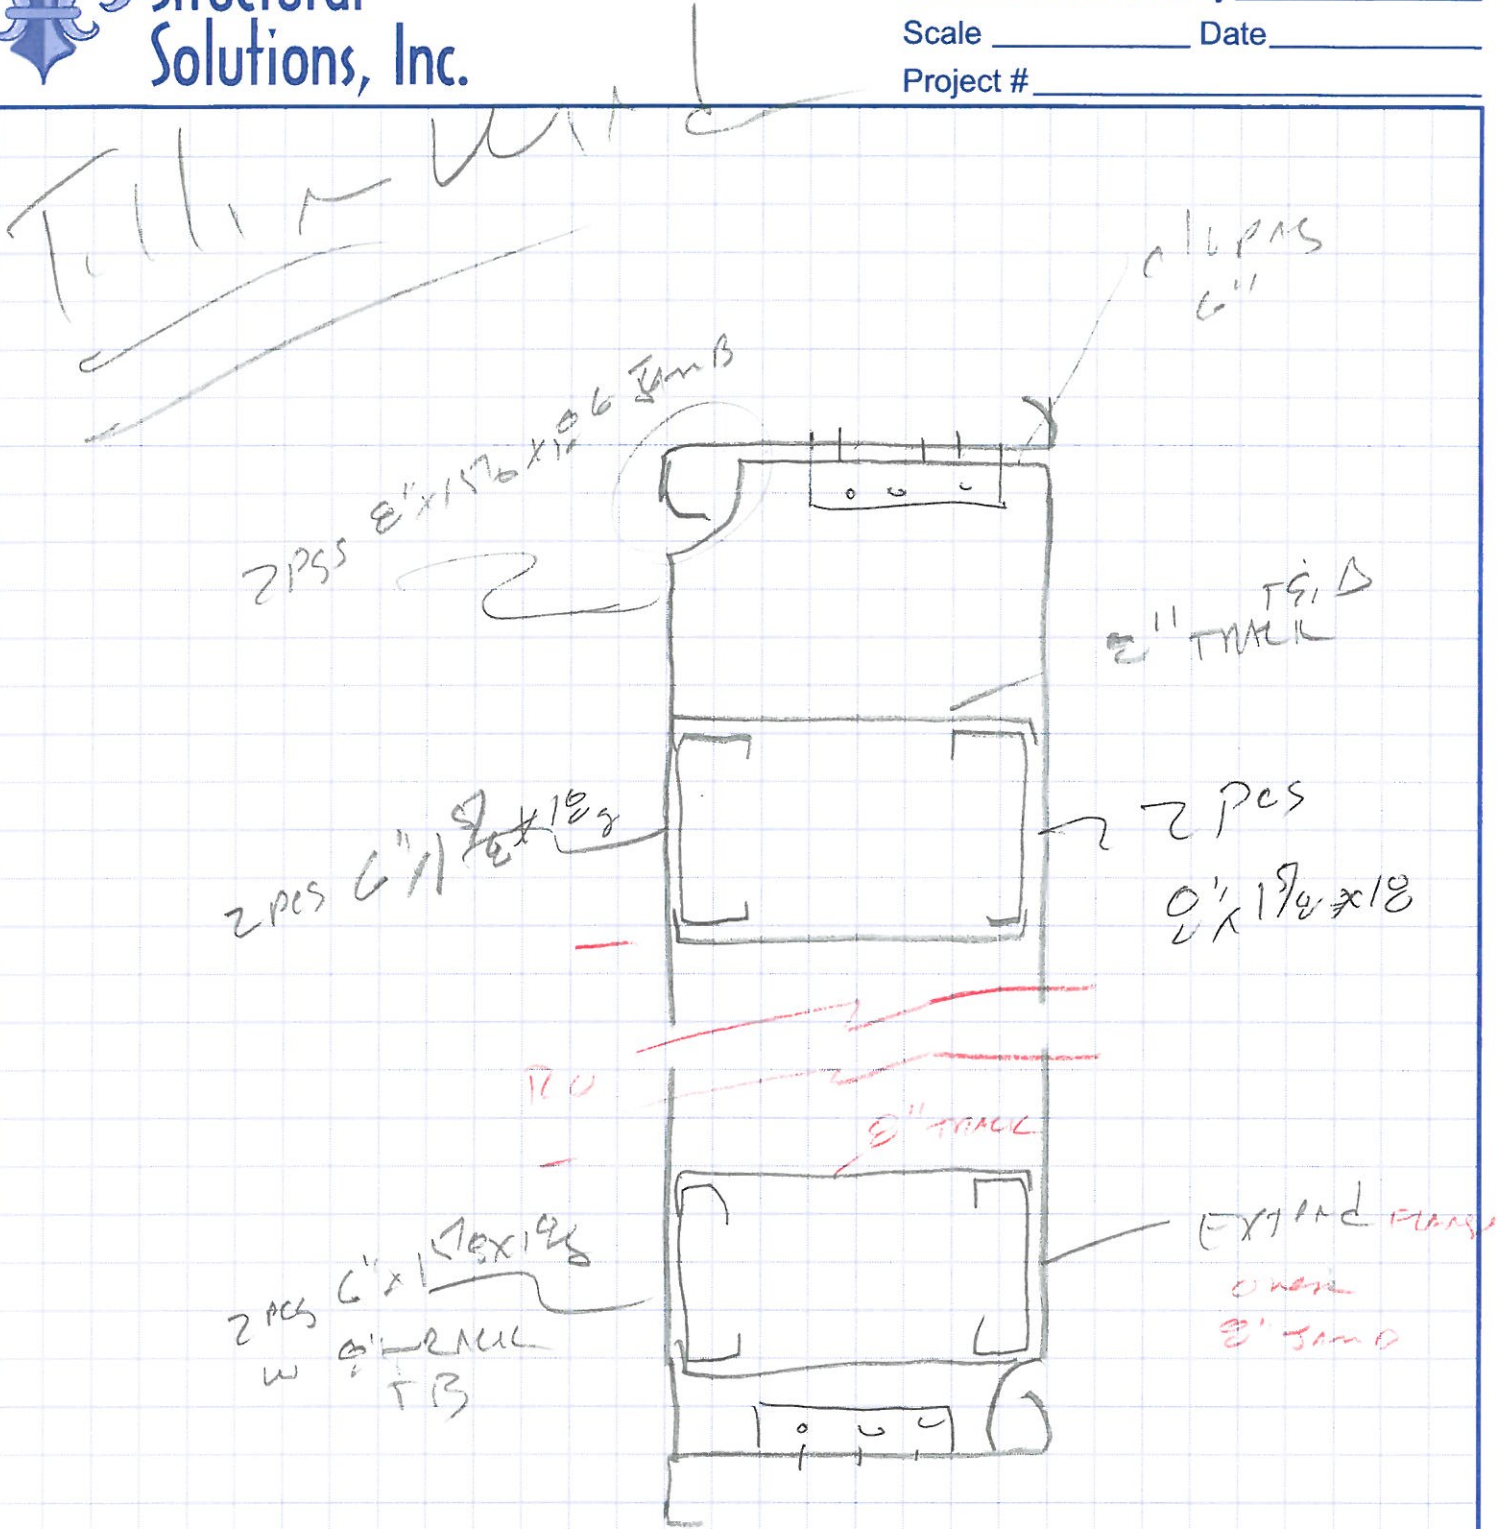

WHERE IS THIS LOCATED



10" ~~LONG~~
S


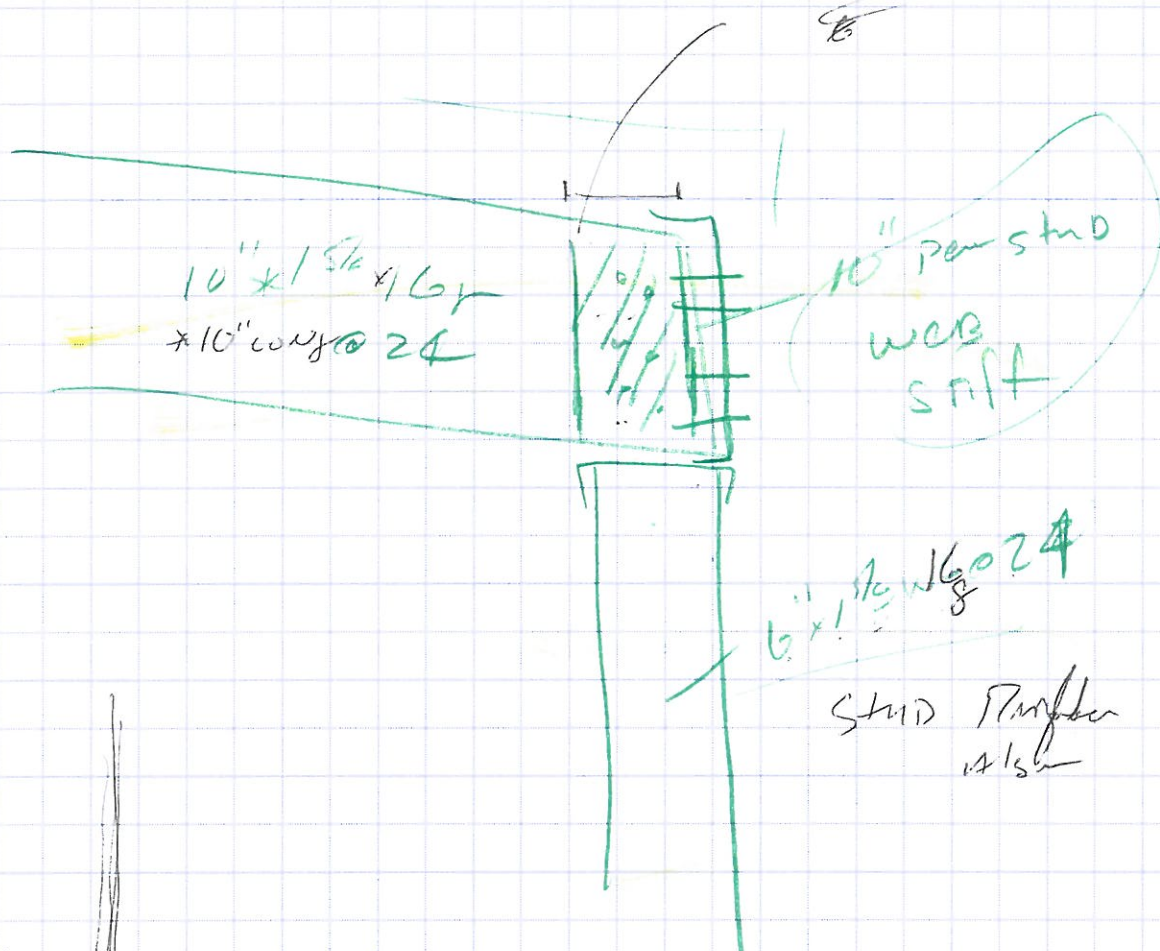



10" x 1 5/8" x 16"
x 10" LONG @ 24

10" per stud
web
stiff

6" x 1 1/2" @ 24

STUD STIFFER
ALSO

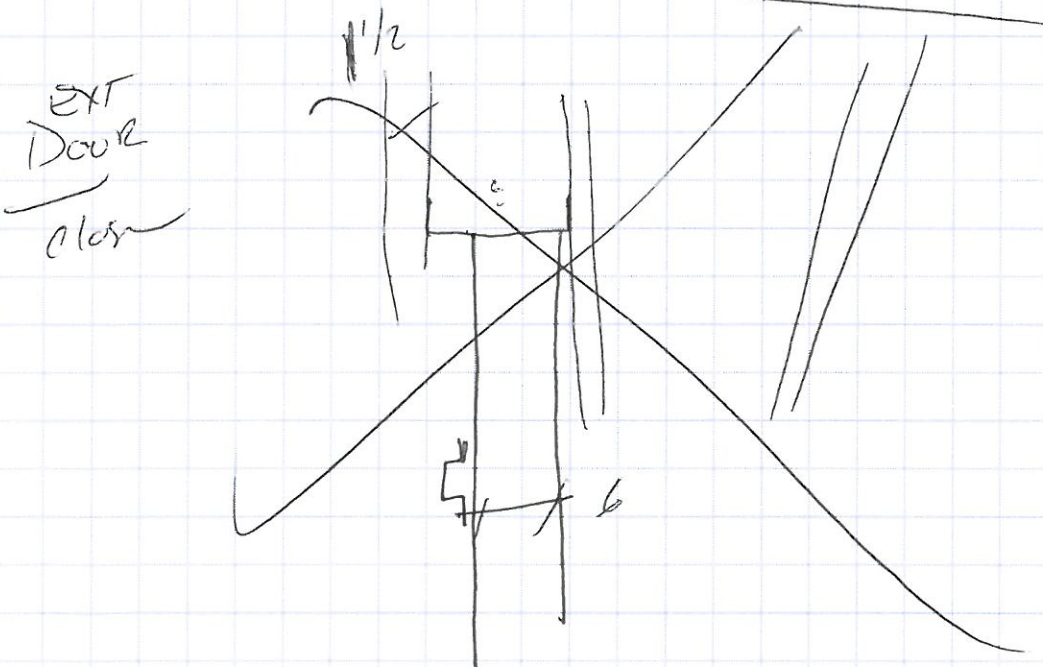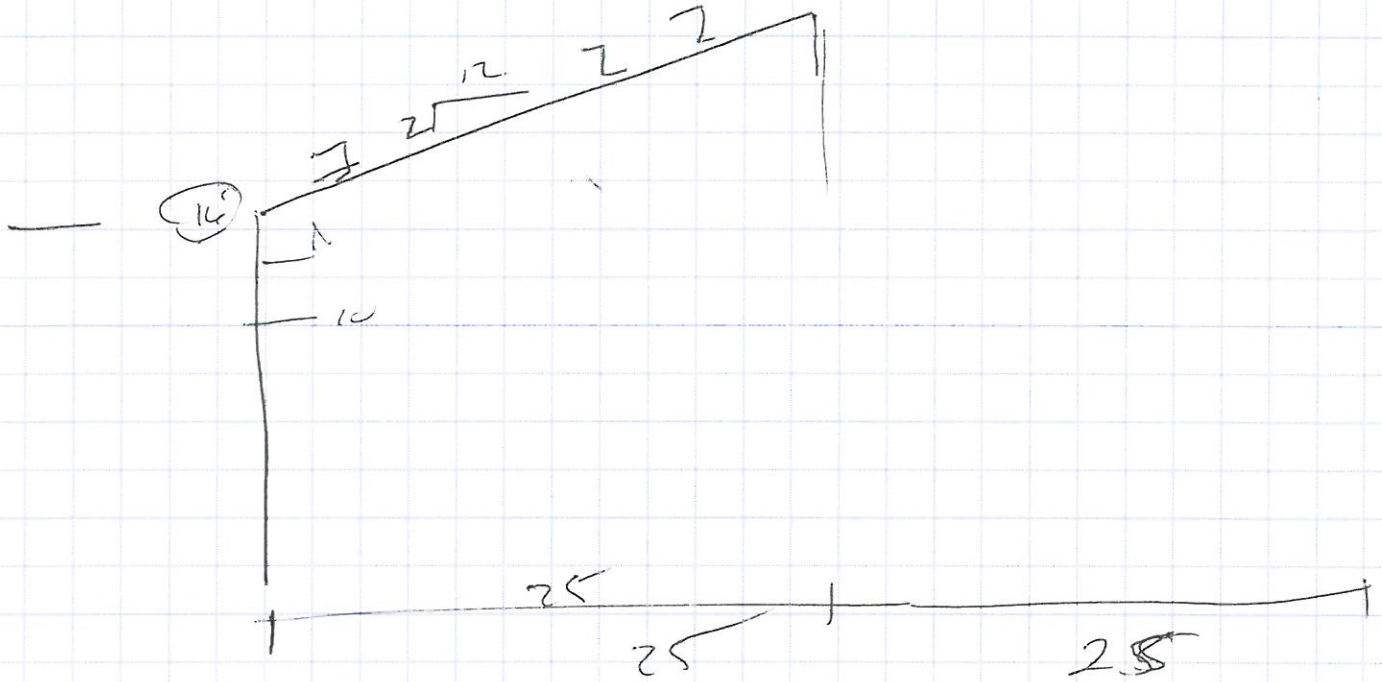

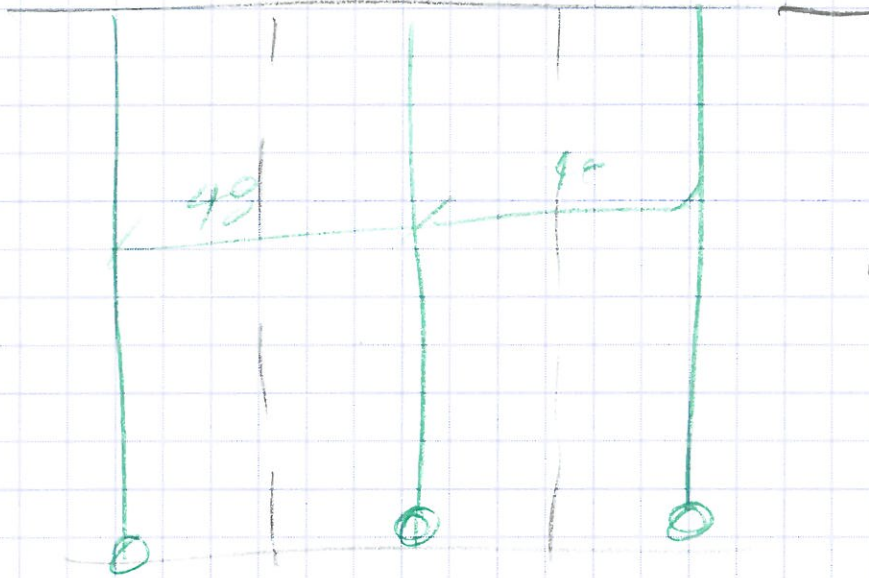

W/Fen

10' H10x1"

