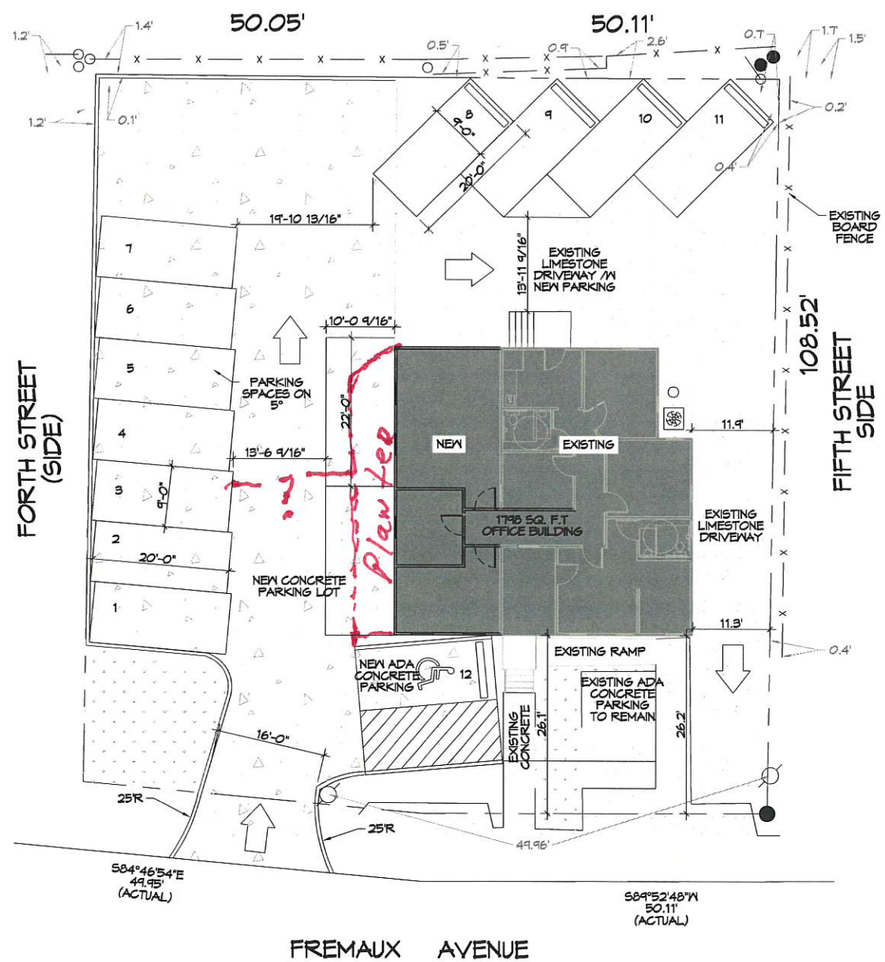

1 SITE PLAN
SCALE 1" = 10'-0"

PLANNING

ZONED C-2 COMMERCIAL DISTRICT

FLOOD ZONE

ZONE "AE"

BUILDING ELEVATION

BASE FLOOD ELEVATION "AE" = 11.0'
FINISHED FLOOR ELEVATION = 8.0'

PARKING

BUSINESS AND PROFESSIONAL OFFICES
1 SPACE FOR EACH 200 SQUARE FEET OF GROSS FLOOR AREA.
1798 / 200 = 9
PARKING REQUIRED = 9
ACTUAL PROVIDED = 12

SITE LIGHTING

EXTERIOR LIGHTING SHALL BE SHADED OR INWARDLY DIRECTED IN SUCH A MANNER SO THAT NO DIRECT LIGHTING OR GLARE BE CAST BEYOND THE PROPERTY LINE. THE INTENSITY OF SUCH LIGHTING SHALL NOT EXCEED ONE FOOT CANDLE AS MEASURED AT THE ABUTTING PROPERTY LINE.

DAMMON ENGINEERING, INC.
LOUISIANA & MISSISSIPPI
www.dammonengineering.com
info@dammonengineering.com
PH: 985.649.5832
Chief Engineer: Brian Mistch, PE
554 Old Spanish Trail
Slidell, LA 70458

REVISIONS

#	DESCRIPTION	DATE
1		

SEAL:

FLEUR DE LIS TITLE COMPANY
442 FREMAUX AVE
SLIDELL, LA 70458

JOB No:
DATE: 10-06-21
DRAWN BY: GCD
CHECKED BY: JMS

SHEET TITLE: SITE PLAN

DRAWING NUMBER: C101

SHEET No: 8 of 1