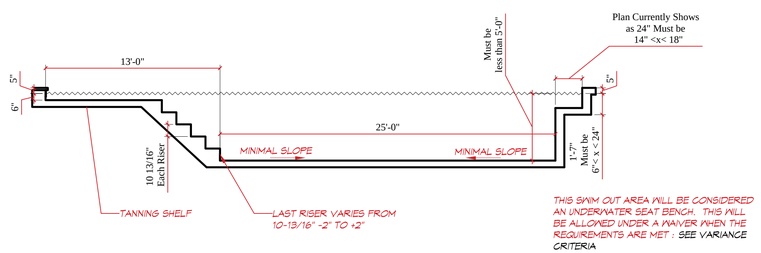

THIS SWIM OUT AREA WILL BE CONSIDERED AN UNDERWATER SEAT BENCH. THIS WILL BE ALLOWED UNDER A WAIVER WHEN THE REQUIREMENTS ARE MET : SEE VARIANCE CRITERIA

B POOL SECTION
SCALE: 3/16" = 1'-0"

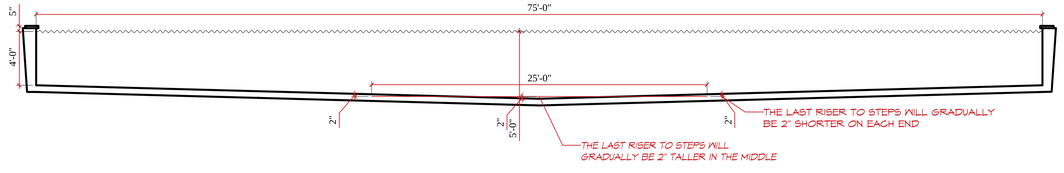

THE CODE STATES THAT: Risers at the centerline of the treads shall have a maximum uniform height of 12 inches, with the bottom riser height allowed to vary plus or minus 2 inches from the uniform riser height.

A POOL SECTION
SCALE: 3/16" = 1'-0"

DAMMON ENGINEERING, INC.
LOUISIANA & MISSISSIPPI
Chief Engineer: Brian Mistich, PE
554 Old Spanish Trail
Slidell, LA 70458
www.dammonengineering.com
info@dammonengineering.com
PH: 985.649.5832

REVISIONS

#	DESCRIPTION	DATE

SEAL:

NEW POOL
TERRABELLA POOL
(PROJECT ADDRESS)

JOB No:	2339	DATE:	[DATE]
DRAWN BY:	???	CHECKED BY:	CKD

SHEET TITLE:
POOL SECTIONS

DRAWING NUMBER:
PL-1.2

SHEET No: 00 of #