


T.I.

AMENDMENTS 1

1 FLOOR PLAN

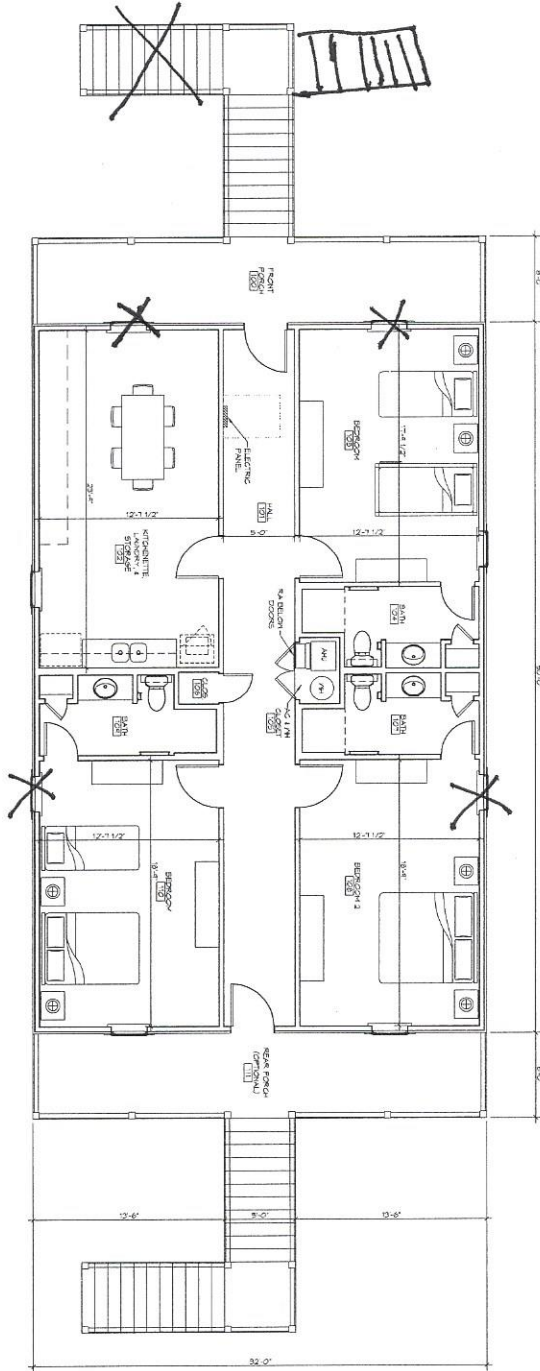

X Remove 4 of the 8 windows

All rooms too large
Please make
smaller in
length, not
width

AT RECORD LEVEL

A101

A NEW RESIDENCE FOR
**BERNARD
 TERRELL
 BRUNSON**
 SUDELL, LA 70455
 DATE: 4-2-10
 DRAWN BY: 277 CHECKED BY: CND

NO.	DESCRIPTION	REVISION	DATE

DAMMON
 ENGINEERING, INC.
 LOUISIANA & MISSISSIPPI


Chief Engineer: Brian Auslich, PE
 554 Old Spanish Trail
 Slidell, LA 70669

www.dammonengineering.com
 info@dammonengineering.com
 Ph: 985-449-5832 F: 985-441-1750



1 SITE PLAN
SCALE 1" = 30'

BASE BEARING
N62°30'00"W
206.03'

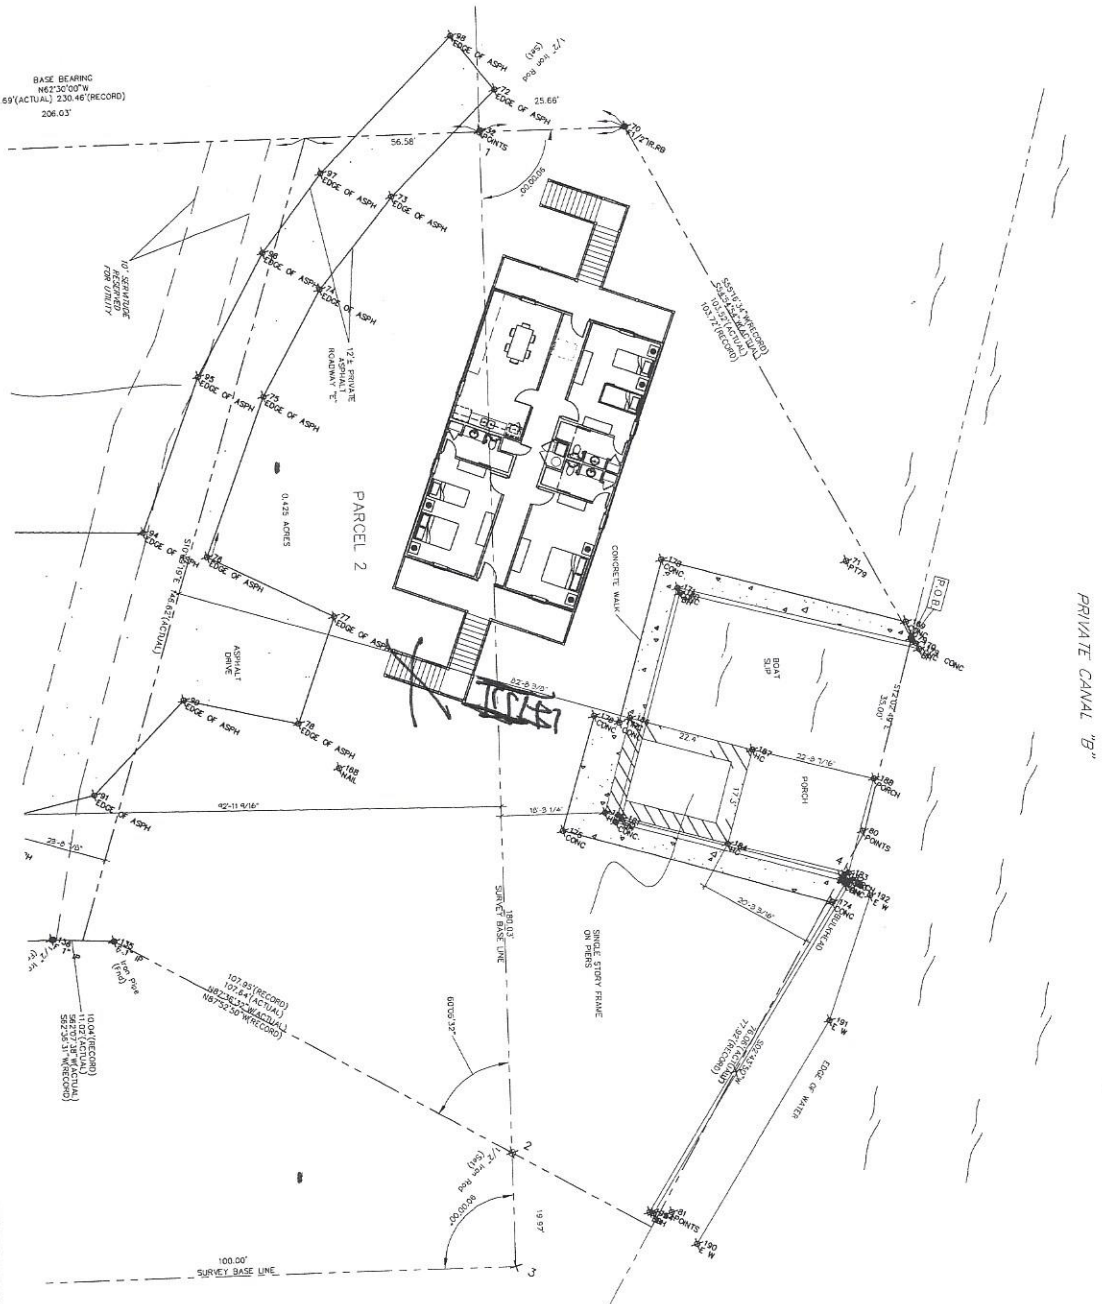

ENGINEERED SITE PLAN

PROJECT NUMBER
C102
SHEET NO. 02 OF 4

A NEW RESIDENCE FOR
**BARBARA
FERGUSON**

SUDELL, LA 70488
DATE: 4-12-16
DRAWN BY: 227
CHECKED BY: CND

NO.	DESCRIPTION	DATE
1		
2		
3		
4		
5		
6		
7		

DAMMON
ENGINEERING, INC.
LOUISIANA & MISSISSIPPI

Chief Engineer: Brian Jankov, PE
354 Old Spanish Trail
www.dammonengineering.com
info@dammonengineering.com
