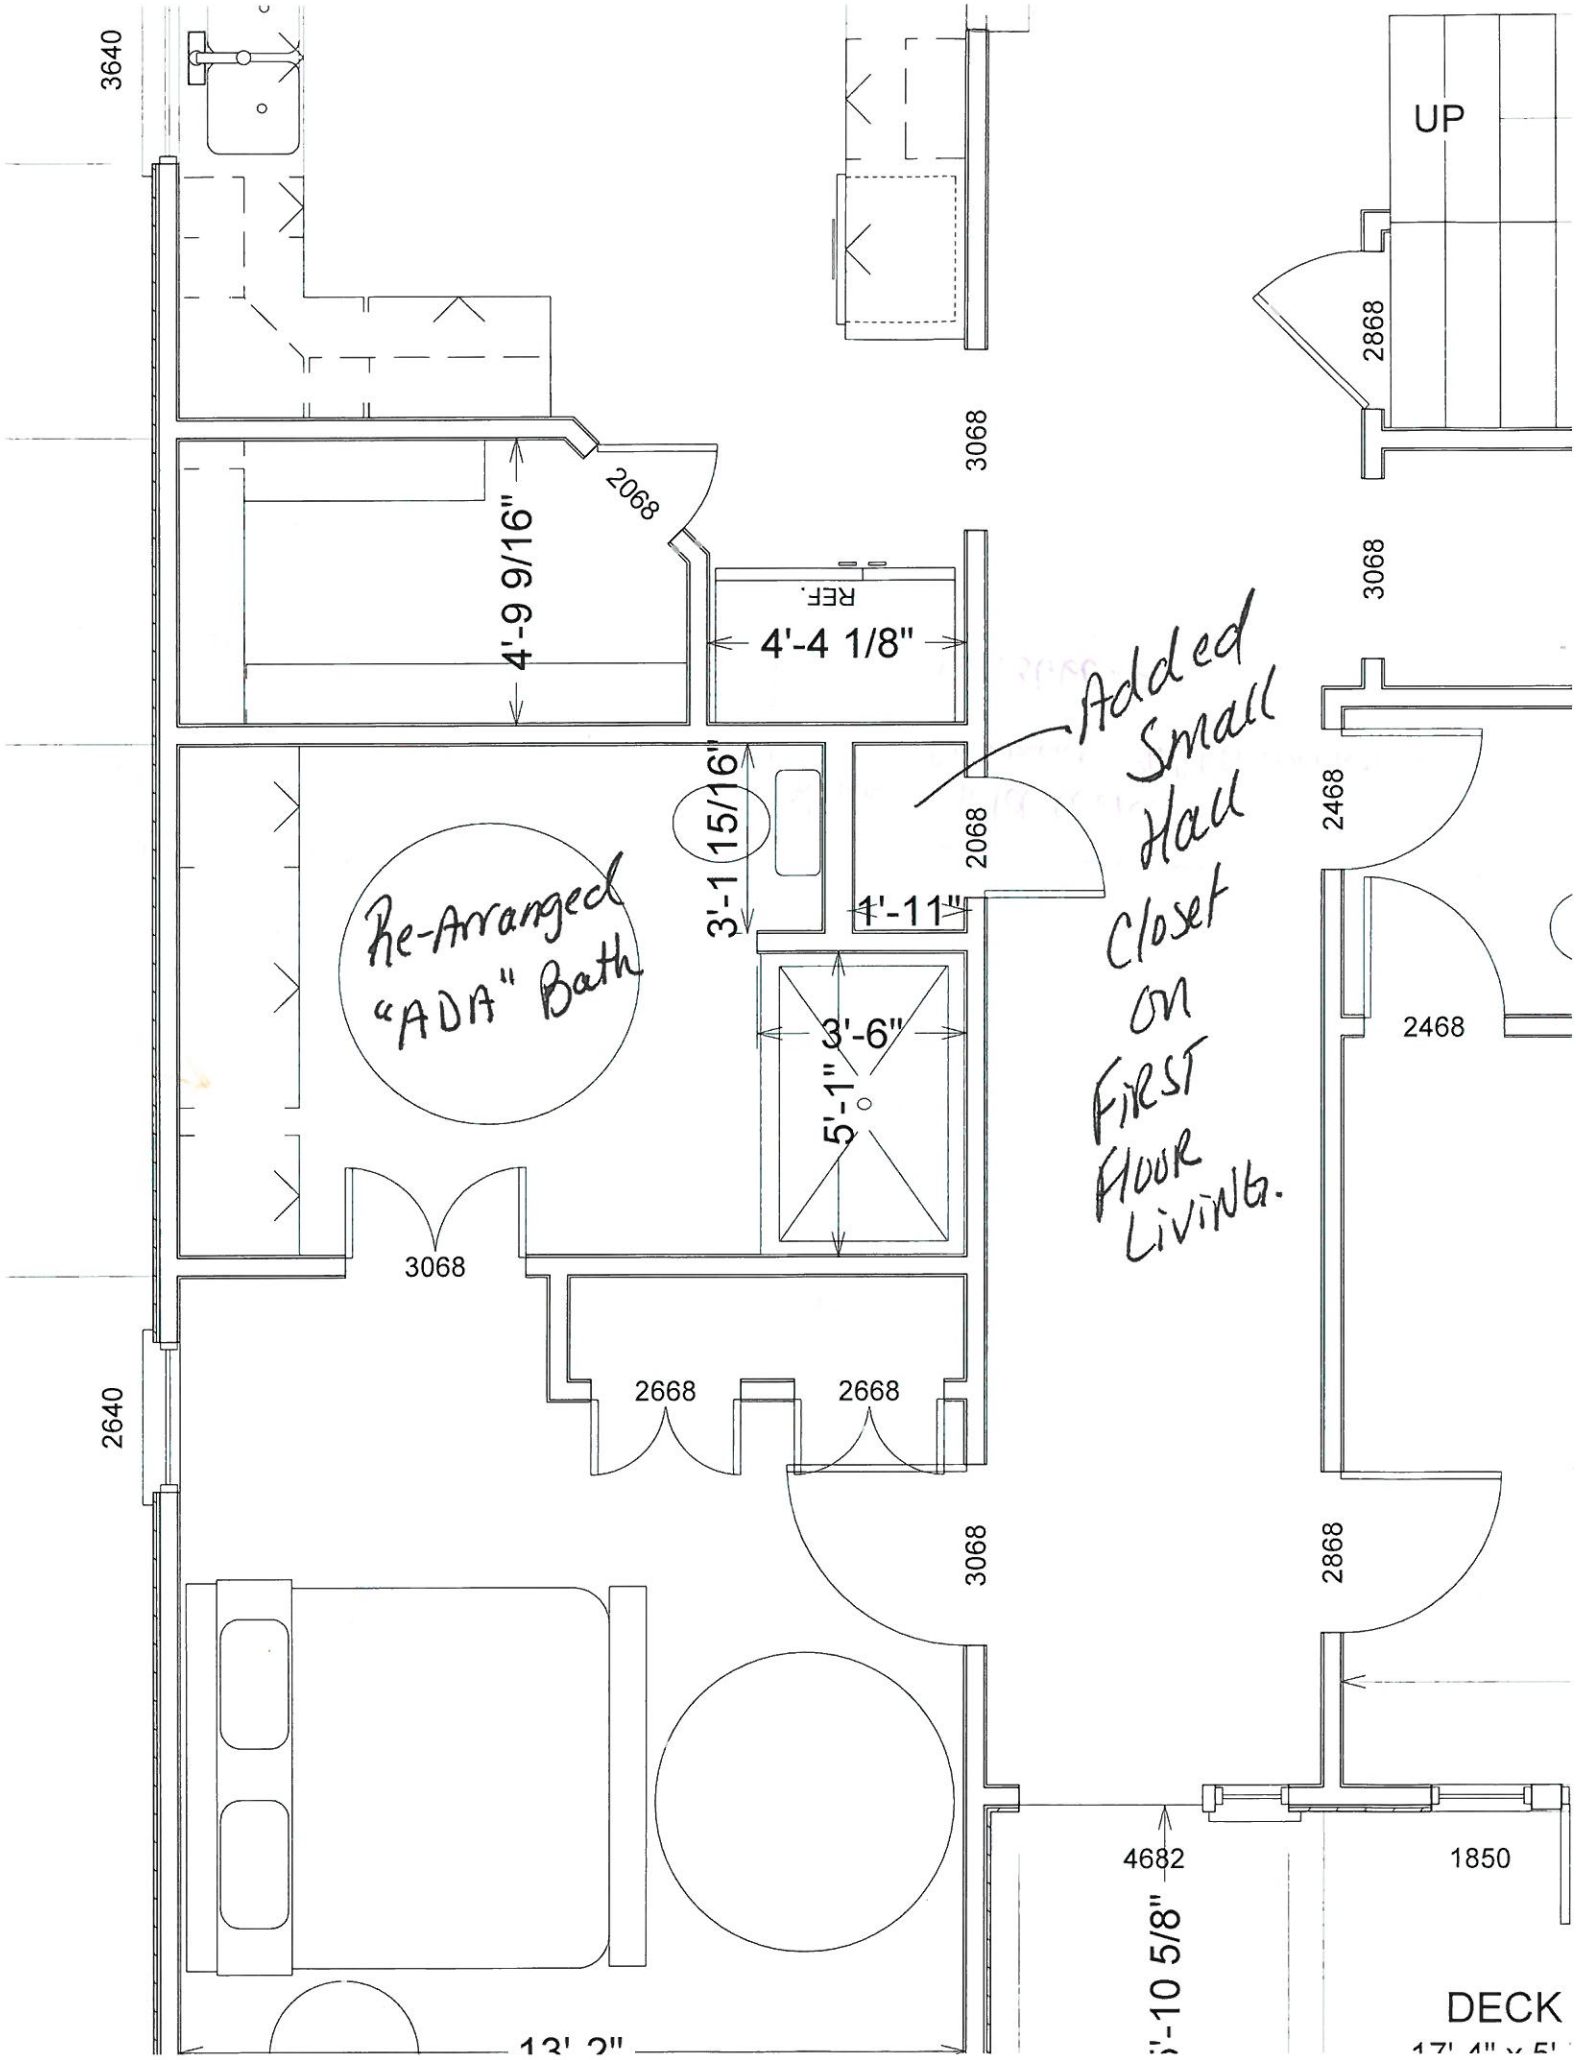
3640
UP
2868
3068
2068
4'-9 9/16"
REF.
4'-4 1/8"
3068
Added Small Hall Closet on First Floor Living.
2468
3'-1 15/16"
2068
4'-11"
Re-Arranged "ADA" Bath
3'-6"
5'-1"
2468
3068
2640
2668
2668
3068
2868
4682
1850
5'-10 5/8"
DECK
13' 2"