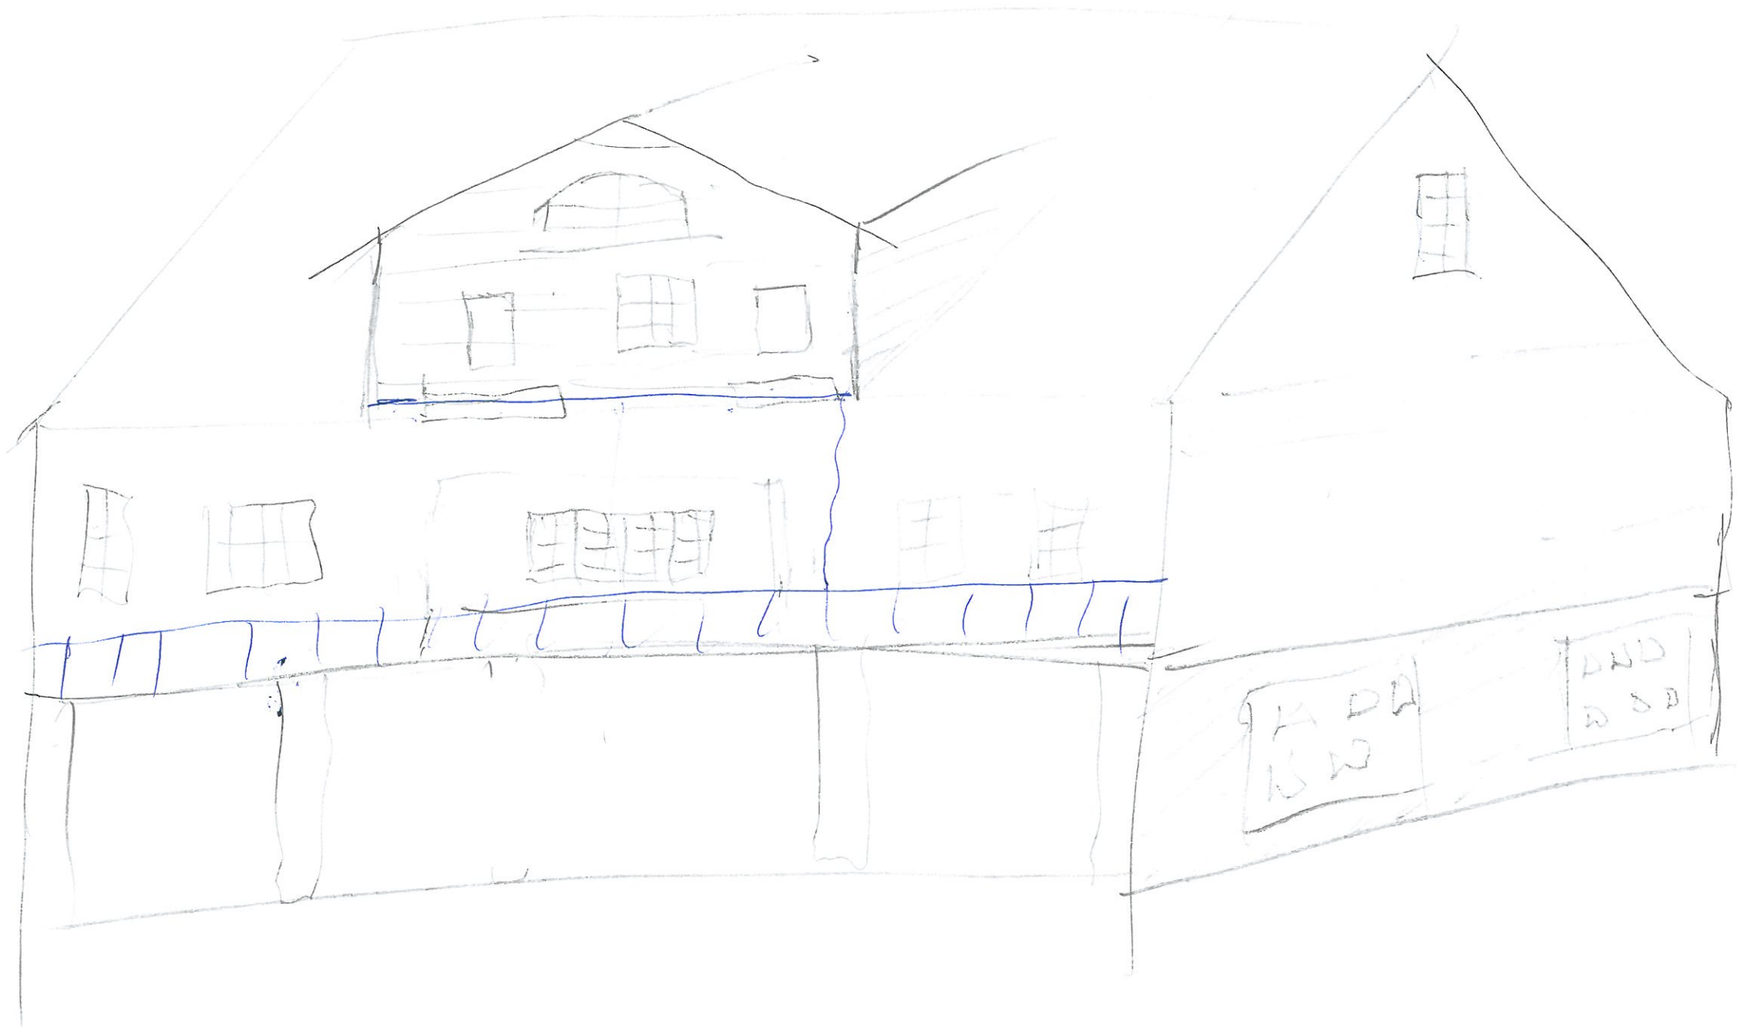

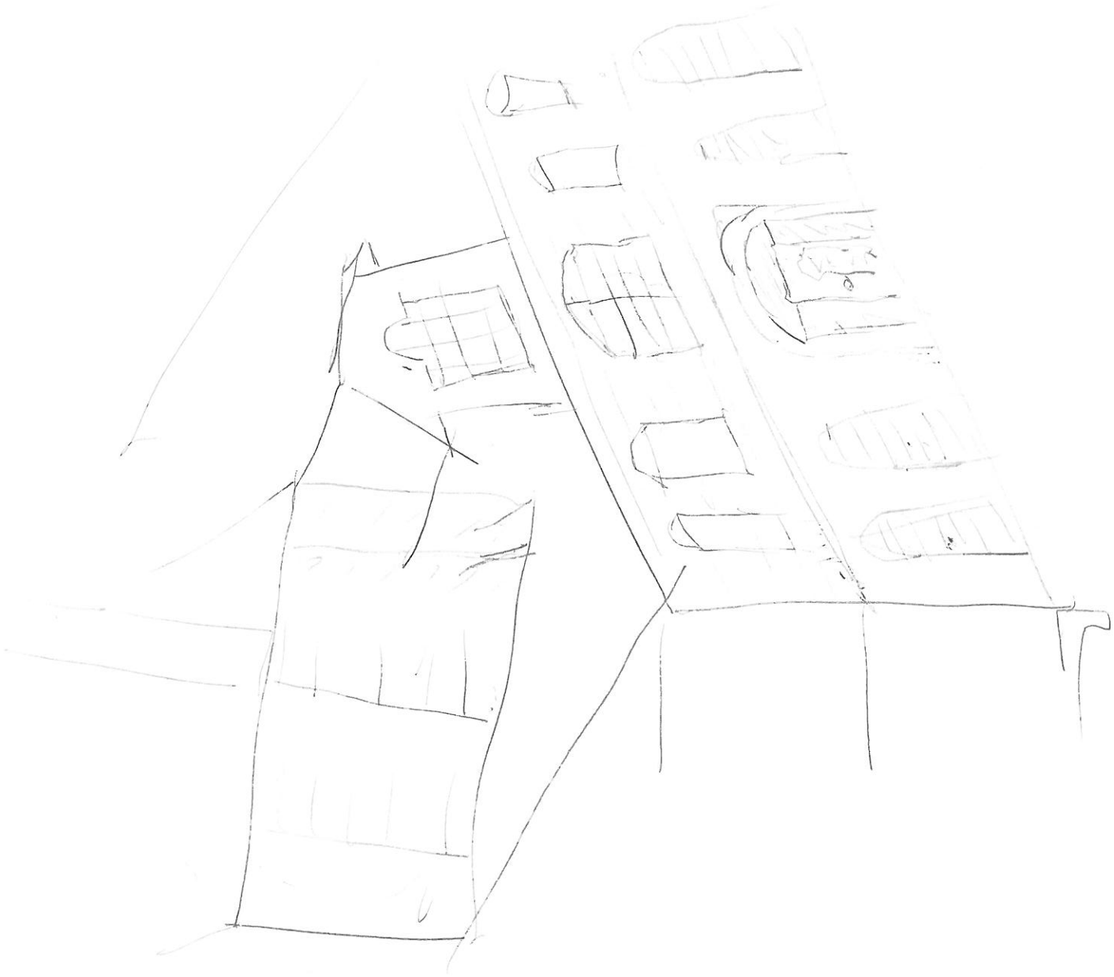

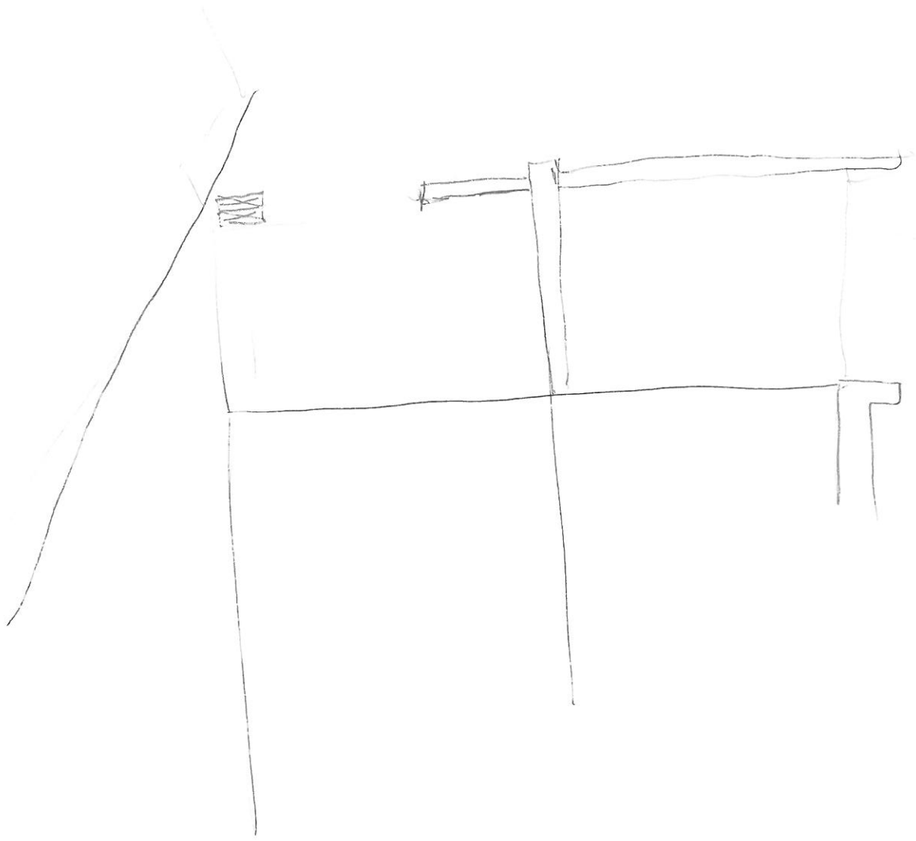

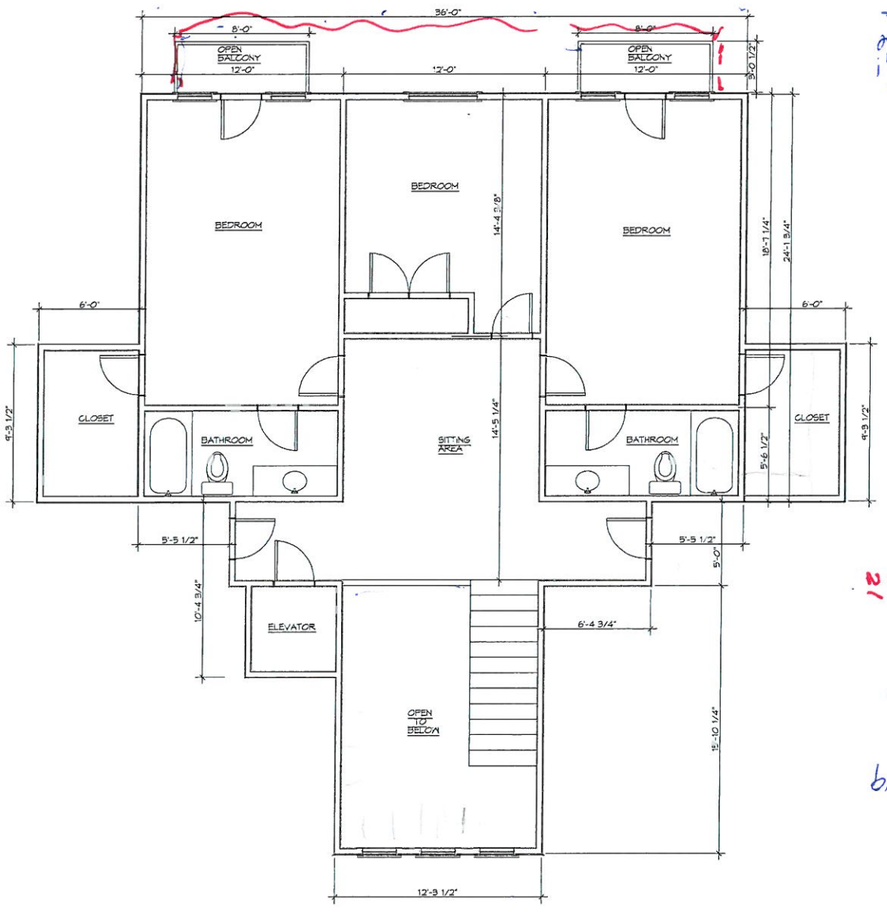

2 A101 A101 LEVEL THREE LAYOUT
SCALE: 1/4" = 1'-0"

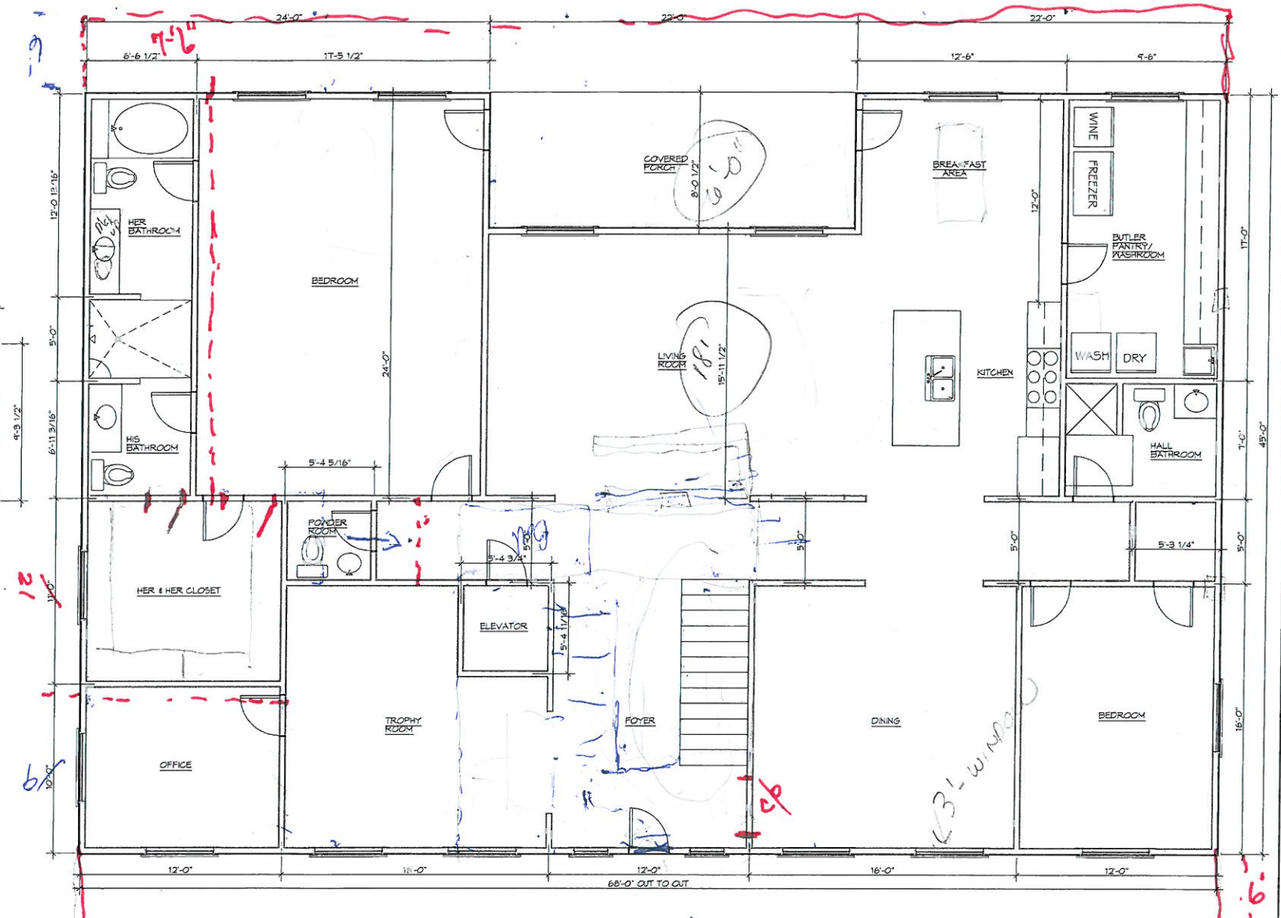

2 A101 A101 LEVEL TWO LAYOUT
SCALE: 1/4" = 1'-0"

DAMMON ENGINEERING, INC.
Architects & Engineers
www.dammonengineering.com
info@dammonengineering.com
P/F: 985.649.5832
F: 985.641.5950
Chief Architect: Kevin J. Kinchen, NCARB
Chief Engineer: Brian Mistich, PE
554 Old Spanish Trail
Slidell, LA 70458

#	DESCRIPTION	REVISIONS	DATE

SEAL:

PRELIMINARY FLOOR PLAN
BRUCE & LISA
RESIDENCE
THREE JENNIFER LANE
SLIDELL, LOUISIANA 70458

JOB No:	225
DATE:	06-06-15
DRAWN BY:	CKD
CHECKED BY:	CKD

SHEET TITLE:
LEVEL TWO & LEVEL THREE LAYOUT

DRAWING NUMBER:
A101

SHEET No: 00 of #