


Clouds indicate walls that will be removed.

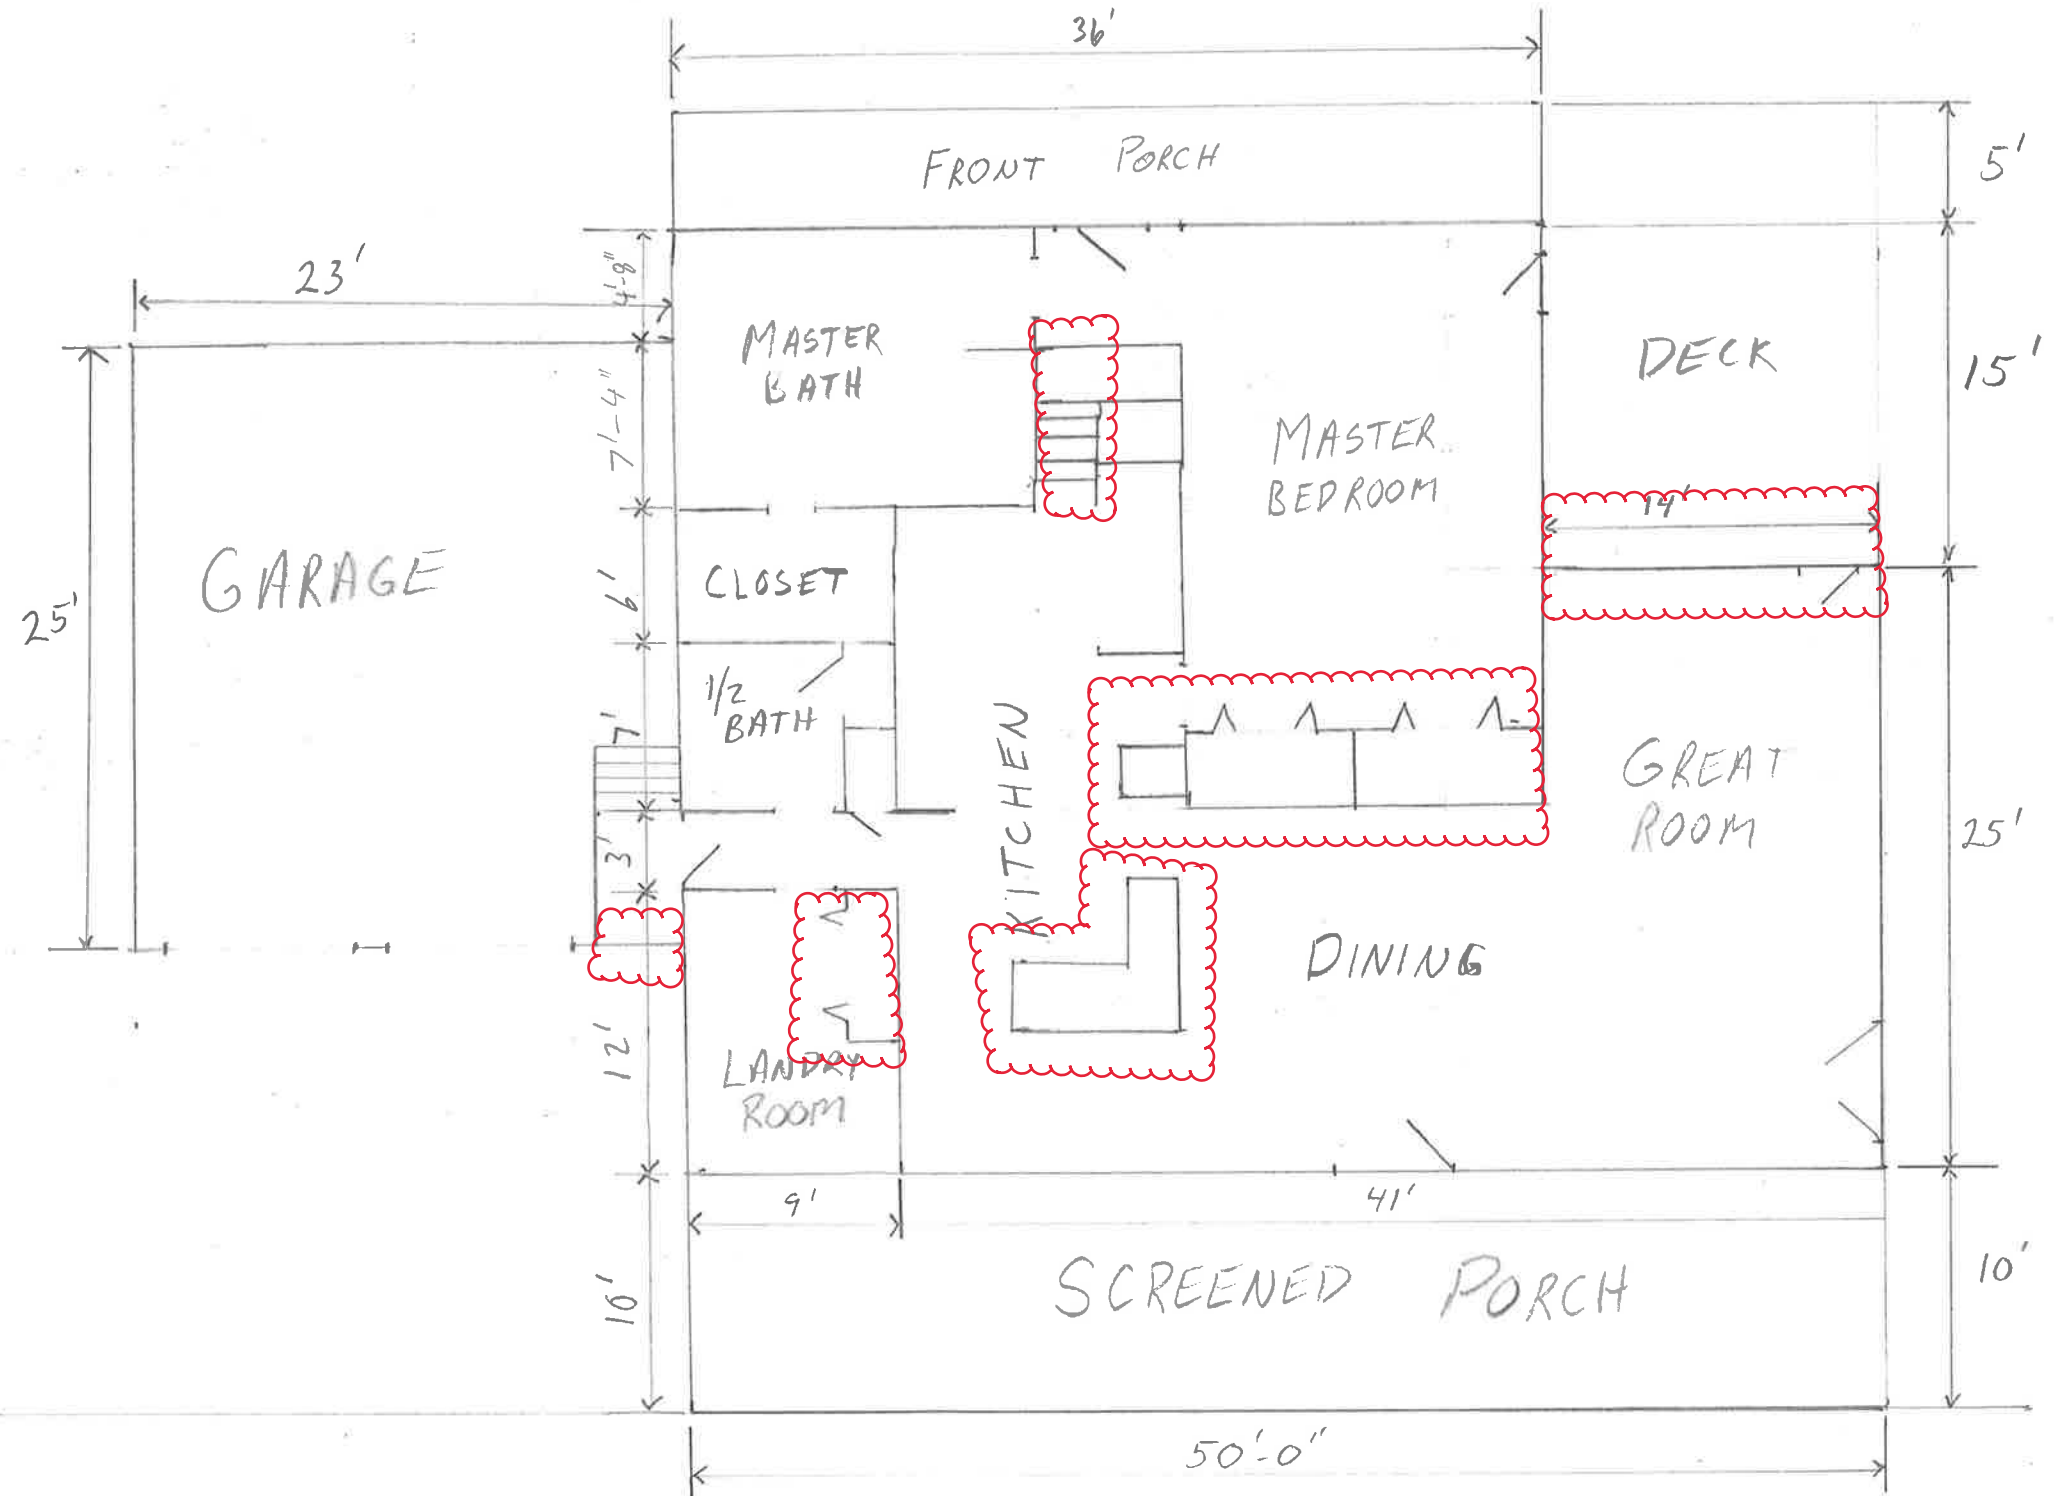

FIRST FLOOR  
SCALE 1/8" = 1"

82289 HEINTZ JENKINS RD  
FIRST FLOOR PLAN