


SECOND STREET

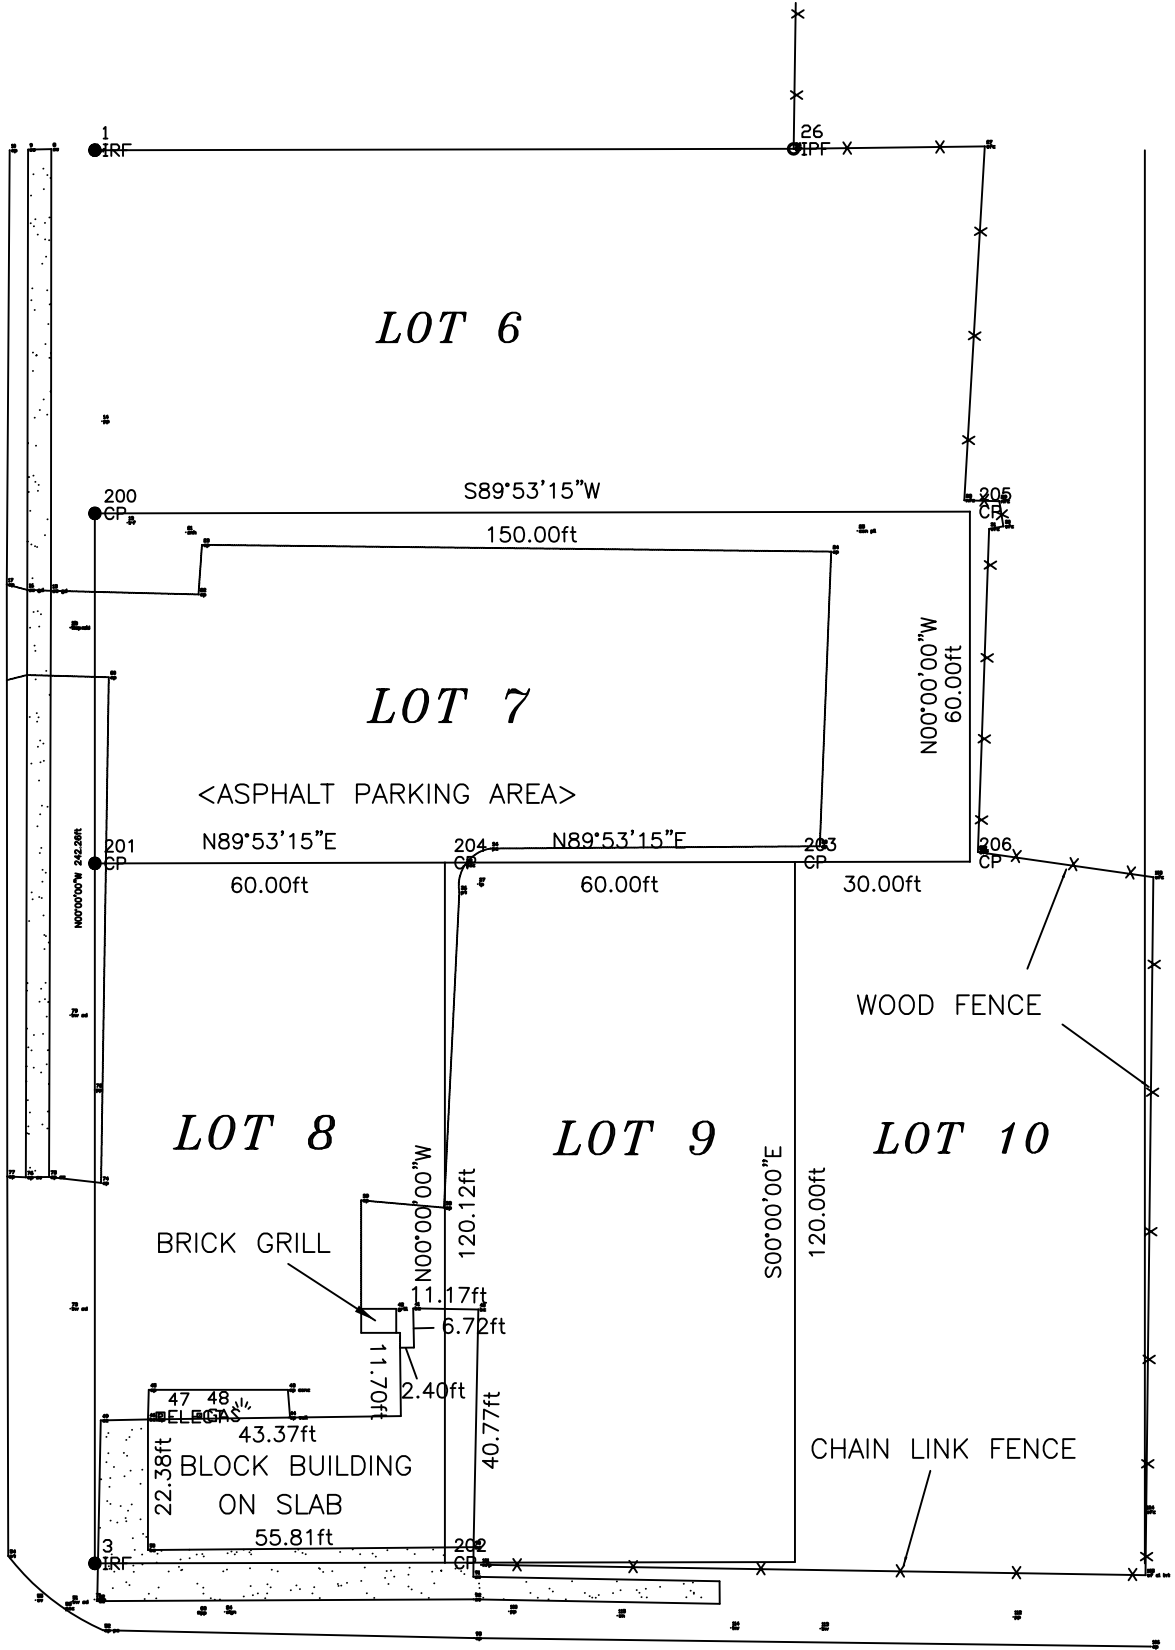

G U Z M A N S T R E E T

LEGEND

- 15" iron rod found
- = pipe found
- ⊙ = grass area
- ⊠ = light pole
- ⬤ = power pole