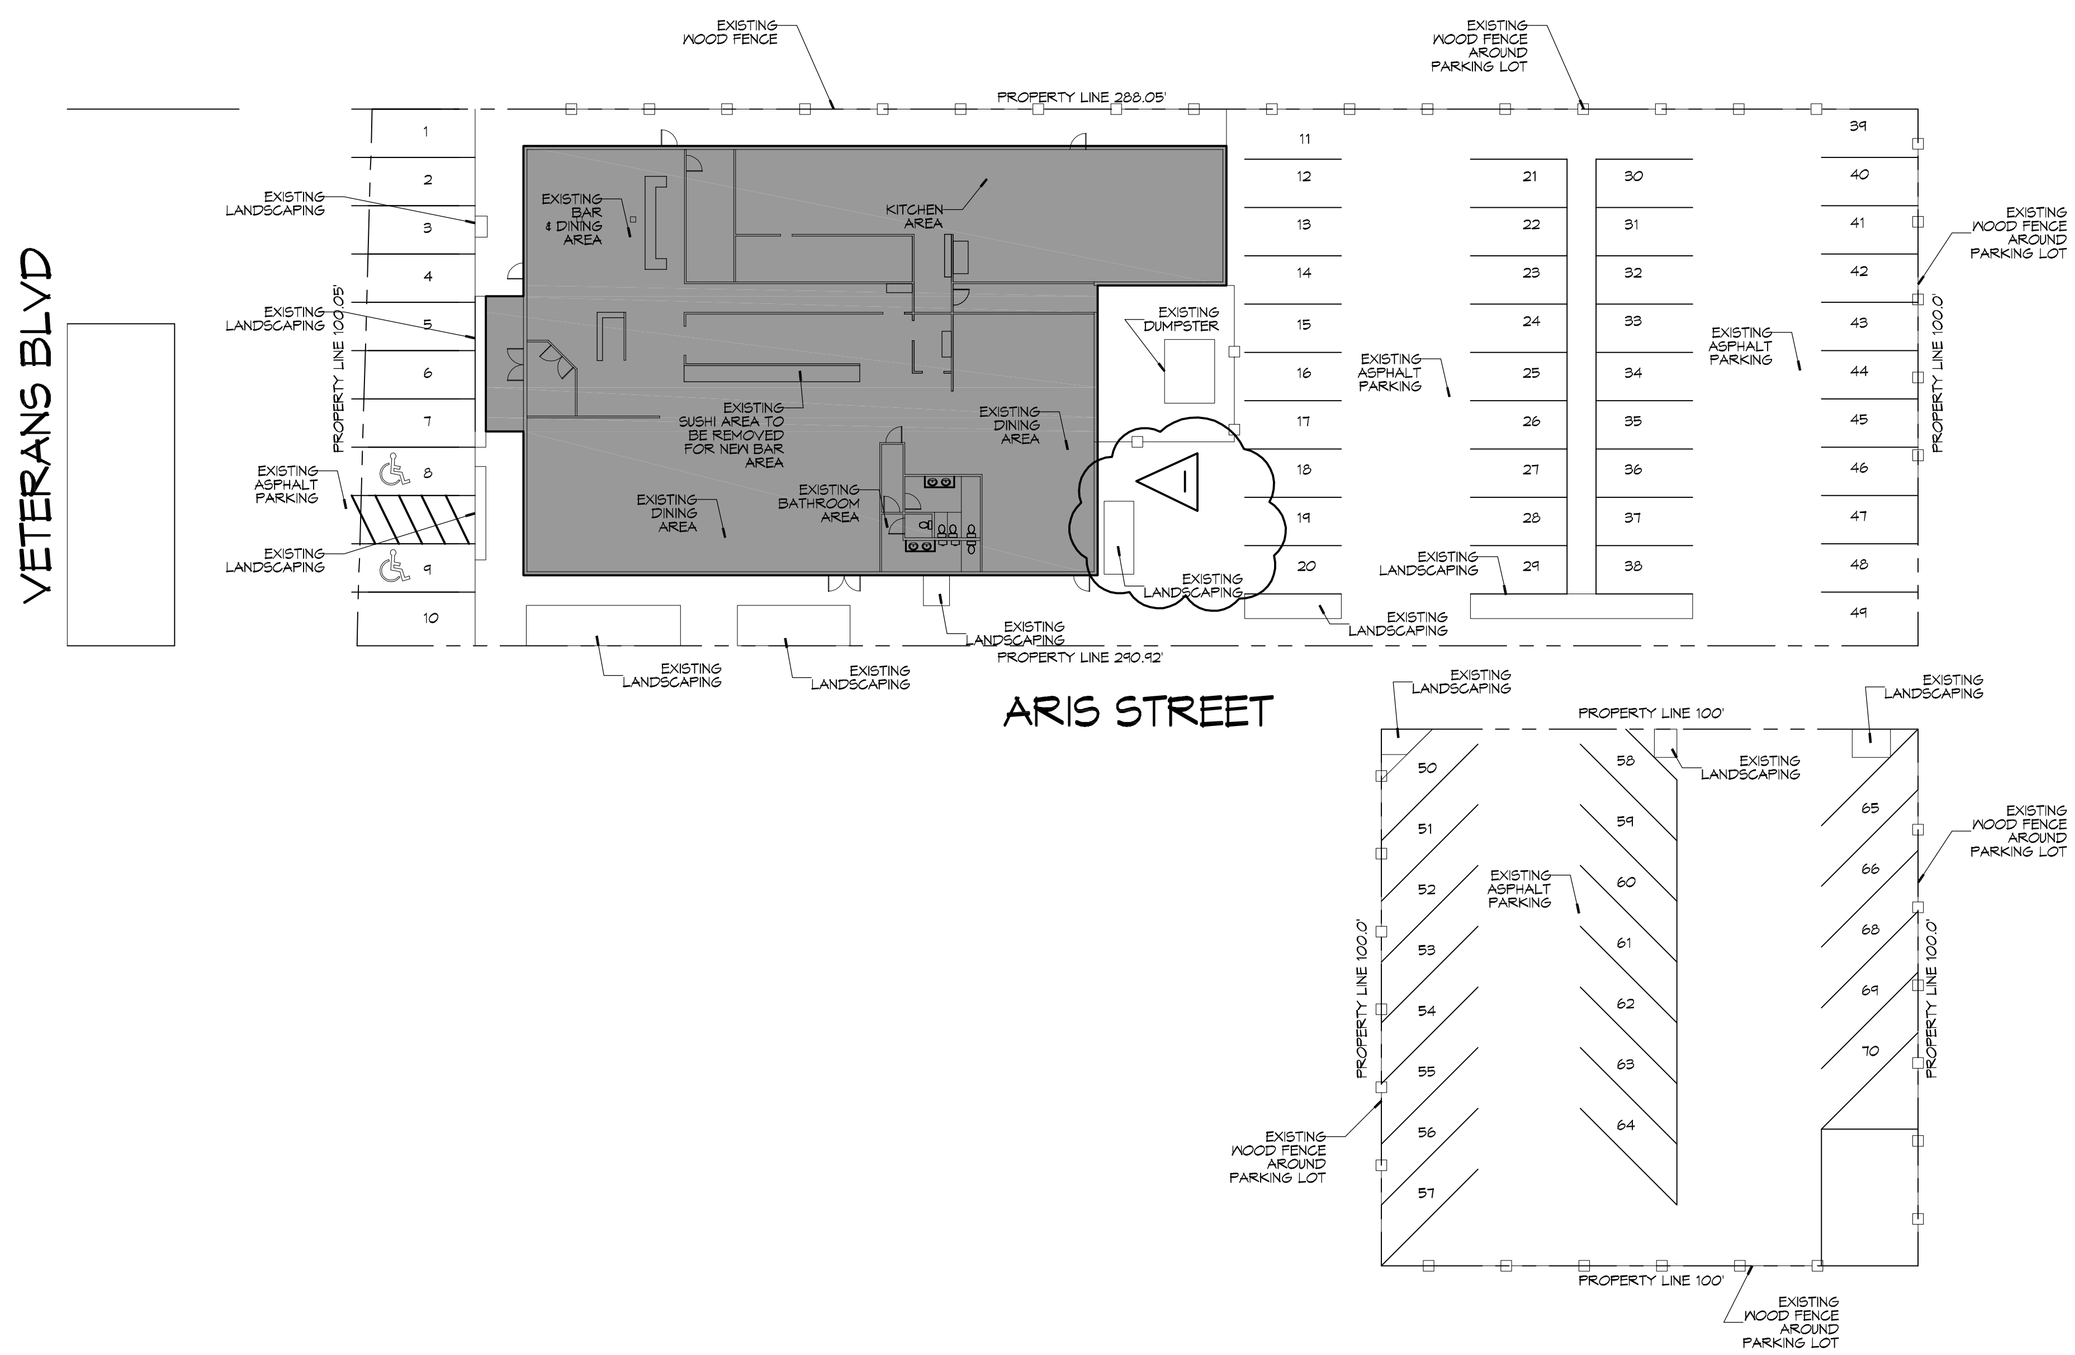

N

1 EXISTING SITE PLAN & PARKING

SCALE: 1"=20'-0"

I HAVE RESEARCHED THE BUILDING AND RELATED CODES OF JEFFERSON PARISH AND THE LOUISIANA STATE UNIFORM CONSTRUCTION CODE AND TO THE BEST OF MY KNOWLEDGE AND BELIEF THESE DRAWINGS ARE IN COMPLIANCE THEREWITH.

DAMMON ENGINEERING, INC.
LOUISIANA & MISSISSIPPI
www.dammonengineering.com
Info@dammonengineering.com
PH: 985.649.5832 F: 985.641.5950
Chief Engineer: Brian Mistich, PE
554 Old Spanish Trail
Slidell, LA 70458

REVISIONS

#	DESCRIPTION	DATE
1	REMOVED REAR PATIO	01-19-16

SEAL:

STATE OF LOUISIANA
BRIAN A. MISTICH
License No. 30187
01-19-16
PROFESSIONAL ENGINEER

EL PASO MEXICAN RESTAURANT

801 VETERANS BLVD
METAIRIE AVE, LOUISIANA

JOB No:	2266	DATE:	01-08-16
DRAWN BY:	CKD	CHECKED BY:	BAM

This drawing is the property of Dammon Engineering, Inc. and is protected by Copyright Laws. Any alteration, reproduction or distribution of this drawing without the written consent of Dammon Engineering, Inc. is prohibited. Dammon Engineering, Inc. shall not be liable for changes made to this drawing by others. Reuse of this drawing for other projects or for extensions of this project by others, for future projects or for alterations and additions to this project by others, is not allowed without written consent of Dammon Engineering, Inc. and shall be at the sole risk of the user. Dammon Engineering, Inc. reserves the right to charge for any such use.

SHEET TITLE:
EXISTING SITE PLAN & PARKING

DRAWING NUMBER:
C100

SHEET No: 2 of 4