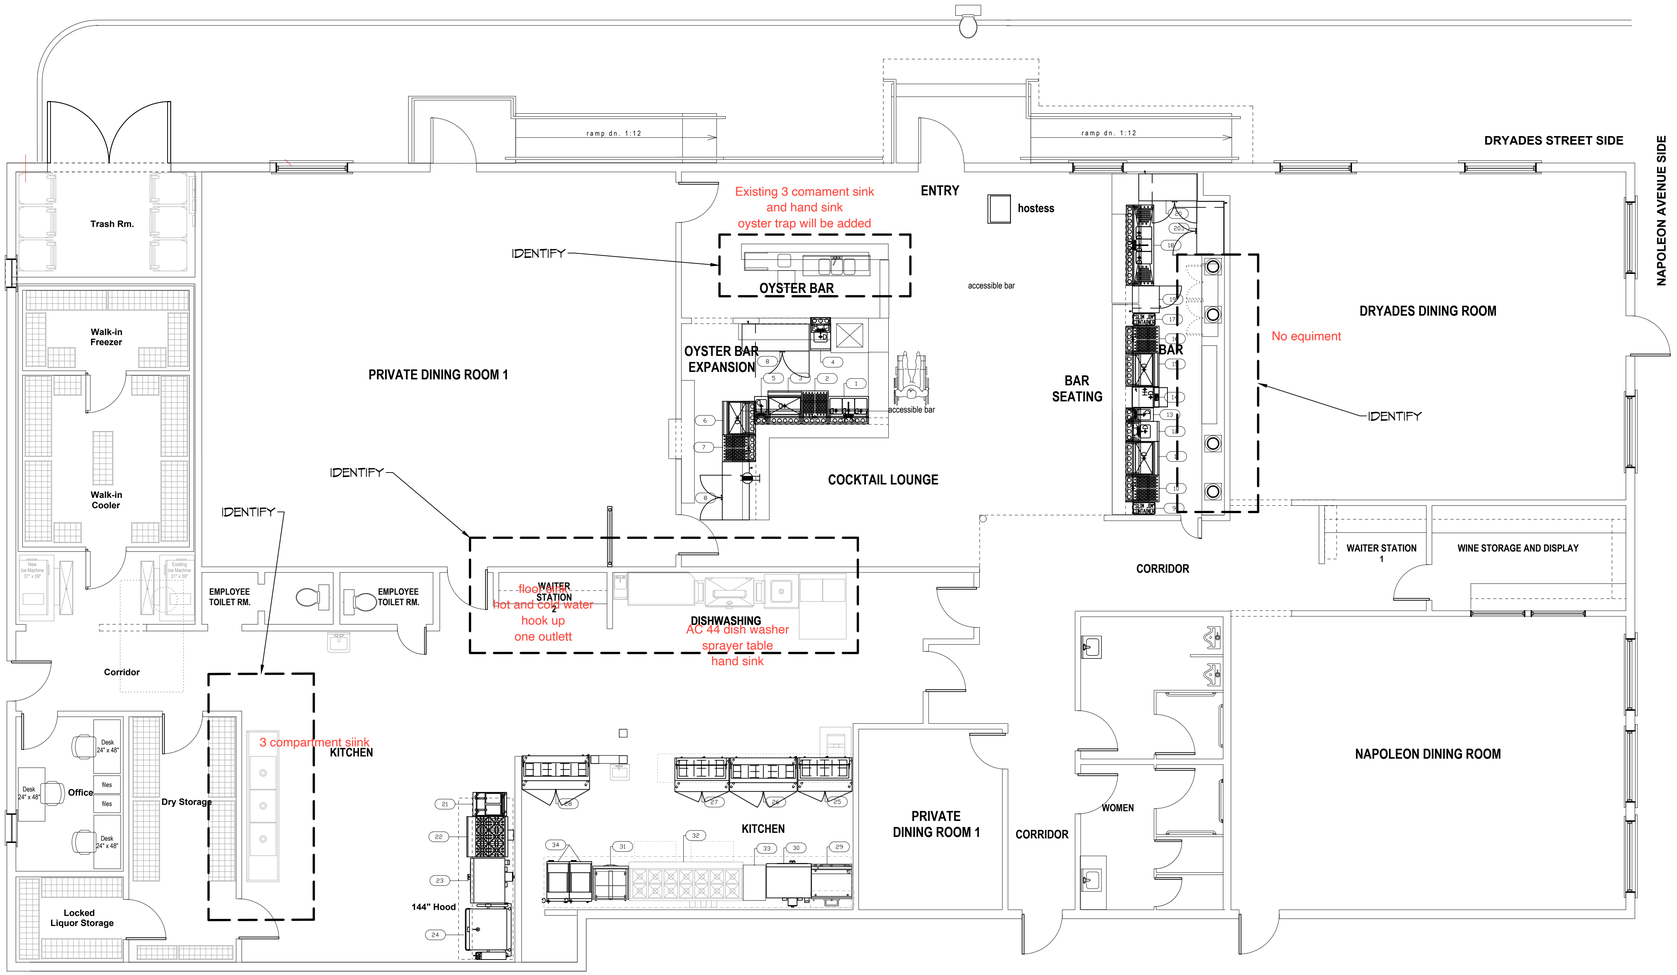

DAMMON ENGINEERING, INC.
LOUISIANA & MISSISSIPPI

www.dammonengineering.com
info@dammonengineering.com
PH: 985.649.5931

Chief Engineer: Brian Mistich, PE
554 Old Spanish Trail
Slidell, LA 70458

#	DESCRIPTION	DATE
	REVISIONS	

SEAL:

5/17/2024

RESTAURANT
PASCAL'S MANALE
1838 NAPOLEON AVENUE, NEW ORLEANS, LA 70115

JOB No:	2024
DATE:	07/2/2025
DRAWN BY:	CAD
CHECKED BY:	BAM

These drawings are at all times the property of Dammon Engineering, and are not to be reproduced or used for any other purpose than that for which they are specifically prepared and delivered. Only the original drawings bearing the seal of Dammon Engineering are to be considered as the drawings for which the seal is affixed and are the only drawings to be used for construction purposes.

SHEET TITLE:
POWER PLAN

DRAWING NUMBER:

E101

SHEET No: 1 of 7