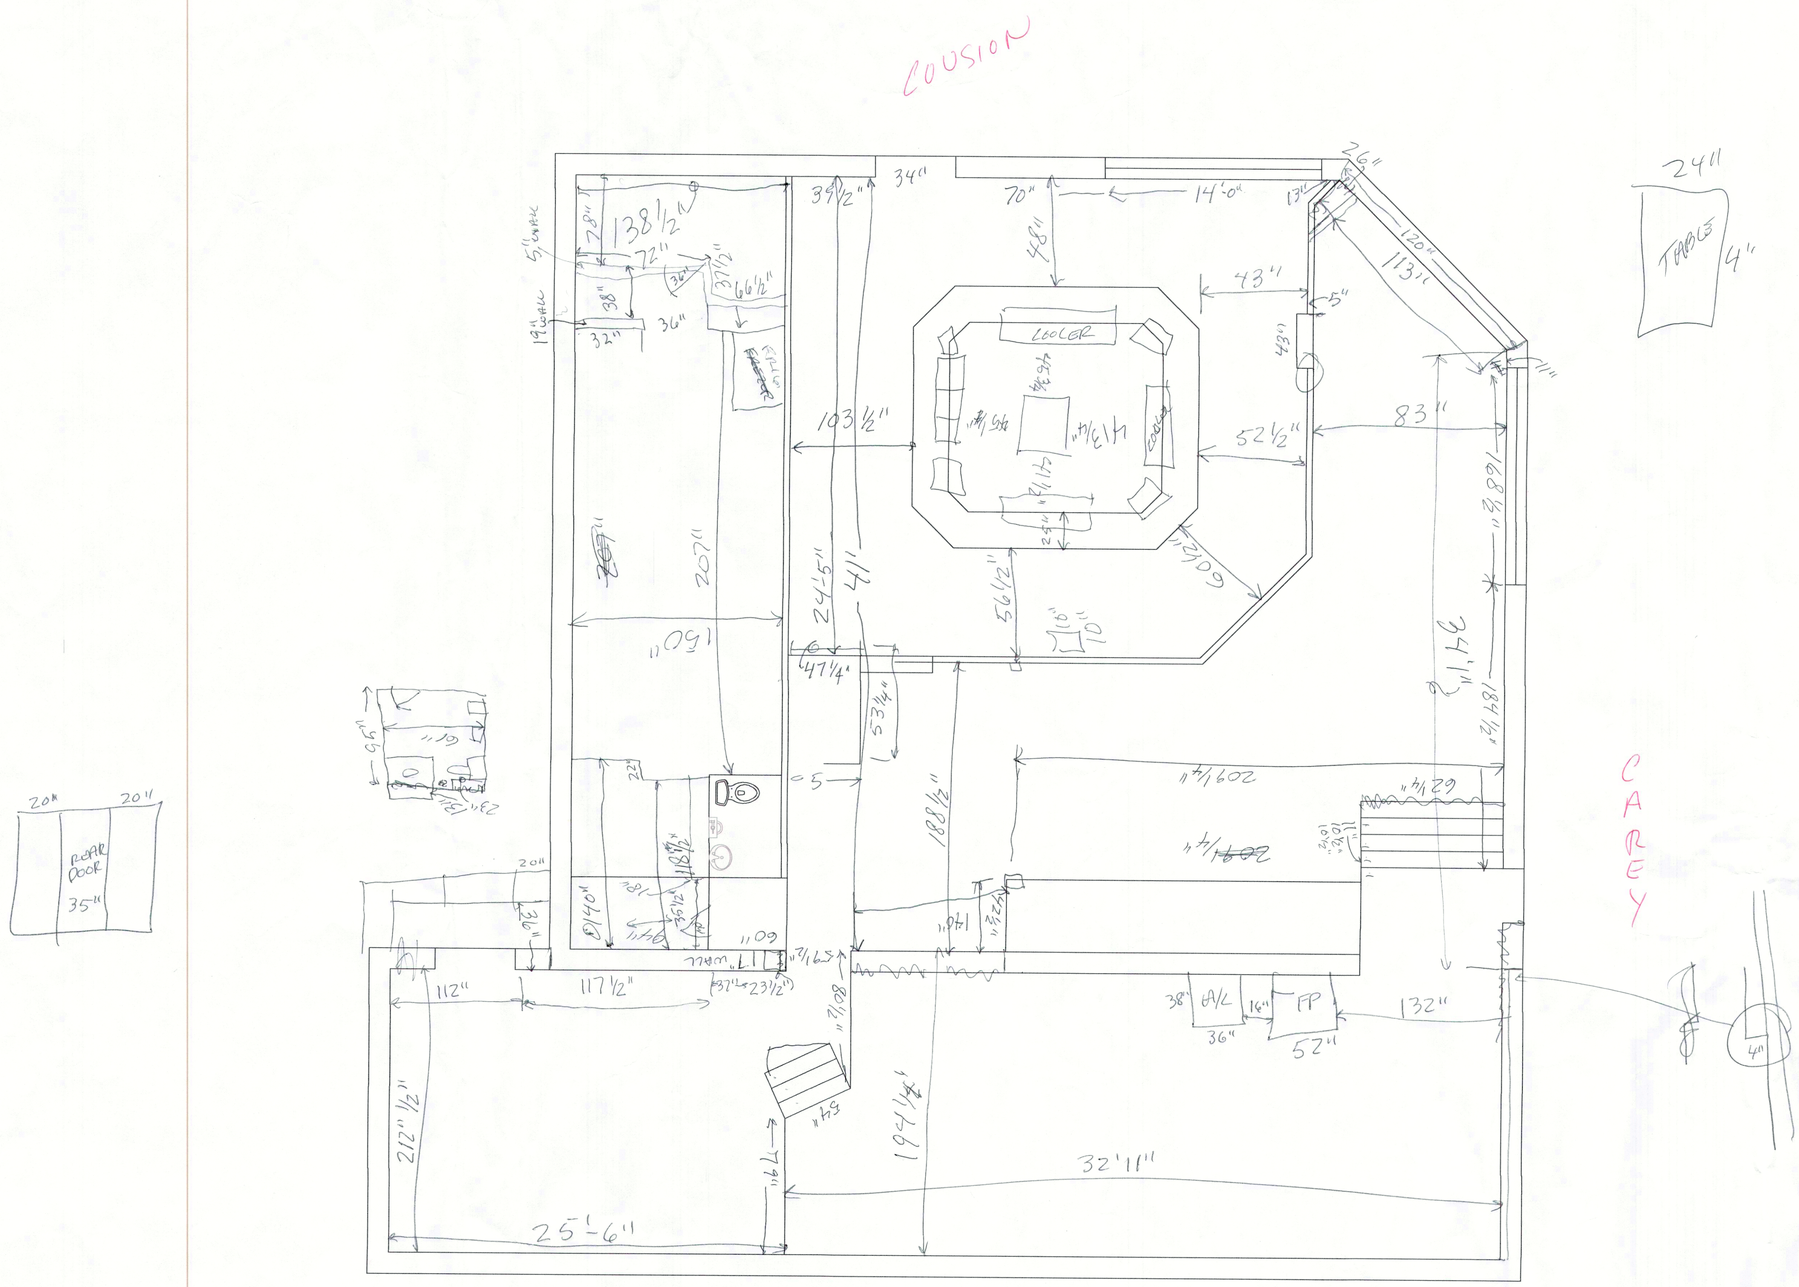

2 LEVEL ONE - EXISTING FLOOR PLAN
SCALE: 3/16" = 1'-0"

DAMMON ENGINEERING, INC.
LOUISIANA & MISSISSIPPI

www.dammonengineering.com
info@dammonengineering.com
PH: 985-649-3572

Chief Engineer: Brian Mistich, PE
554 Old Spanish Trail
Slidell, LA 70458

#	DESCRIPTION	DATE

REVISIONS

SEAL:

EXISTING BUILDING
HEIDELBERG'S
147 COUSIN STREET
SLIDELL, LA 70458

JOB No:	
DATE:	05-24-2024
DRAWN BY:	TNT
CHECKED BY:	JMS

The drawing, diagrams and specifications, design and all information contained herein, is the property of Dammon Engineering, Inc. and shall not be reproduced in whole or in part without written permission. Any project specific drawings and specifications prepared for a client, or project contractor, will only be released upon the specific request of the client or project contractor. Any other person or entity who obtains or uses drawings and specifications without the permission of Dammon Engineering, Inc. assumes all risk and agrees to indemnify Dammon Engineering, Inc. against all damages, liabilities or costs arising from such use.

SHEET TITLE:
EXISTING FLOOR PLAN

DRAWING NUMBER:
A101

SHEET No: 3 of 3