


AS INSTRUMENTS OF SERVICE, THESE DRAWINGS AND THE DESIGN REPRESENTED ARE THE PROPERTY OF RUBY TUESDAY INCORPORATED. REPRODUCTION OR USE OF THESE PROTOTYPE DRAWINGS OTHER THAN FOR GUIDE PURPOSES ONLY WITHOUT WRITTEN CONSENT IS PROHIBITED.

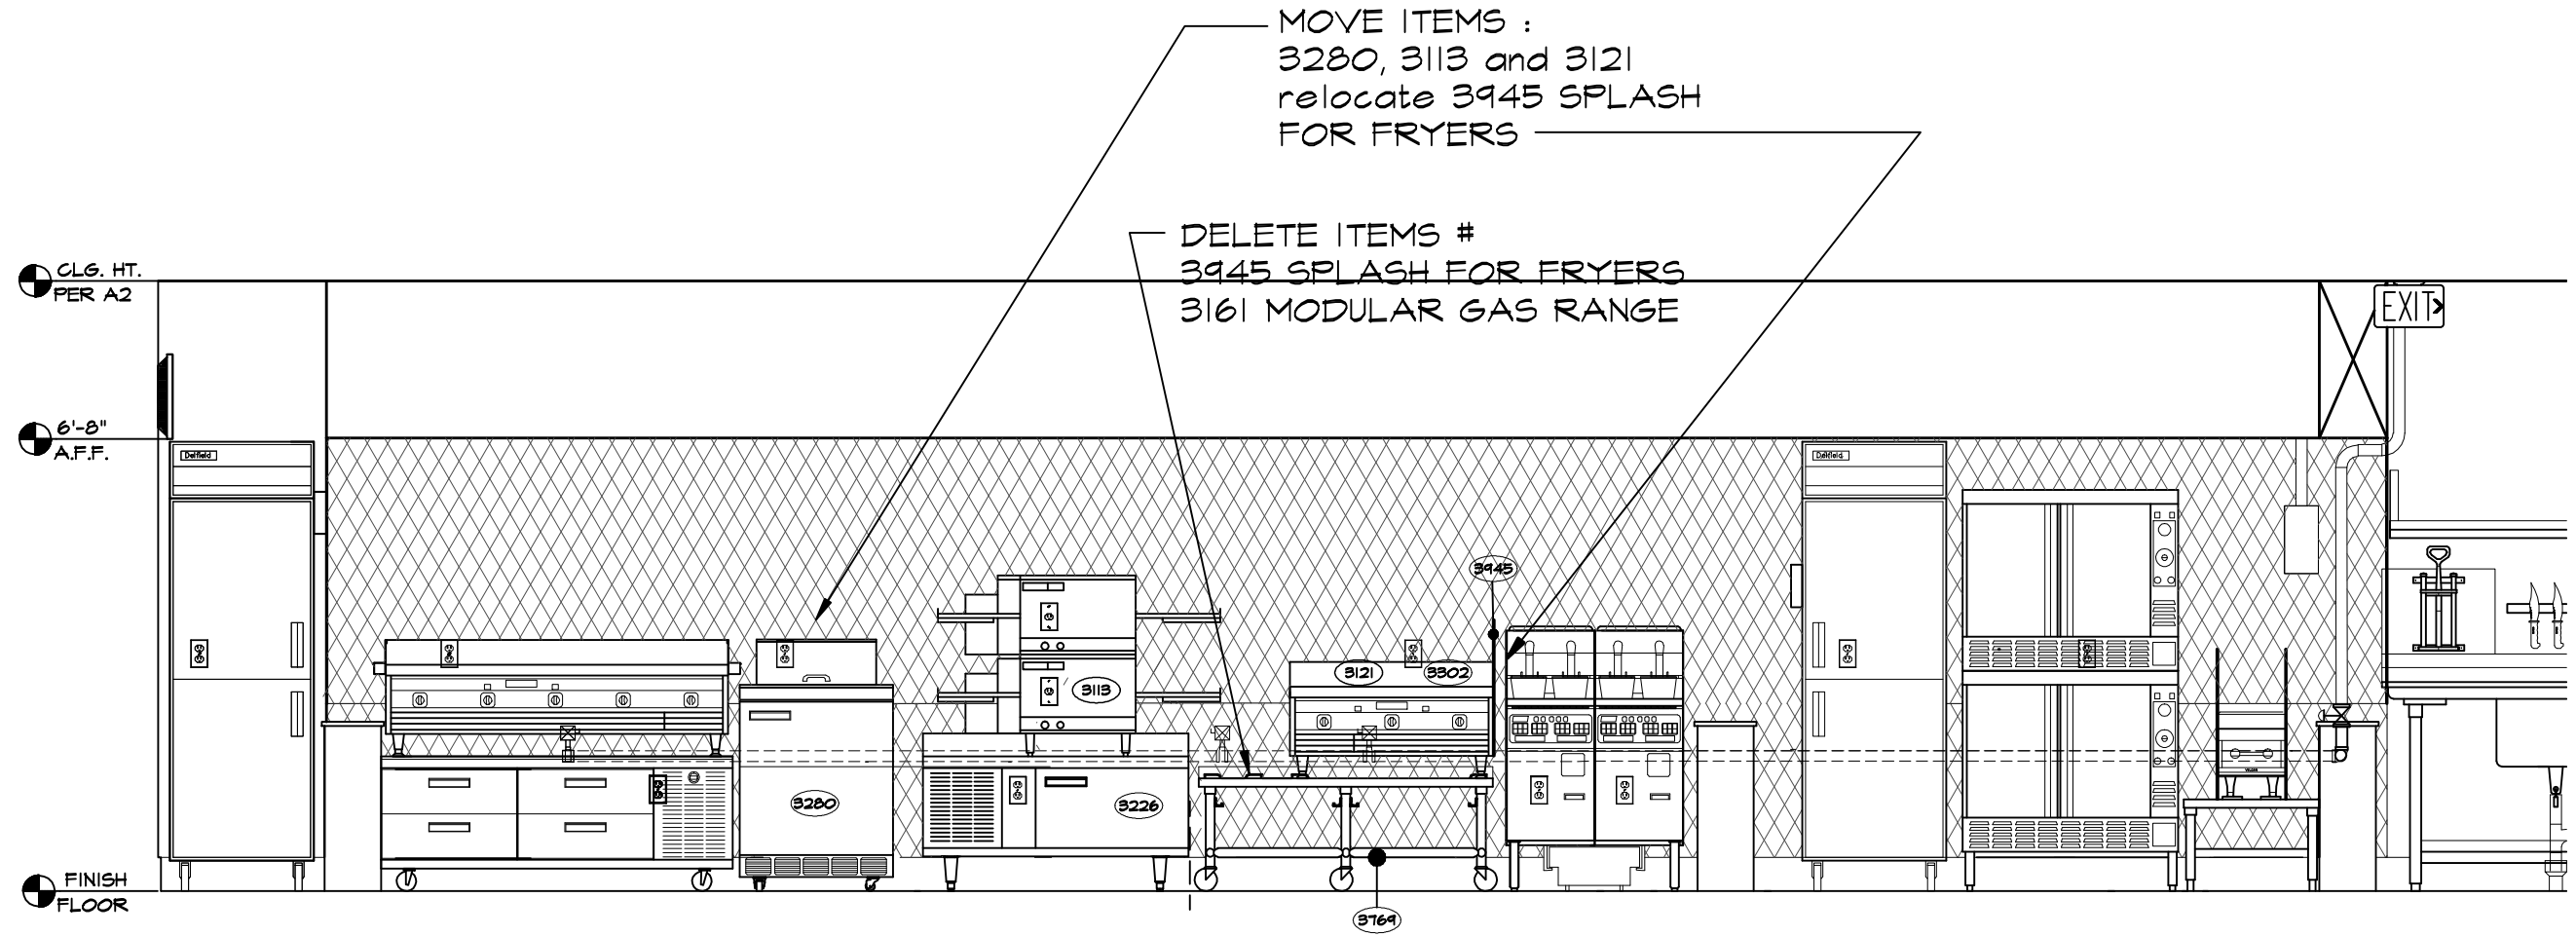

1 KITCHEN ELEVATION
K-5

Revised - Kitchen HOT LINE Elevation

Ruby Tuesday

TITLE: SLIDELL, LA HC 4734
PROPOSED COOKLINE CHANGE

DATE: 15 OCT 07
BULLETIN DRAWING NO. 323 02