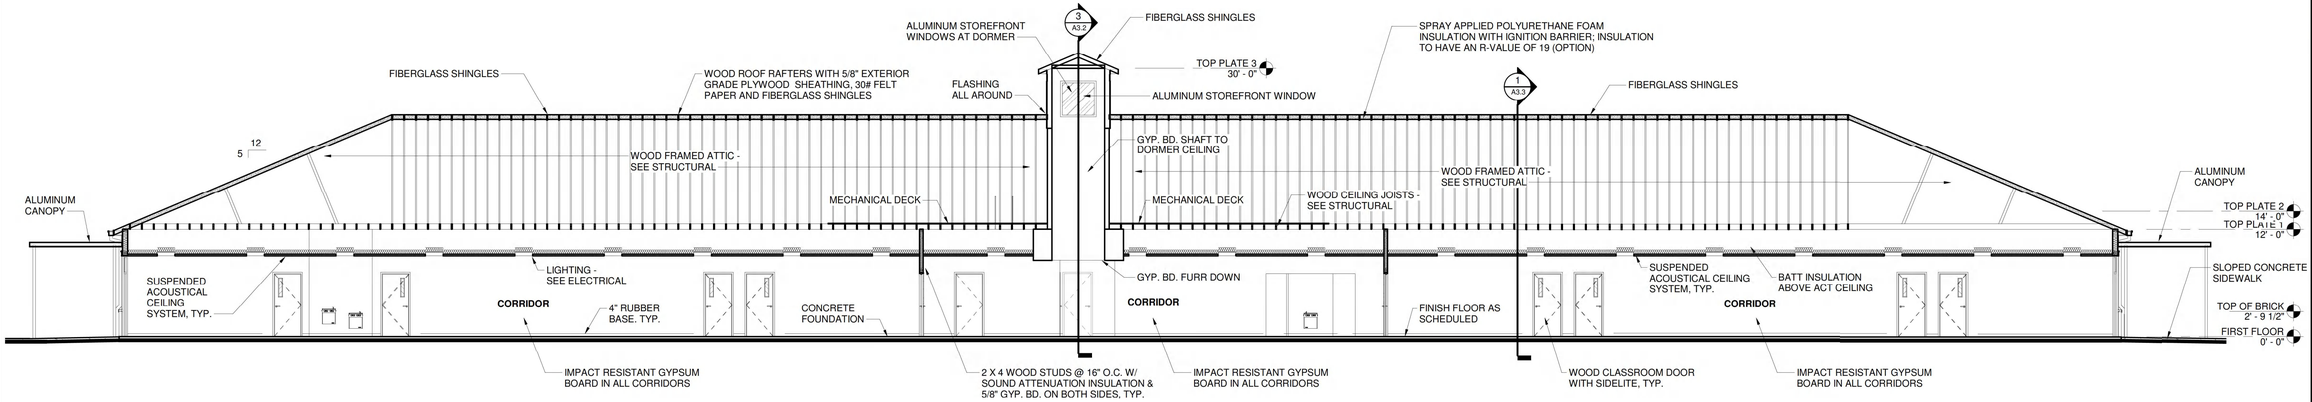

1 A3.2 BUILDING SECTION - LONGITUDINAL
1/8" = 1'-0"

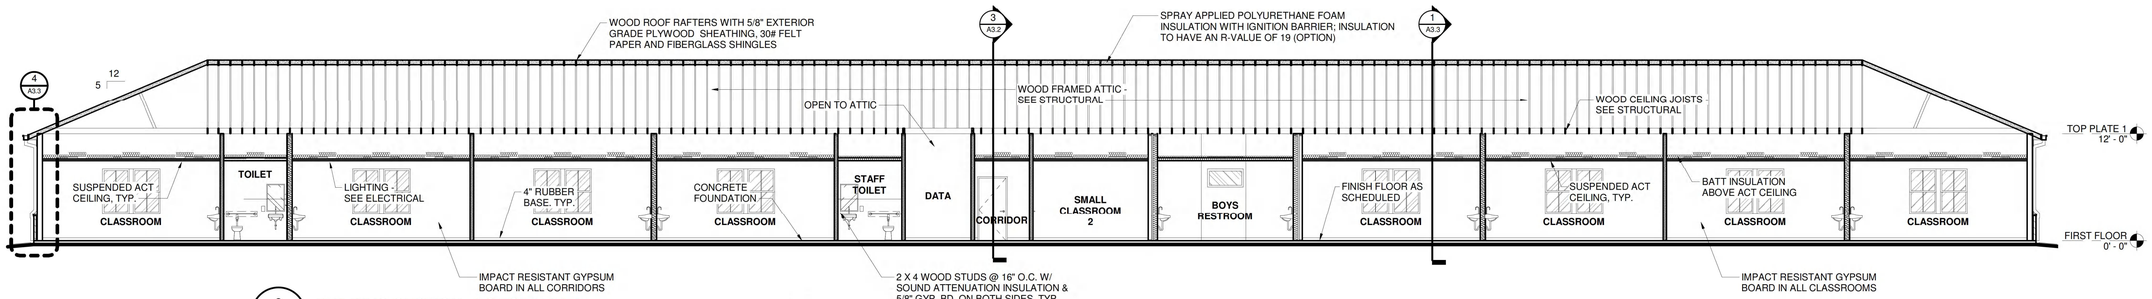

2 A3.2 BUILDING SECTION - LONGITUDINAL
1/8" = 1'-0"

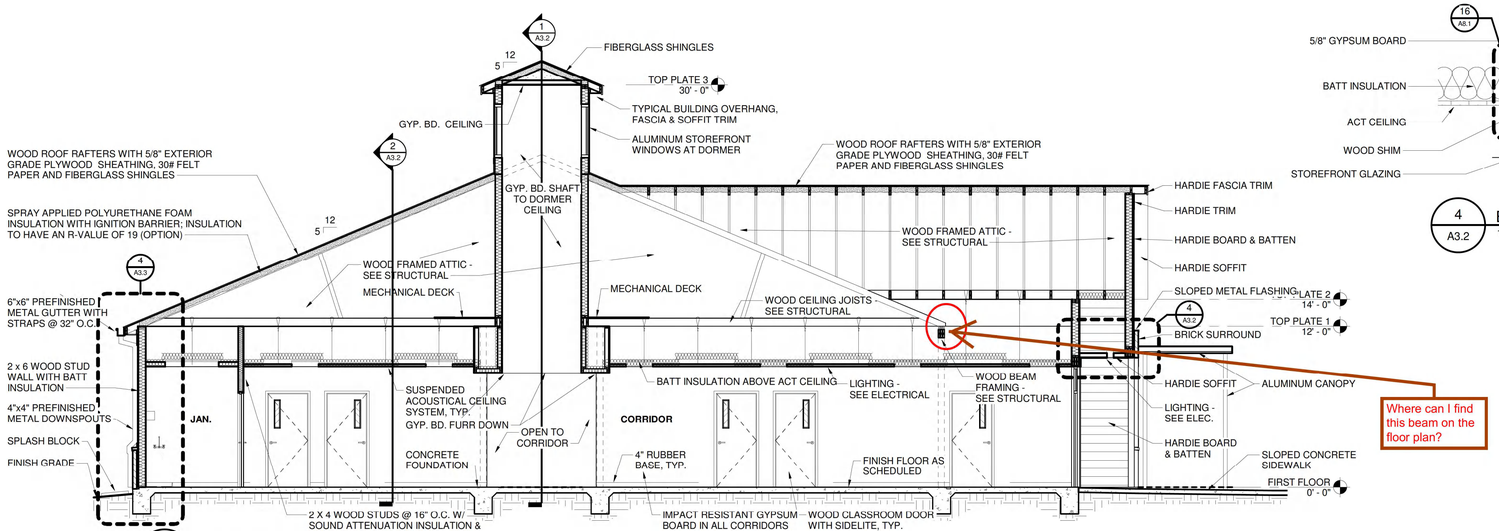

3 A3.2 BUILDING SECTION - TRANSVERSE
3/16" = 1'-0"

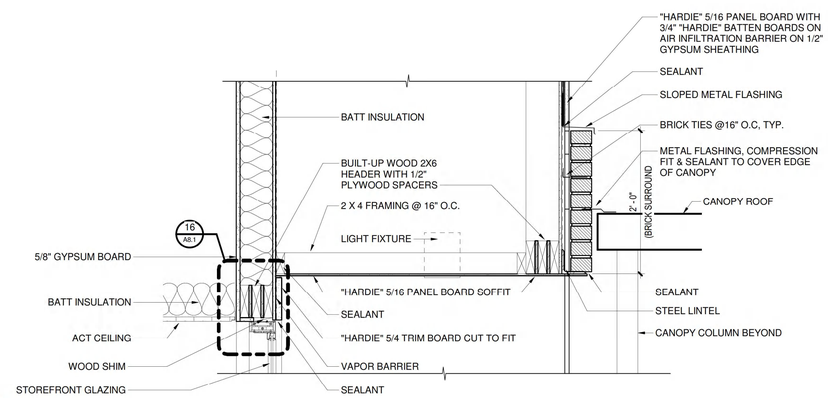

4 A3.2 ENTRANCE SOFFIT DETAIL
1" = 1'-0"

architecture
planning
interiors
sustainable design
consulting

fl+WB architects
404 GREENGATE DRIVE, SUITE 101
COVINGTON, LA 70433
985-893-4100
a professional corporation /continuous practice since 1981

DATE	ISSUE

LA KEY ACADEMY COVINGTON
NEW CLASSROOM BUILDING

PRIVETTE BOULEVARD
COVINGTON LA 70433

90% ARCHITECTURAL CD REVIEW SET

Date
10-19-2022

PRIVETTE BOULEVARD, COVINGTON, LA 70435

Key Plan

BUILDING SECTIONS

Job No. 222022.01

Drawn by MAH
Checked by KJW

A3.2
Sheet No.

THESE DRAWINGS ARE THE SOLE PROPERTY OF FLWB ARCHITECTS, APC AND ARE ISSUED AS INSTRUMENTS OF SERVICE. THESE DRAWINGS SHALL NOT BE COPIED, REPRODUCED OR USED IN ANY MANNER WITHOUT WRITTEN CONSENT OF FLWB ARCHITECTS, APC.