


21464 Clear Creek Dr.


Existing plumbing

Well water supply

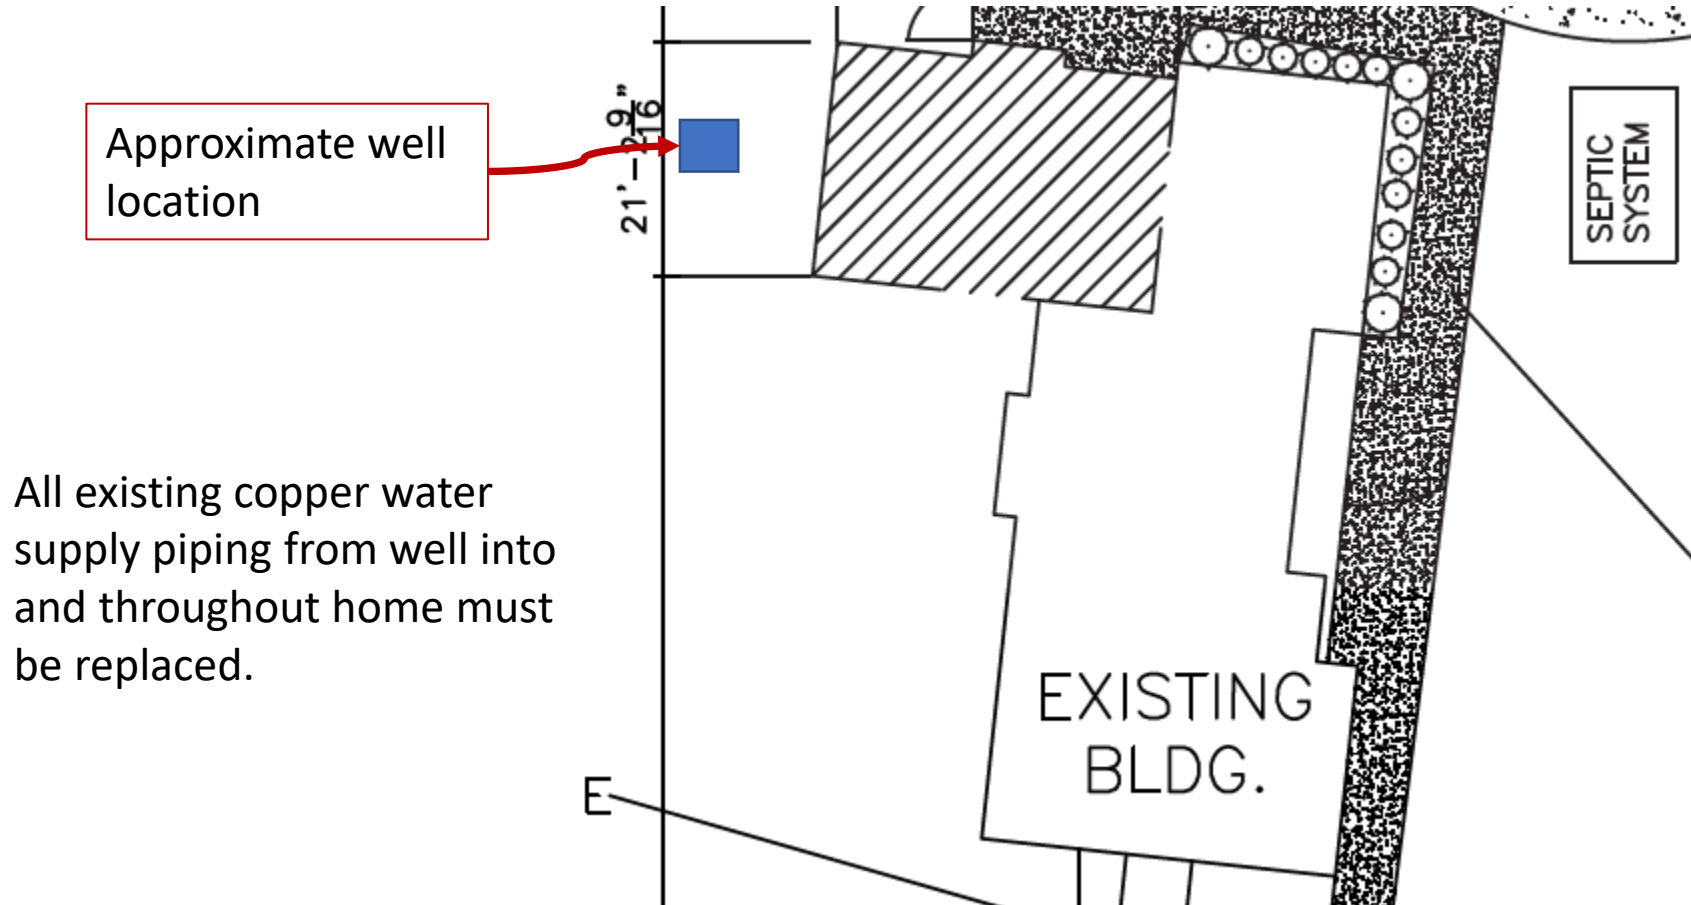

All existing copper water supply piping from well into and throughout home must be replaced.

Location of waste line into new septic tank

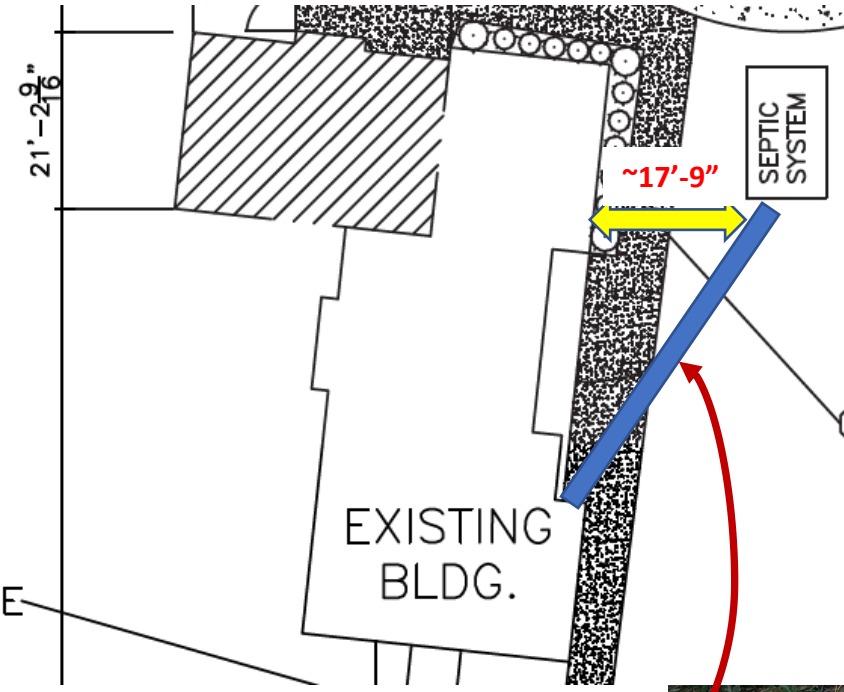

Location of existing sewer line from house



Interior existing waste lines from 2nd story bathroom

Cut Floor Joist



Kitchen sink waste line

