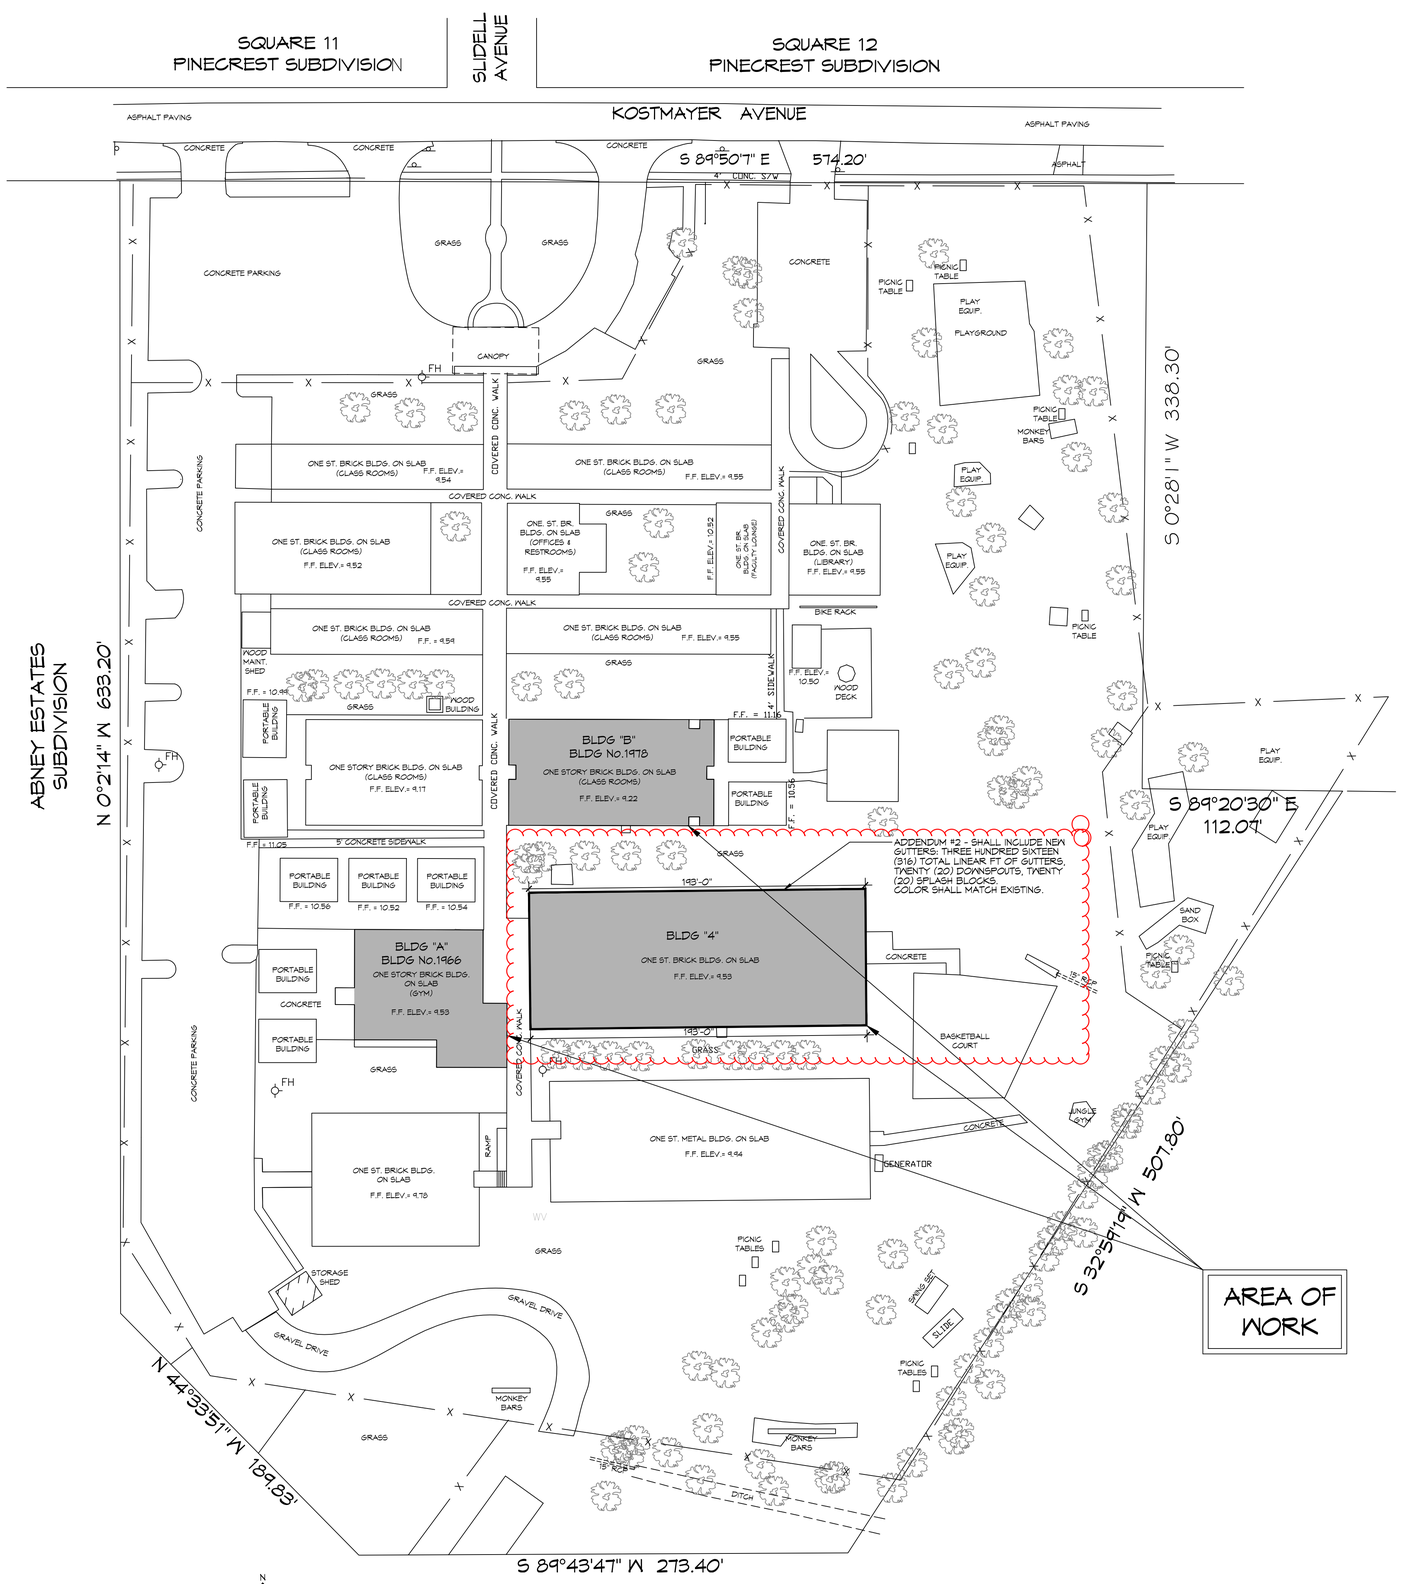

1 SITE PLAN
SCALE: 1"=40'-0"

ADDENDUM #2
SCALE: N.T.S.

DAMMON ENGINEERING, INC.
LOUISIANA & MISSISSIPPI

www.dammonengineering.com
info@dammonengineering.com
PH: 985.649.5052

Chief Engineer: Brian Mistich, PE
554 Old Spanish Trail
Slidell, LA 70458

REVISIONS

#	DESCRIPTION	DATE
1	ADDENDUM #2 ADDITIONAL GUTTERS BLDG 4	2/2/2018

SEAL:
STATE OF LOUISIANA
BRIAN A. MISTICH
License No. 30187
2/2/2018
PROFESSIONAL ENGINEER

REROOFING BUILDING "A & B"
ABNEY ELEMENTARY SCHOOL
835 KOSTMAYER AVE.
SLIDELL, LA. 70458

JOB No: 2335 | DATE: 12-21-17
DRAWN BY: CKD | CHECKED BY: BAM

SHEET TITLE:
SITE PLAN

DRAWING NUMBER:
C101

SHEET No: 2 of # 7