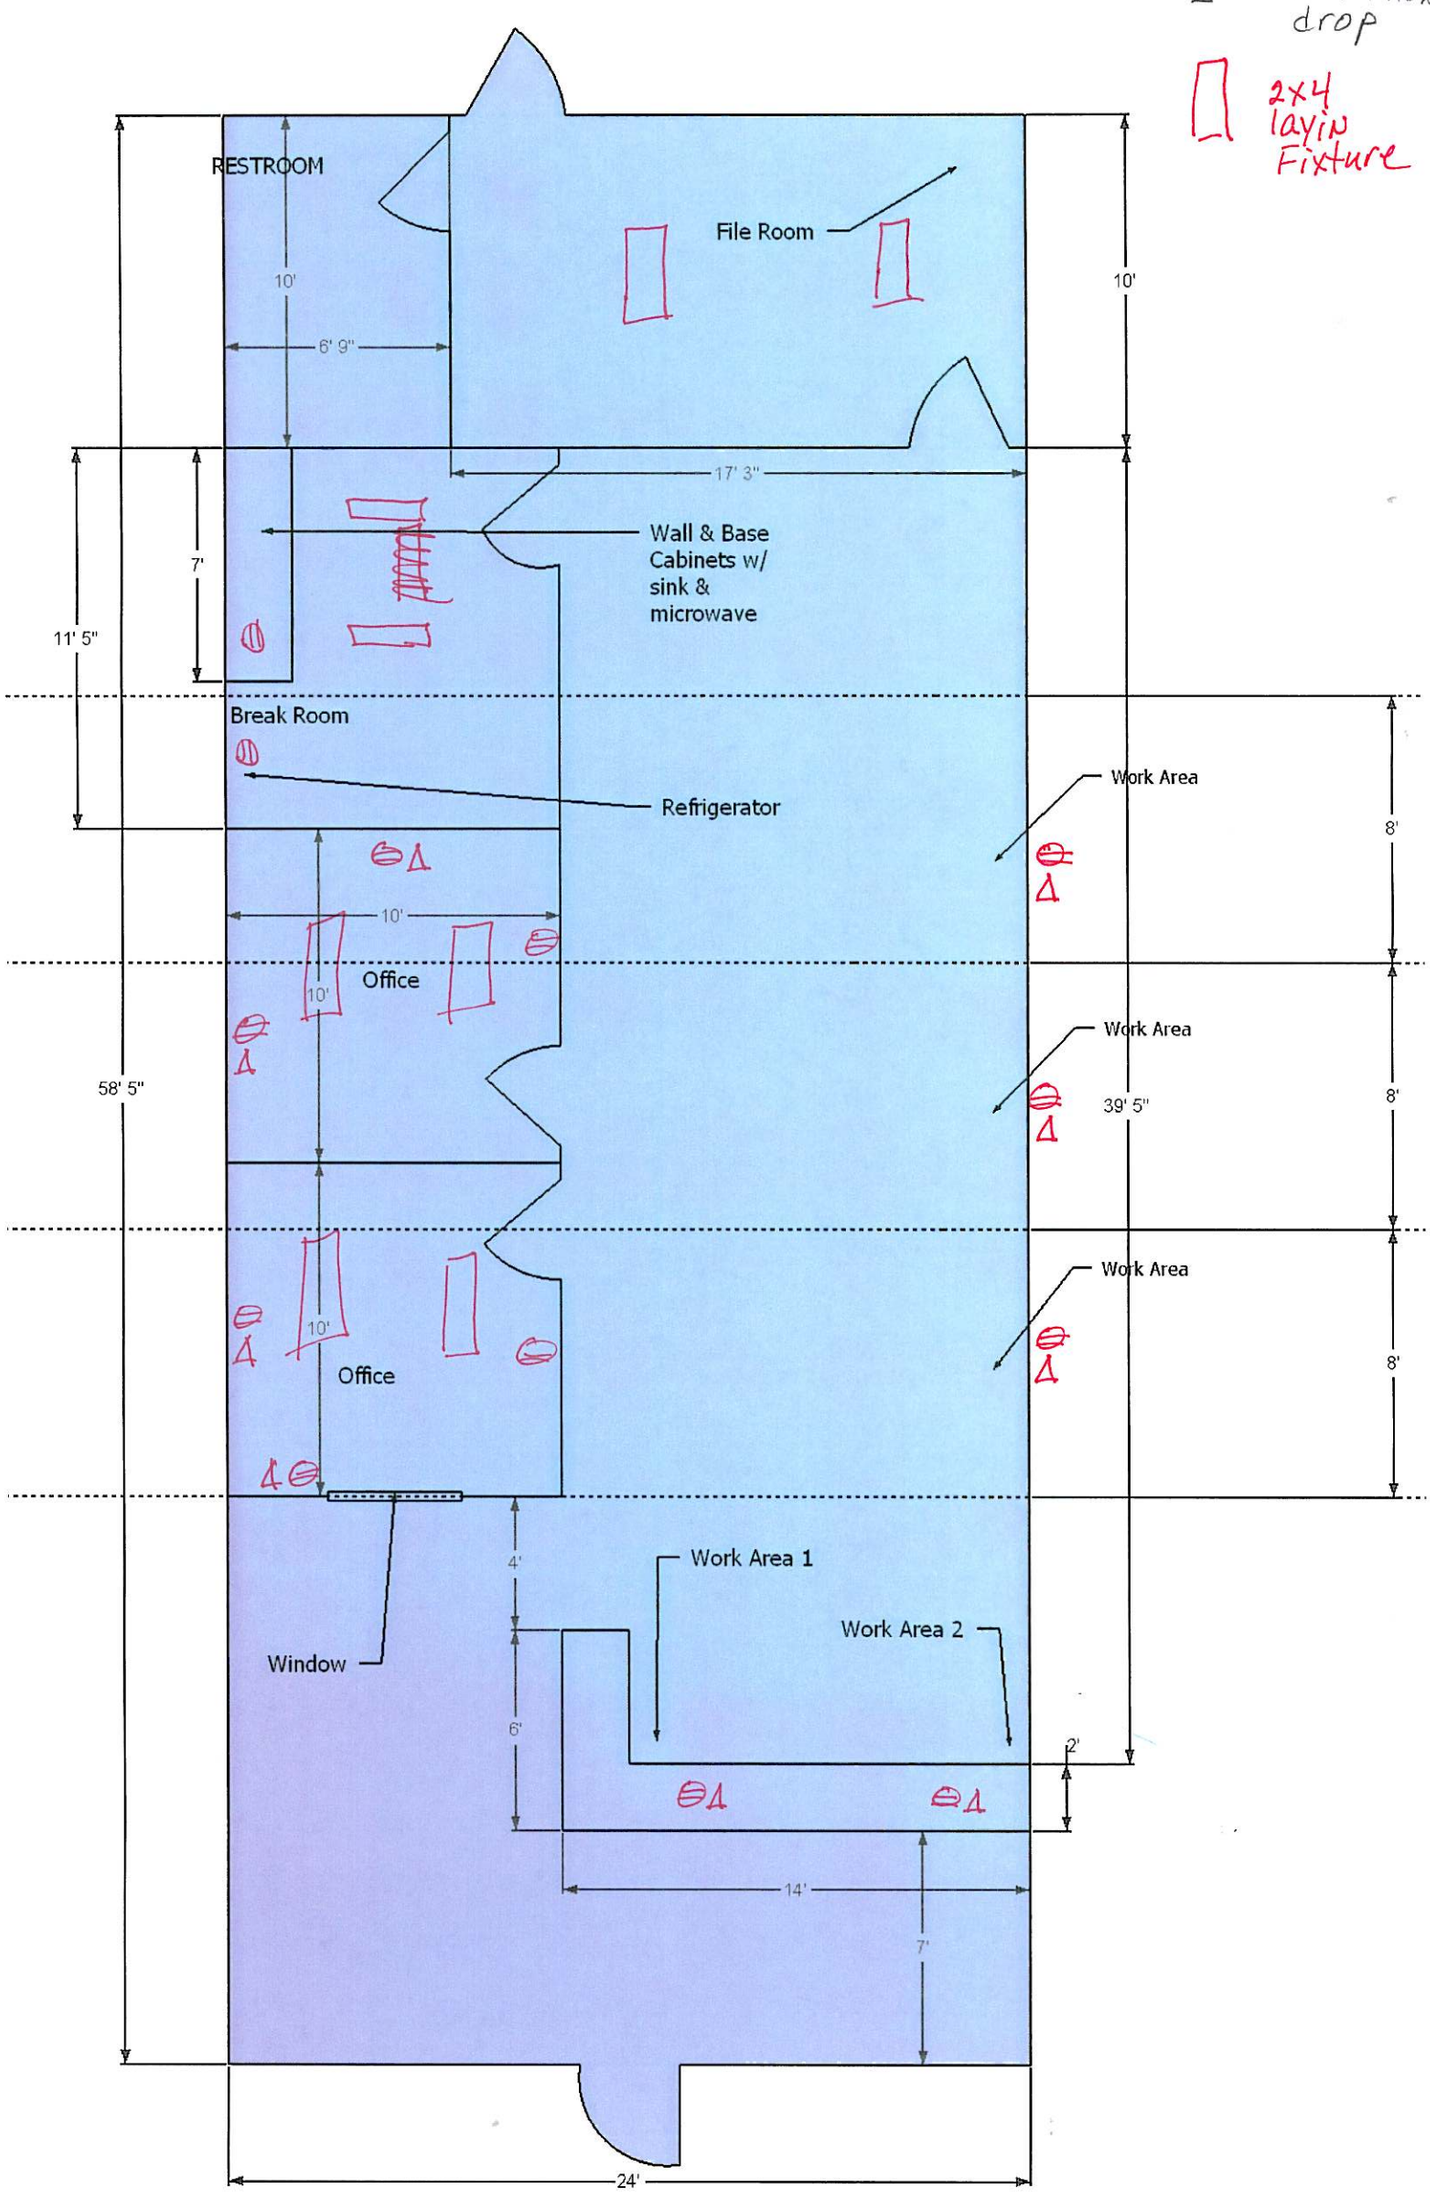⊖ duplex outlet
Δ Data + Phone drop
2x4 layin Fixture