

INSECT CONTROL UNIT LEGEND

BASED ON NUMBER OF UNITS RECEIVED. QUANTITY INDICATES IF STORE IS ON THE STANDARD OR ENHANCED INSECT CONTROL PROGRAM

TYPE	STANDARD/ENHANCED	TOTAL (A,B,C,E)
A/AE	3 / 7 0	3
B/BE	4 / 7 0	4
C/CE	2 / 7 0	2
TOTAL	9 / 7 0	9

ACTRON MODEL# AC-969
 ACTRON MODEL# GT-200
 MODEL# WS-225


A [Icon] B [Icon] C [Icon]
 AE-ENHANCED BE-ENHANCED CE-ENHANCED

NOTES:

- GC TO INSTALL TOP OF UNITS 60" ABOVE FLOOR UNLESS NOTED OTHERWISE
- PLUS UNITS FOR TYPE A, AE, B, AND BE UNITS AT LOCATIONS SHOWN ON PLAN UNLESS NOTED OTHERWISE

GENERAL NOTES

- RACK INSTALLER TO VERIFY SPACES TO PLACE ALL RACKS. INDICATED ON THE PLAN, IS A MINIMUM OF 4'-6". NOTIFY THE RACK VENDOR IF THIS CLEARANCE CANNOT BE MAINTAINED.

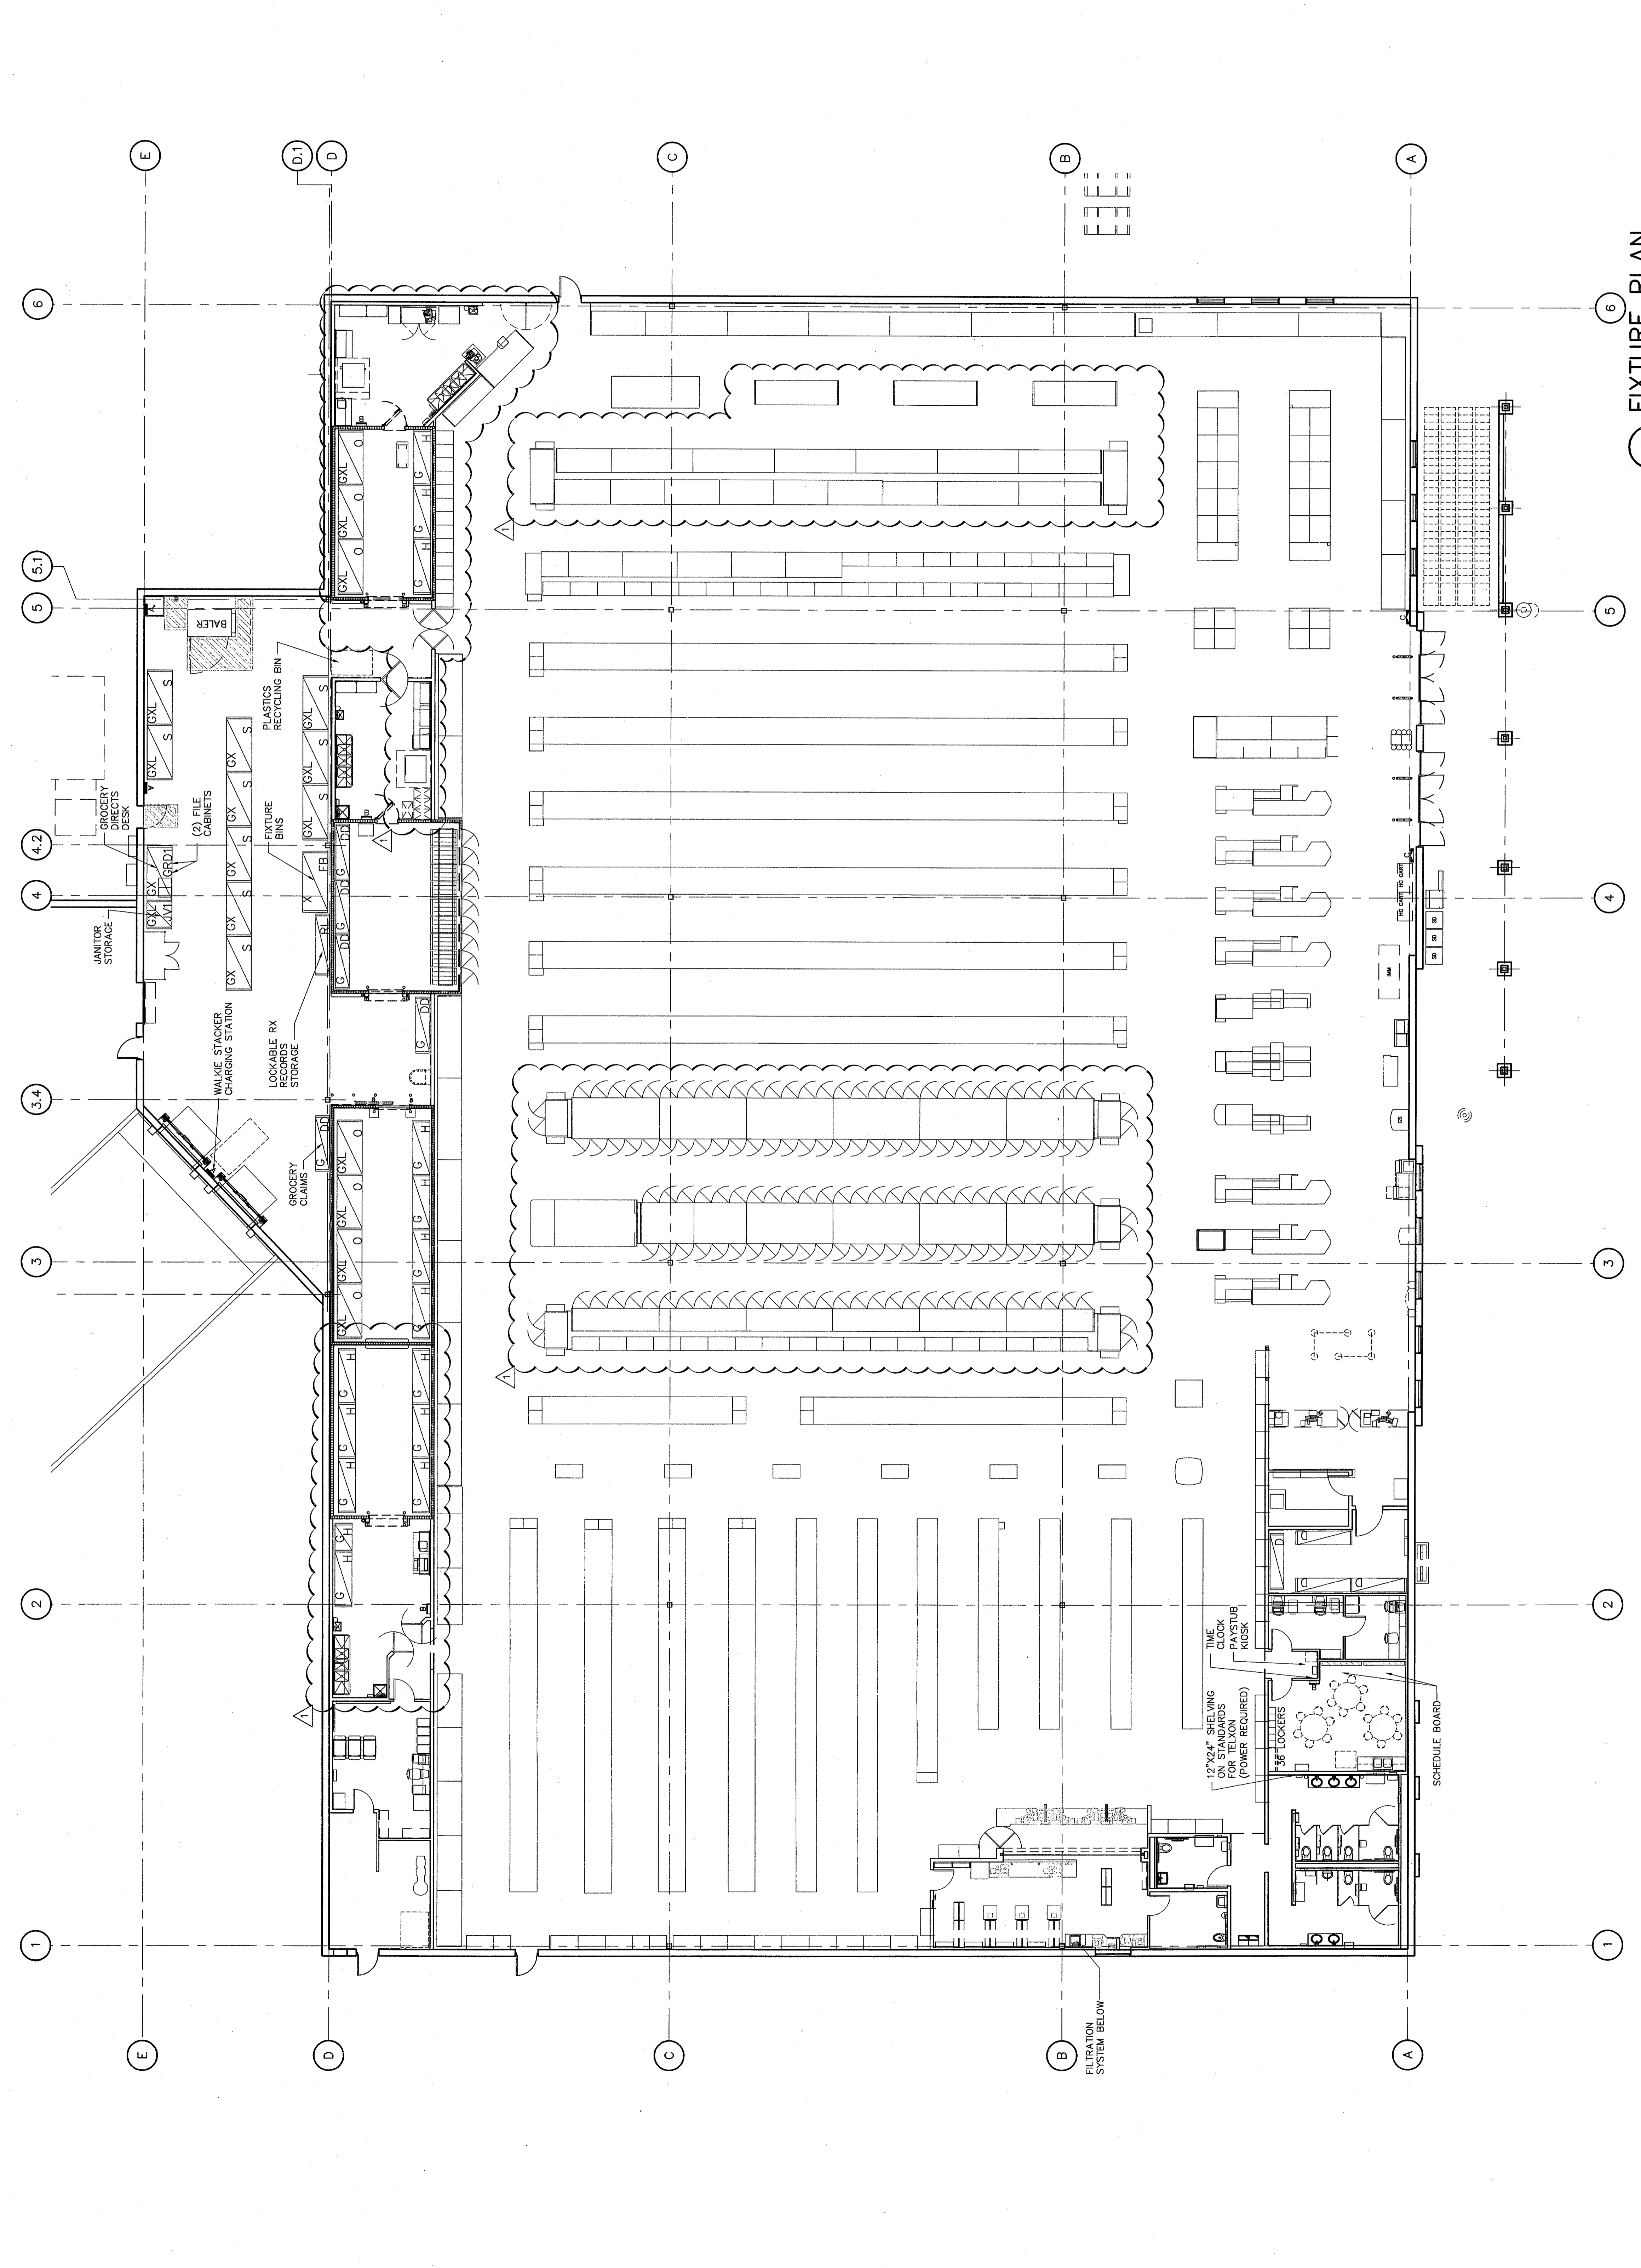

1 FIXTURE PLAN
 1"=10'-0" 072911 FX01C-001-F