

OCCUPANCY LOAD CALCULATIONS 2009 IBC WITH IBC 101 LIFE SAFETY
 REQUIRED FLOOR AREA = (OCCUPANCY LOAD) x (GROSS WIDTH FACTOR)
 OCCUPANCY LOAD FACTOR = REFER TO OCCUPANCY LOAD FACTOR TABLE

AREA	AREA (S.F.)	OCCUPANCY LOAD	MODEL FACTOR	REQUIRED WIDTH	WIDTH PROVIDED	DOORS, NUMBERS AND SIZES

TOTAL NET FLOOR AREA = 40,027 S.F.

SHEET NOTES

1. MAINTAIN A MINIMUM OF 3'-0" AISLE WIDTH ON THE SALES FLOOR WHERE MERCHANDISE OR OTHER OBSTRUCTIONS ARE PRESENT. THE AISLE WIDTH SHALL BE 3'-0" MINIMUM. SUCH OBSTRUCTIONS ARE TO BE PLACED ON BOTH SIDES OF THE AISLE.
2. ALL EXIT SIGNS AND EMERGENCY LIGHTS ARE SHOWN ON SHEET E1, (SYMBOL, LEGEND ON E3), AND WILL BE SUBJECT TO INSPECTION FROM THE FIRE MARSHAL HAVING AUTHORITY PRIOR TO FINAL APPROVALS.
3. 250' MAX. TRAVEL DISTANCE IS SHOWN AS A DASHED LINE.

LEGEND

- (E) FIRE EXTINGUISHER
- (K) TYPE FIRE EXTINGUISHER (WITHIN 30 FT OF EACH COOKING APPLIANCE EQUIPMENT WITHIN A HOOD SYSTEM)
- (E) TACTILE EXIT SIGNAGE

STIPULATION FOR REUSE
 THE DRAWING WAS PREPARED FOR THE PROJECT AND IS NOT TO BE REUSED FOR ANY OTHER PROJECT WITHOUT THE WRITTEN PERMISSION OF THE ARCHITECT.
 ARCHITECT: B|R|B ARCHITECTURE
 9700 ANTHONY PLACE, SUITE 300, MERRILL KENNETHS 65034

Walmart Market
 COVINGTON, LA
 STORE NO. 3042-00
 JOB NUMBER: 97120128
 STORE NO. 3042-00
 PROTO: 41


ISSUE BLOCK
 02/09/12/REV #/3

CHECKED BY: [Signature]
 DRAWN BY: CC
 FILE NAME: 41-A010
 PHOTO CYCLE: 072811
 DOCUMENT DATE: 09/21/11



LIFE SAFETY PLAN
 (NOT IN BID SET)

SHEET: LS1

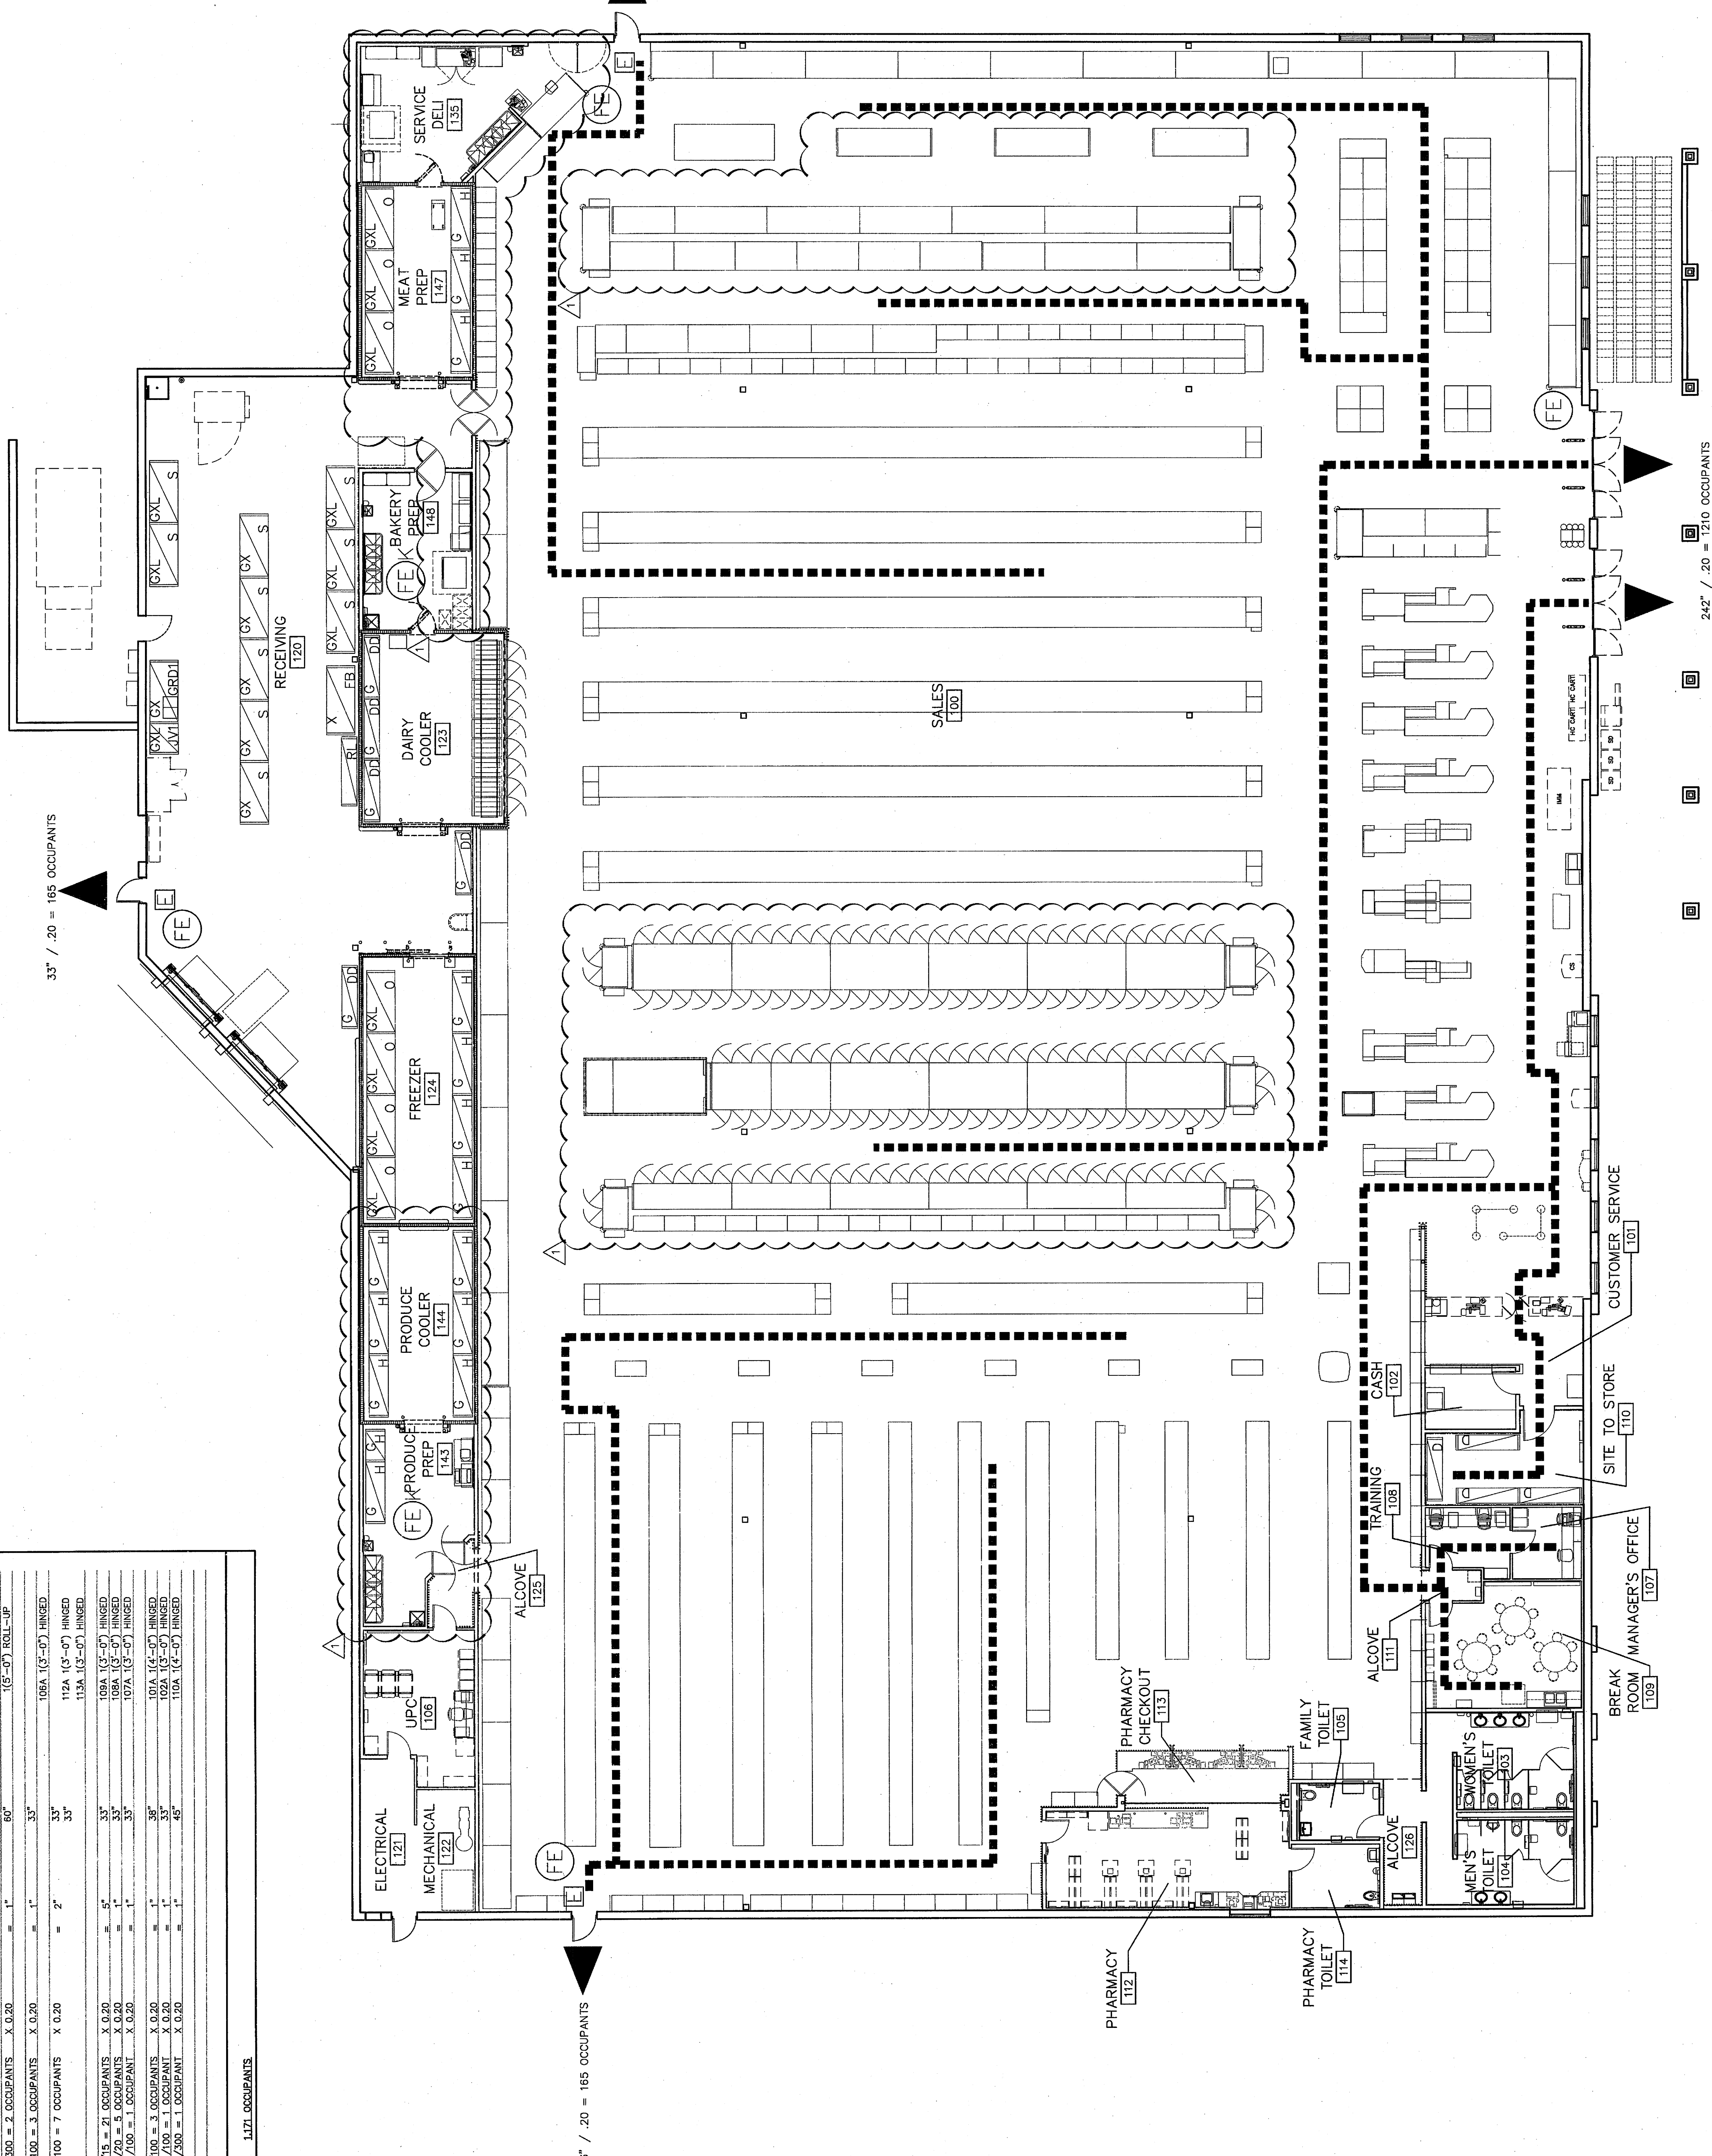

1 LIFE SAFETY PLAN
 1" = 10'-0"
 LS100-001-F