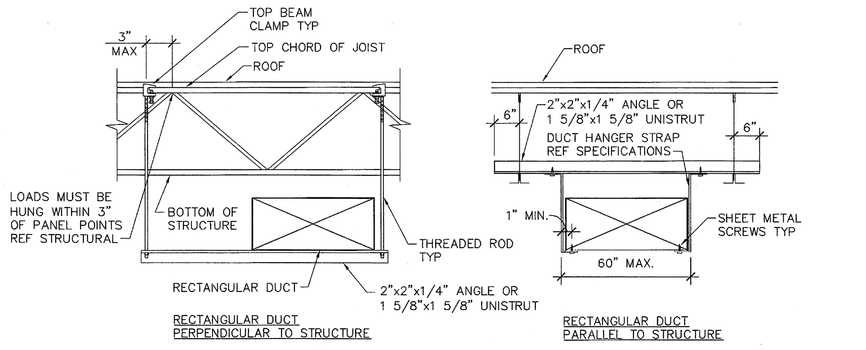

4 DUCT SUPPORT
NTS 04.24.09 MM01

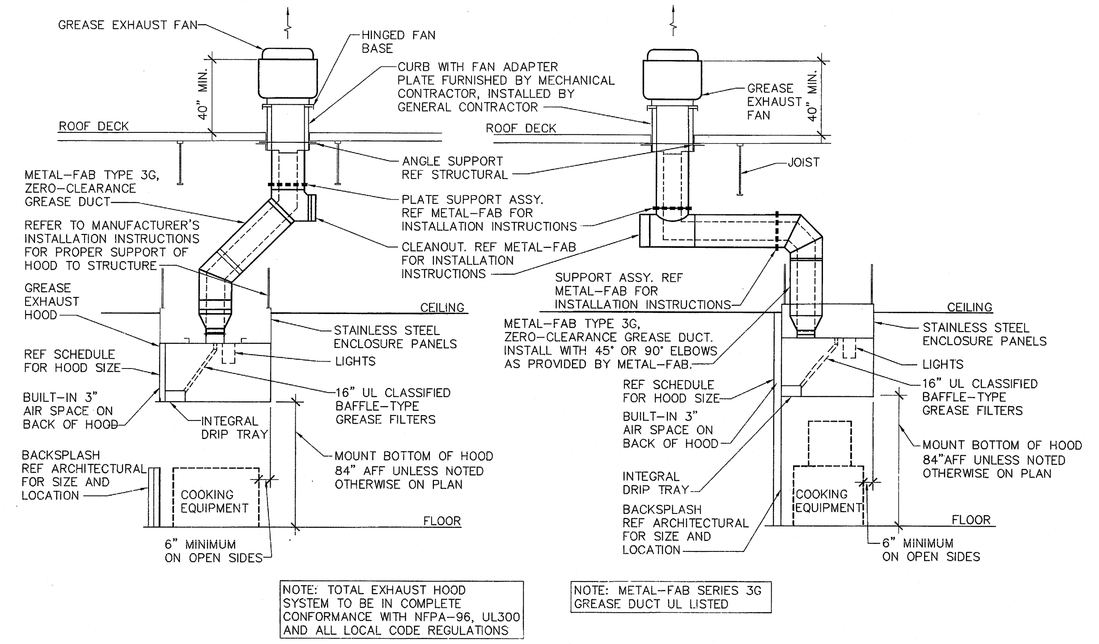

5 EXHAUST HOOD
NTS 10.30.09 MM26-NHM

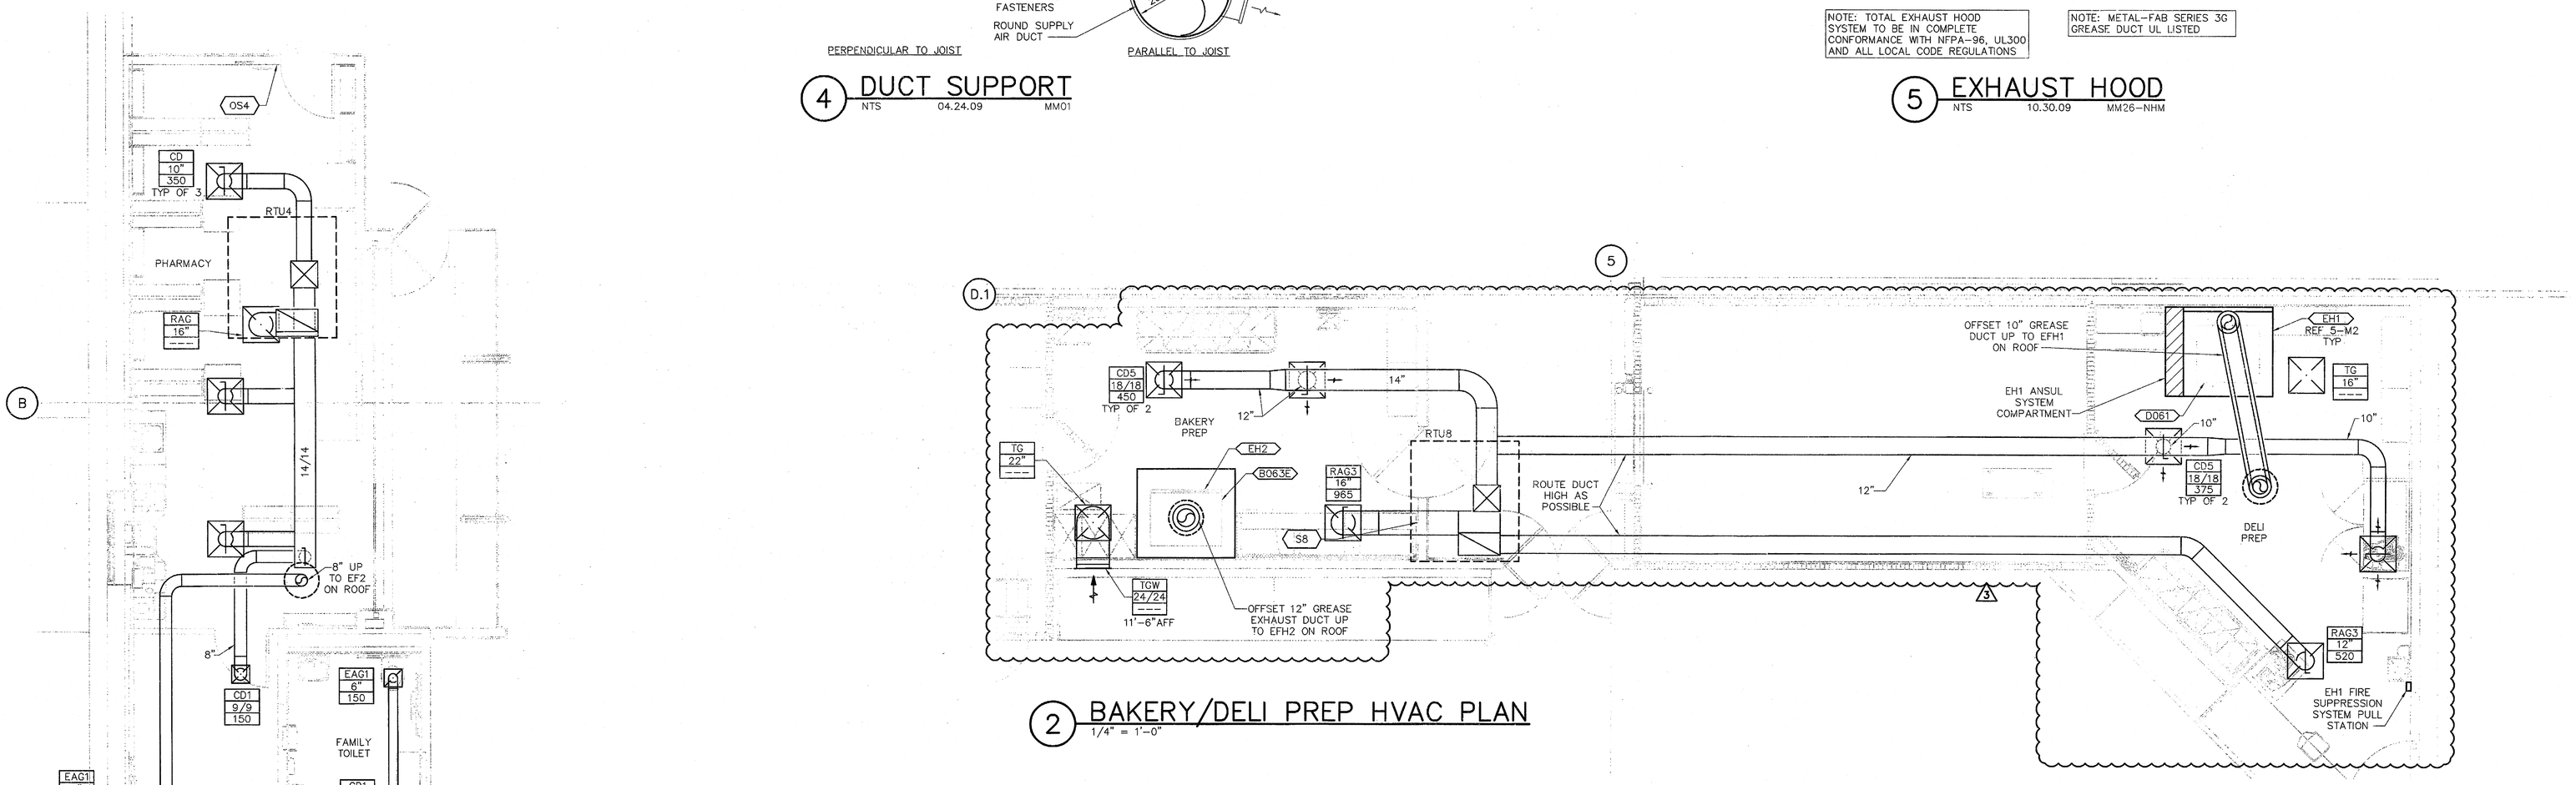

2 BAKERY/DELI PREP HVAC PLAN
1/4" = 1'-0"

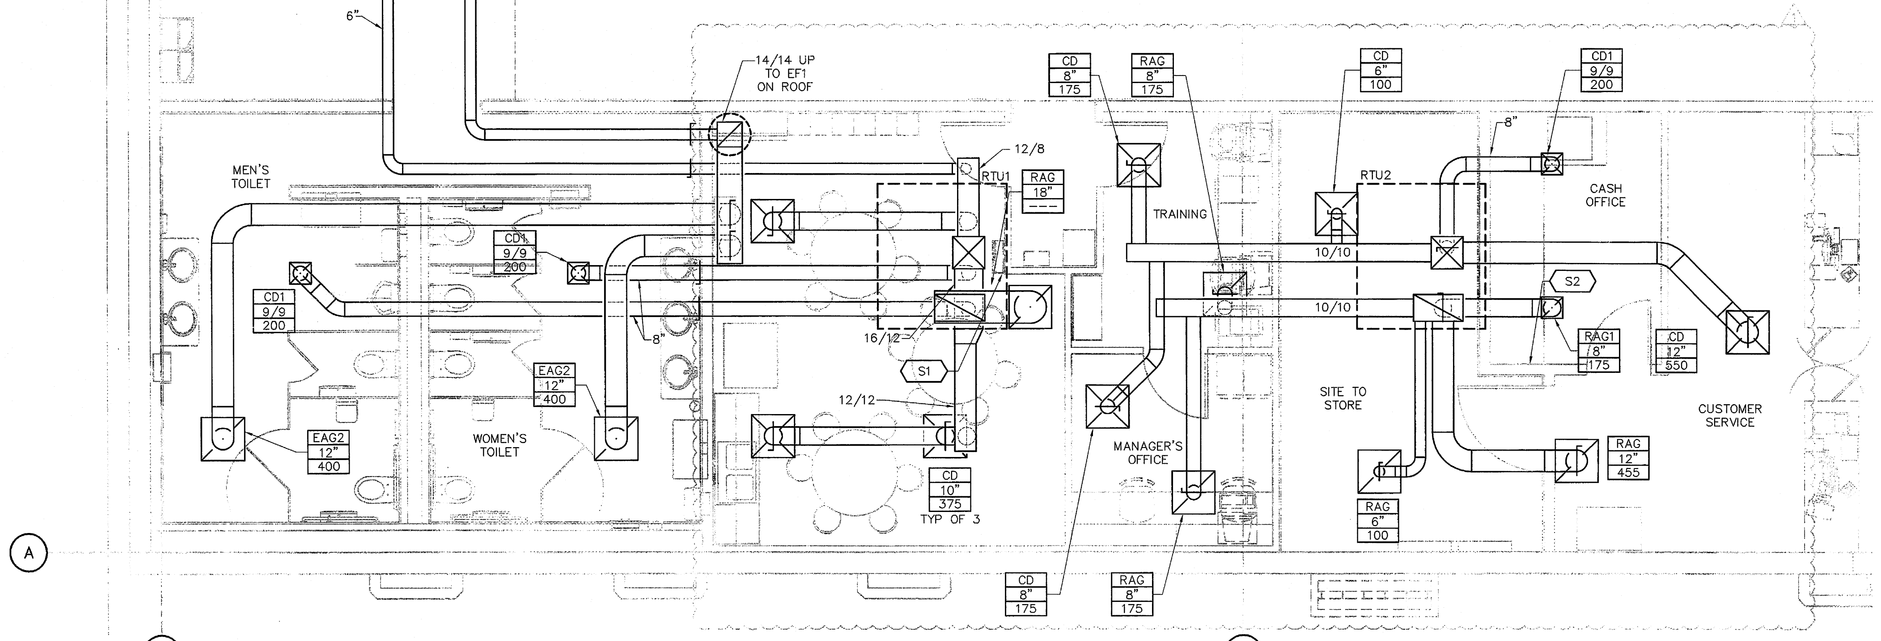

1 RESTROOM/OFFICE/PHARMACY HVAC PLAN
1/4" = 1'-0"

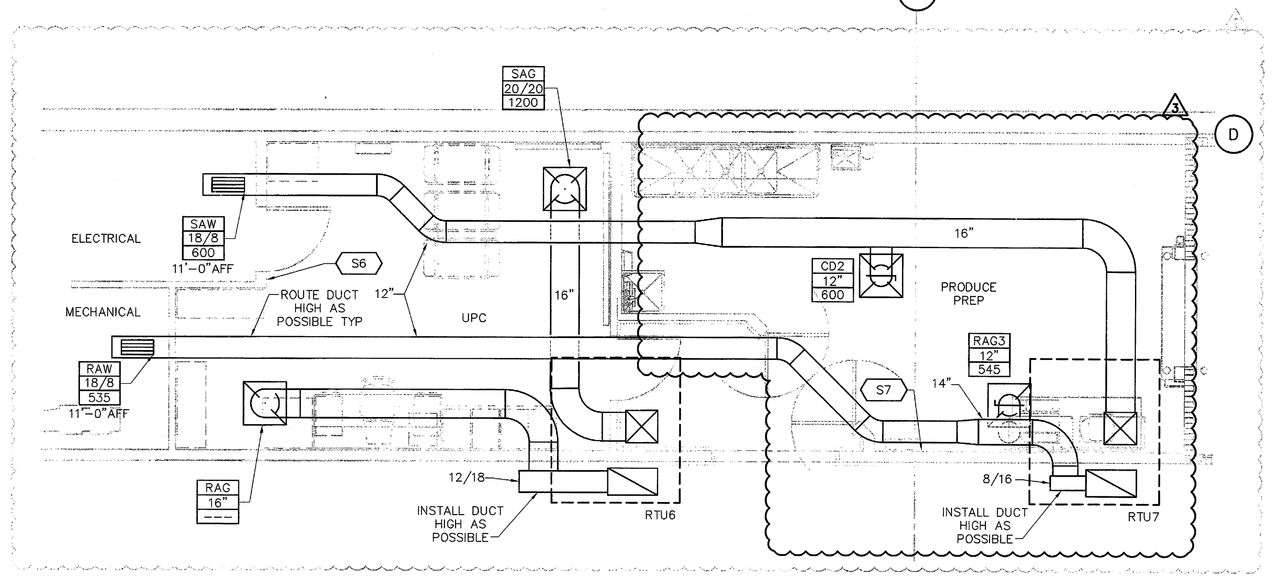

3 ELECTRICAL/UPC/PRODUCE PREP HVAC PLAN
1/4" = 1'-0"

CONSULTANTS
HENDERSON ENGINEERS
8325 LINEAR DRIVE
LESLIE, KS 66217
TEL 913.742.6000 FAX 913.742.5001
www.hei-eng.com
129 LIFEPAC
LA CERTIFICATE NO. 29594
EXPIRES 05/31/13

STIPULATION FOR REUSE
THIS DRAWING WAS PREPARED FOR USE ON A SPECIFIC SITE AT COVINGTON, LA. REUSE OF THIS DRAWING WITH ITS SOLE DATE ON 09/27/11 IS LIMITED TO THAT PROJECT AND SITE ONLY. ANY REUSE OF THIS DRAWING WITHOUT THE EXPRESS WRITTEN AND APPROPRIATE PROJECT RELEASES THE ARCHITECT AND ENGINEER OF RECORD AS ARCHITECTS AND ENGINEERS FROM ANY AND ALL LIABILITY RELATING TO OR ARISING FROM SUCH REUSE OR ANYONE WHO CAUSES OR PERMITS THE REUSE. THIS PLAN MAY NOT BE COPYRIGHTED TO THE LAW.

Walmart
Market
COVINGTON, LA
STORE NO. 3042-00
JOB NUMBER: 9712012B | PROTO: 41

ISSUE BLOCK		
	11/11/11	REV. #1
	12/22/11	REV. #2
3	02/09/12	REV. #3

CHECKED BY:	WES
DRAWN BY:	BLB
FILE NAME:	M2
PROTO CYCLE:	072911
DOCUMENT DATE:	092111

SCOTT JOSEPH JACK
License No. 34602
PROFESSIONAL ENGINEER
2/11/12

ENLARGED HVAC PLANS AND DETAILS

SHEET: M2

W:\Stores\03XX\lo.03XX9\03042 - COVINGTON - LA\12911B\03-CD Copy\dwl LA 3042-00000\mechdwl03120 - M2 ENLARGED HVAC PLANS AND DETAILS - 3042.dwg, Plot, 2/9/2012 2:35:39 PM, scottjack\bluebeam 1:1
SCOTT J. JACK