

**SHEET NOTES**


- ALL CONCRETE STOOPS ARE TO BE 4" THICK AND SLOPE 2% AWAY FROM BUILDING. SLOPE TO BE MAINTAINED THROUGHOUT THE LIFE OF THE STOO. MINIMUM TO BE MAINTAINED THROUGHOUT THE LIFE OF THE STOO.
- ALL EXTERIOR SIDEWALK JOINTS TO BE FILLED. REF SPECS
- REFER TO SHEET A7 FOR SCHEDULE FINISH REF SPECS

**KEYNOTES**

- CONCRETE STOO
- CONCRETE CURB REF 9-SF2
- CONCRETE TRANSFORMER PAD. REF CIVIL DRAWINGS FOR LOCATION, COORDINATE, SIZE, REINFORCING AND THICKNESS WITH LOCAL UTILITY
- DETECTABLE WARNING AREA
- CONCRETE CURB - PAINT ON FACE AND 6" ON TOP
- PAINTED 6" PIPE BOLLARD
- 6" PIPE BOLLARD WITH GREEN ELASTIC SLEEVE (COLOR TO MATCH PMS 386C) (HEIGHT OF SLEEVE NOTED BESIDE KEYNOTE)
- METAL DOWNSPOUT, PAINTED, UNO (SIZE NOTED BESIDE KEYNOTE)
- FLAGPOLE REF 6-SF2

**SITE AMENITIES**

SYMBOL	QTY.	DESCRIPTION
○	7	SLEAVED PIPE BOLLARD REF SPECS
□	1	BIKE RACK REF SPECS
⊙	1	TRASHCAN REF SPECS
⊞	2	PICNIC TABLE REF SPECS

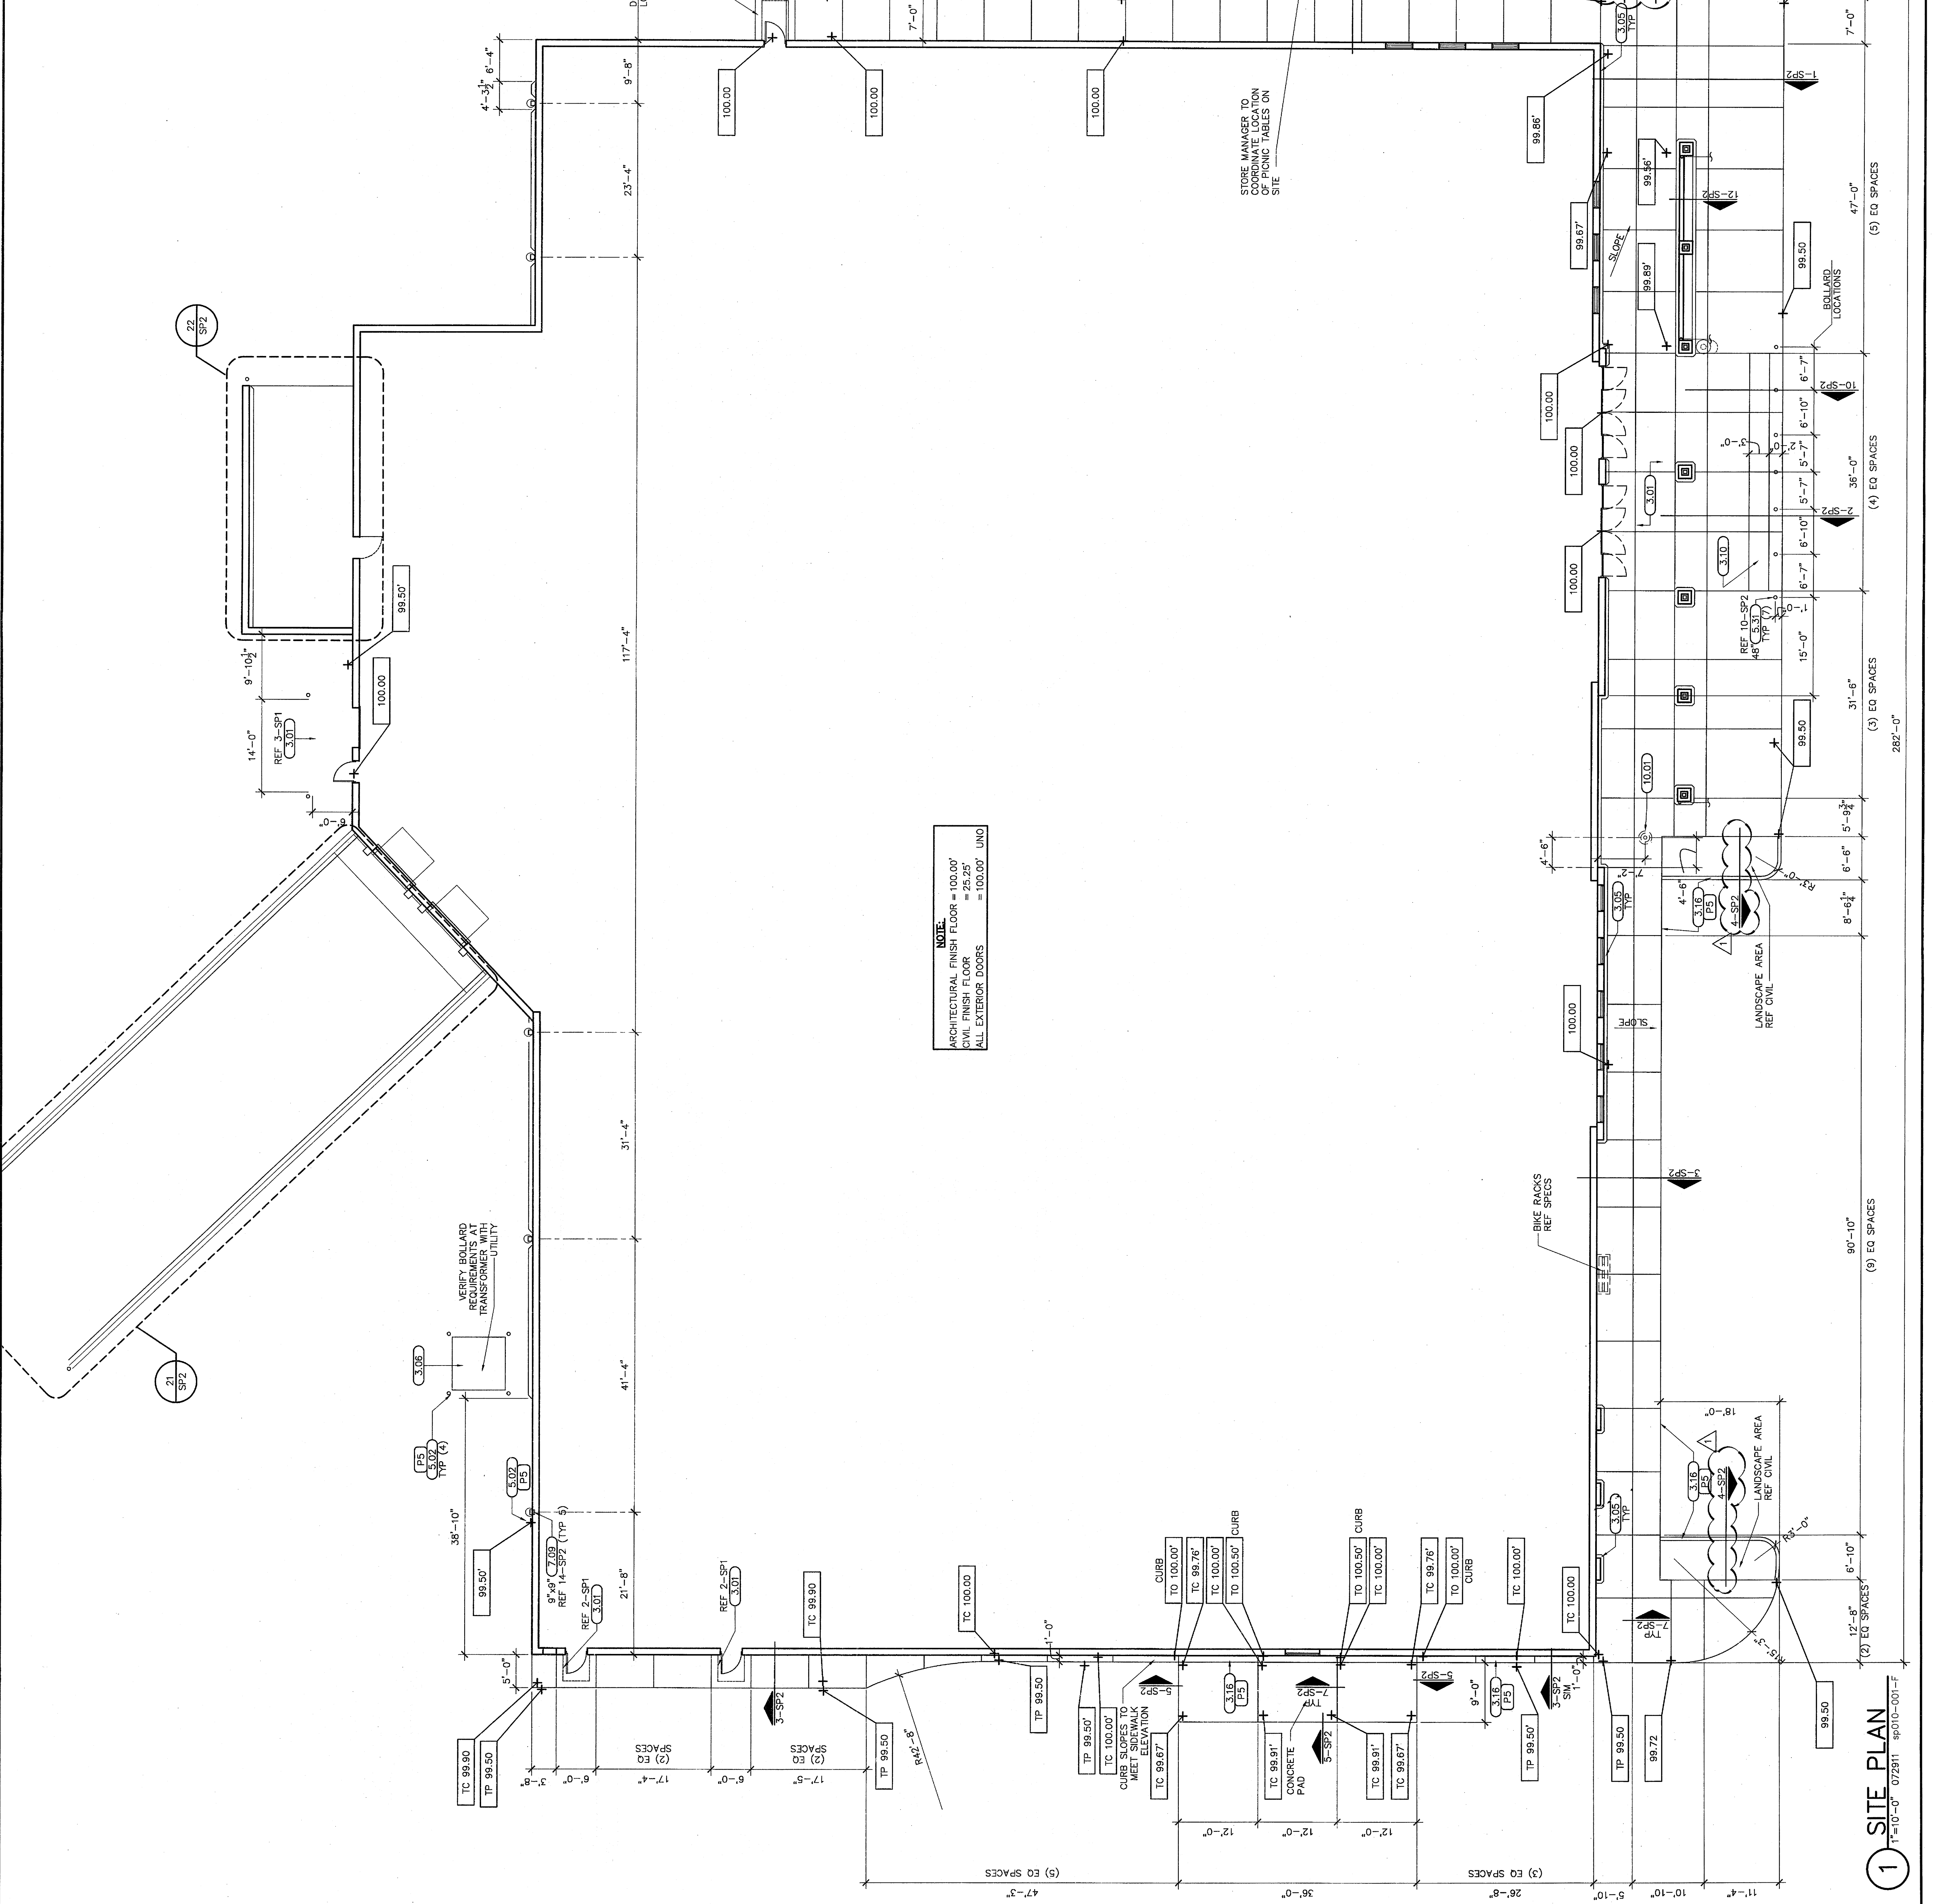



