

PANEL NEW 30 PANEL P-6
LOCATION: URSHINS SOUND AND LIGHT ROOM
FEEDER SOURCE: CLECO

VOLTAGE: 120/240V, 400A, 3Ø, 4W
ENCLOSURE: PANELBOARD, 400A, NIB,
W/OUTLET AND BAR, 14,000 AAC

CIR. NO.	THIRD WIRE NO.	LOAD DESCRIPTION	BRK/TYPE	AMP FEEDER (VA)	LOAD (VA)	LOCATION	THIRD WIRE NO.	CIR. NO.
TOTAL CONNECTED LOAD (VA)=42,321			TOTAL CONNECTED LOAD (VA)=42,321			TOTAL CONNECTED LOAD (VA)=42,321		
MINIMUM WIRE SIZE (AWG)			MINIMUM WIRE SIZE (AWG)			MINIMUM WIRE SIZE (AWG)		

PANEL NEW 10 PANEL P-7
LOCATION: NEW BUILDING
FEEDER SOURCE: 400A PANEL

VOLTAGE: 120/240V, 100A, 1Ø, 3Ø
ENCLOSURE: SURFACE MOUNTED VIL, W/OUTLET AND BAR, 10,000 AAC

CIR. NO.	THIRD WIRE NO.	LOAD DESCRIPTION	BRK/TYPE	AMP FEEDER (VA)	LOAD (VA)	LOCATION	THIRD WIRE NO.	CIR. NO.
TOTAL CONNECTED LOAD (VA)=10,125			TOTAL CONNECTED LOAD (VA)=10,125			TOTAL CONNECTED LOAD (VA)=10,125		
MINIMUM WIRE SIZE (AWG)			MINIMUM WIRE SIZE (AWG)			MINIMUM WIRE SIZE (AWG)		


PANEL EXISTING 10 PANEL P-5
LOCATION: URSHINS SOUND AND LIGHT ROOM
FEEDER SOURCE: 400A PANEL

VOLTAGE: 120/240V, 100A, 1Ø, 3Ø
ENCLOSURE: SURFACE MOUNTED VIL, W/OUTLET AND BAR

CIR. NO.	THIRD WIRE NO.	LOAD DESCRIPTION	BRK/TYPE	AMP FEEDER (VA)	LOAD (VA)	LOCATION	THIRD WIRE NO.	CIR. NO.
TOTAL CONNECTED LOAD (VA)=22,000			TOTAL CONNECTED LOAD (VA)=22,000			TOTAL CONNECTED LOAD (VA)=22,000		
MINIMUM WIRE SIZE (AWG)			MINIMUM WIRE SIZE (AWG)			MINIMUM WIRE SIZE (AWG)		


ELECTRICAL PANEL SCHEDULES

SCALE: N.T.S.

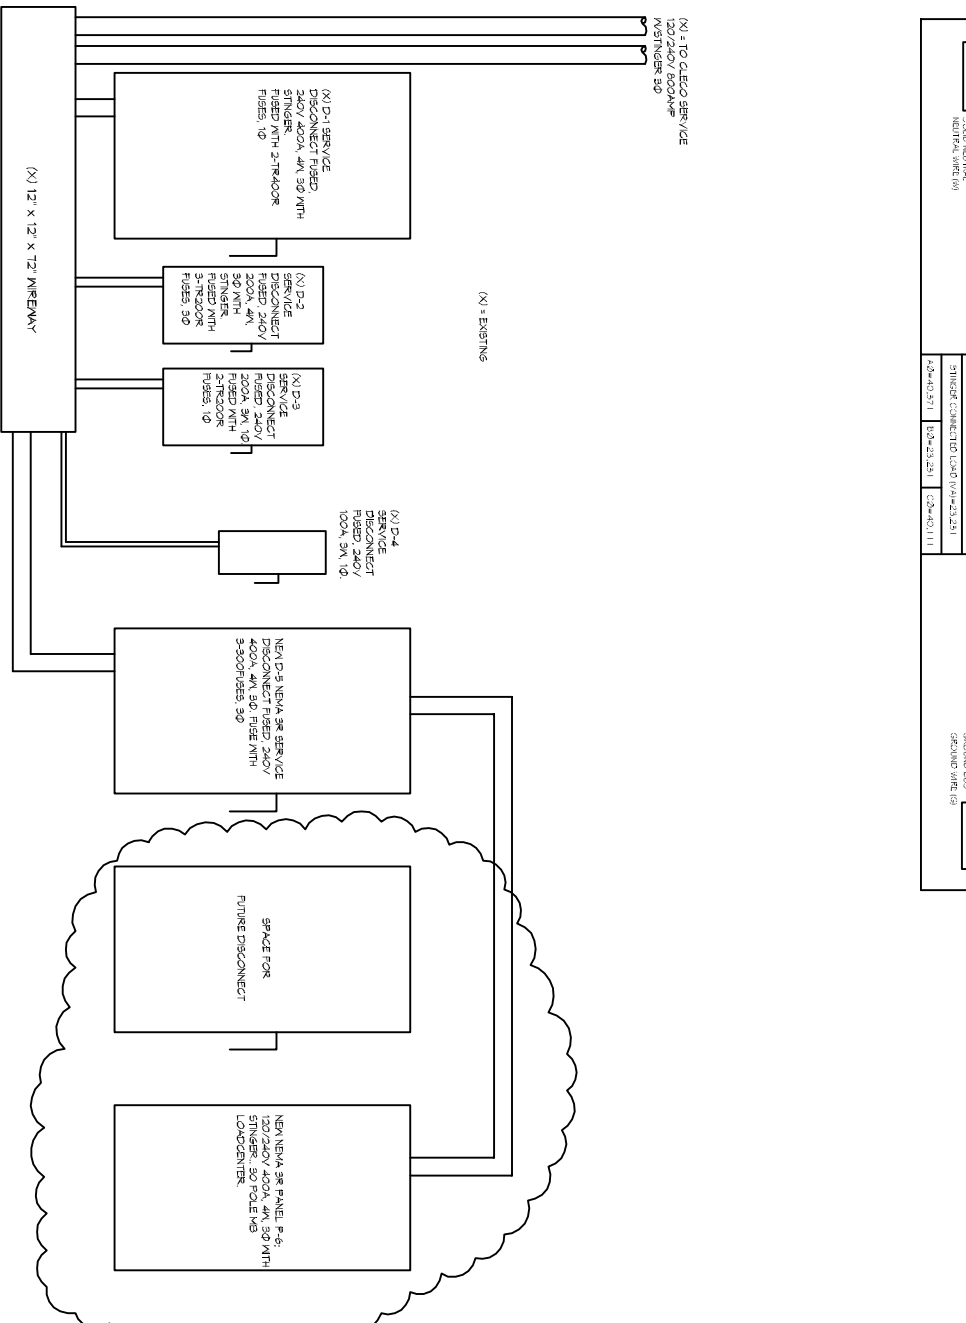

ELECTRICAL ELEVATION

SCALE: N.T.S.

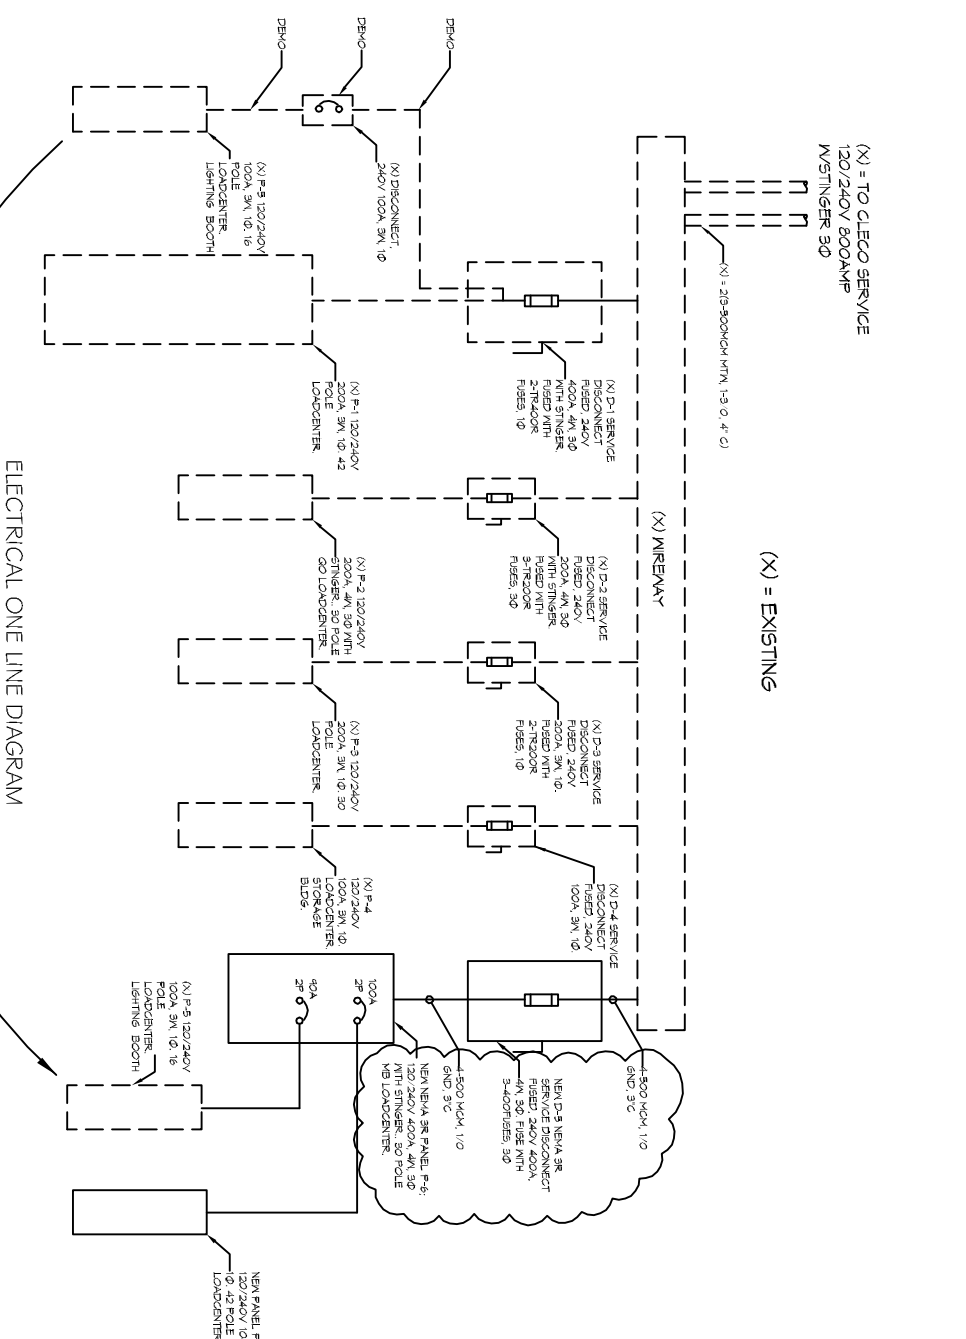

ELECTRICAL ONE LINE DIAGRAM

SCALE: N.T.S.

RE-TERMINATE

In joint venture with:

DAMMON ENGINEERING INC.
Architects & Engineers

Chief Architect: Kevin J. Kirchen, NCARB
Chief Engineer: Brian Atchey, PE
504 Old Spanish Trail
Slidell, LA 70458

www.dammonengineering.com
dammoneng@slidell.net
PH: 985.543.5831
F: 985.541.2929

DATE: 9/19/14
SCALE: NOTED
JOB NO. 108

DESIGN: E-3

Slidell Little Theatre
2024 Nellie Drive
Slidell, Louisiana 70458

FRANK E. GERARVE, JR., ARCHITECT, L.L.C.
A Professional Architectural Limited Liability Company
Designers Planners Engineers

9108 CHRETIEN POINT PLACE, RIVER RIDGE, LOUISIANA 70123
Telephone: (504) 737-2821 Facsimile: (504) 737-2822

These documents are and shall remain the property of the client and shall not be reproduced, copied, or otherwise used without the written consent of the architect. The removal of these documents or their use for any purpose other than that intended shall be a violation of the architect's seal or stamp from these documents unless otherwise provided by written approval of the architect, dated and signed by the architect. Chapter 3, 1983, and such persons shall be subject to the penalties fines and or imprisonment as stated by Louisiana Law.

REVISION	BY
9/22/14	JML