
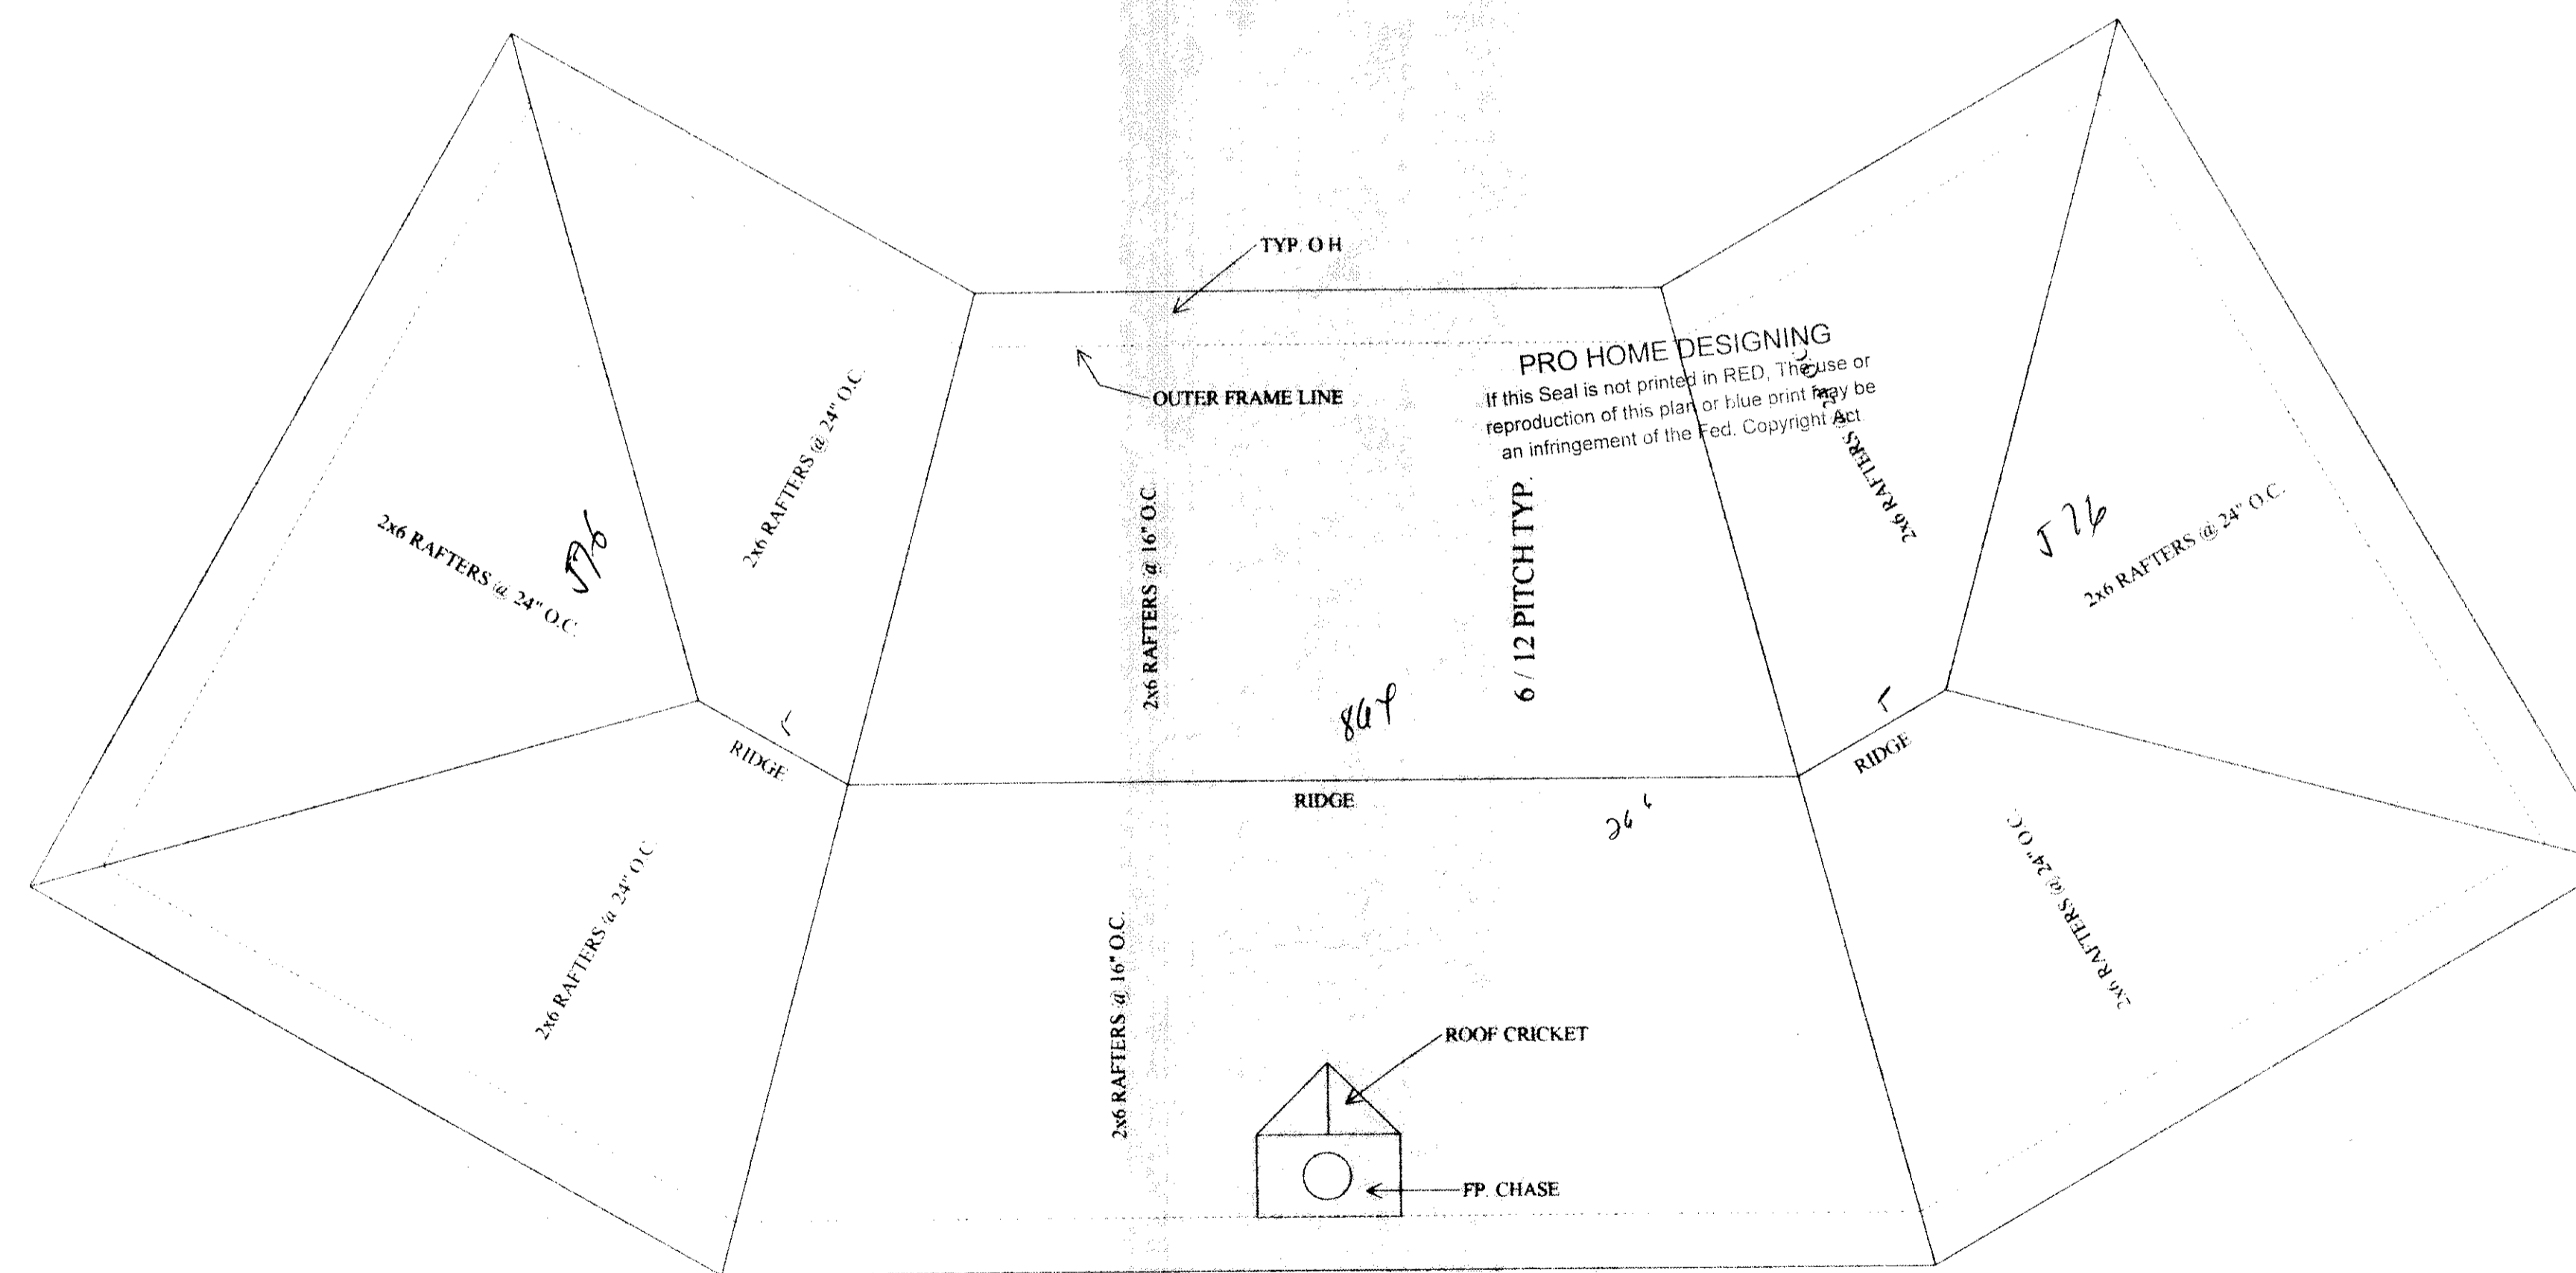


TYP. CONSTRUCTION  
SIDING

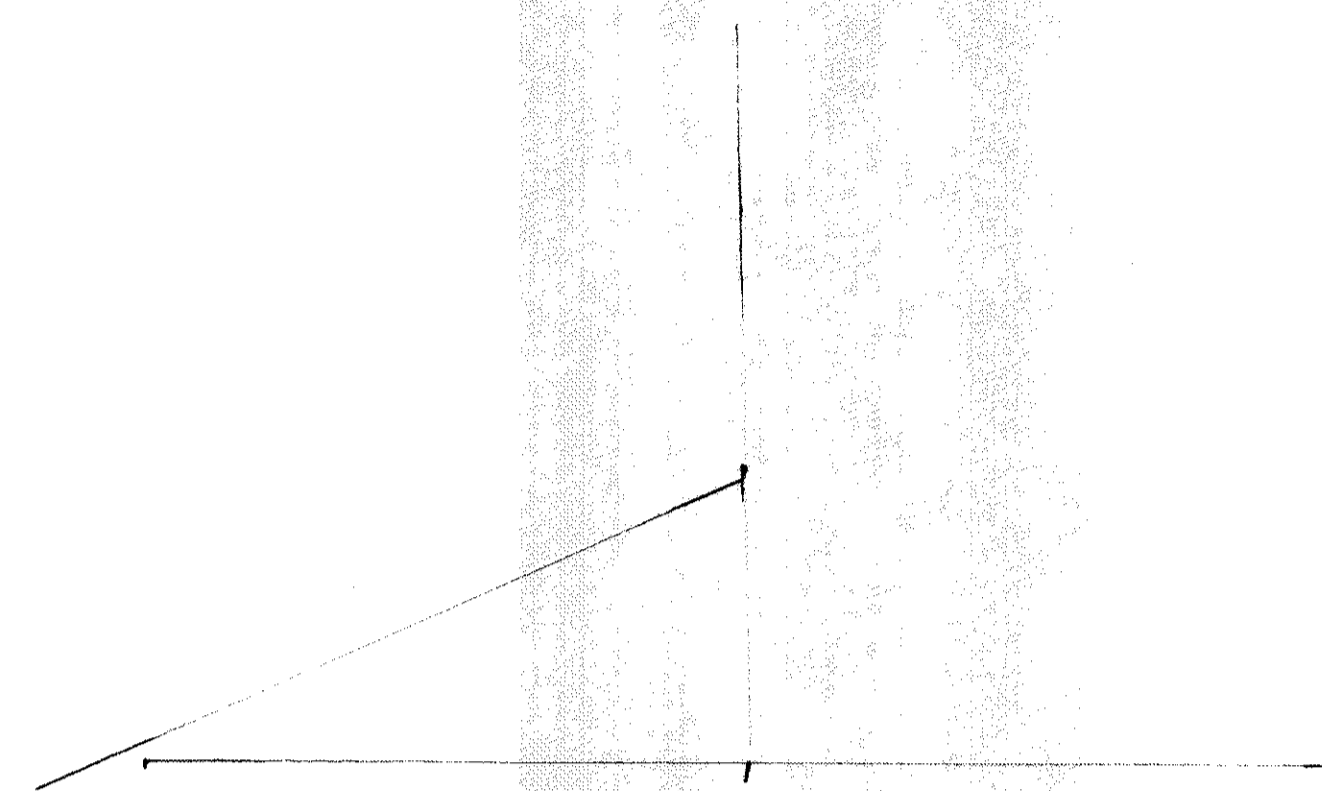


ROOF PLAN

A RESIDENCE FOR

MR. AND MRS. JAKE LEVY  
SLIDELL, LA

PRO HOME DESIGNS

(601) 799-2018 803 MEMORIAL BLVD. STE. D PICAYUNE, MS

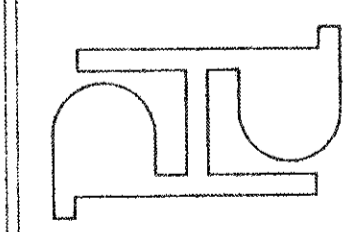

AUG. 2000

SCALE:  
1/4"=1'-0"

FILE  
1821

SHEET  
3 OF 5

Every effort has been made in preparing these drawings and specifications to avoid mistakes. Any discrepancies, error and/or omission, if found, is to be brought immediately to the attention of Pro Home Designs, before any construction work or purchases made. Pro Home Designs will not be liable for human error after construction has started.  
All codes, ordinances and requirements - federal, state and local - take precedence over any part of these drawings and specifications which may conflict with these agencies' rules and/or regulations.