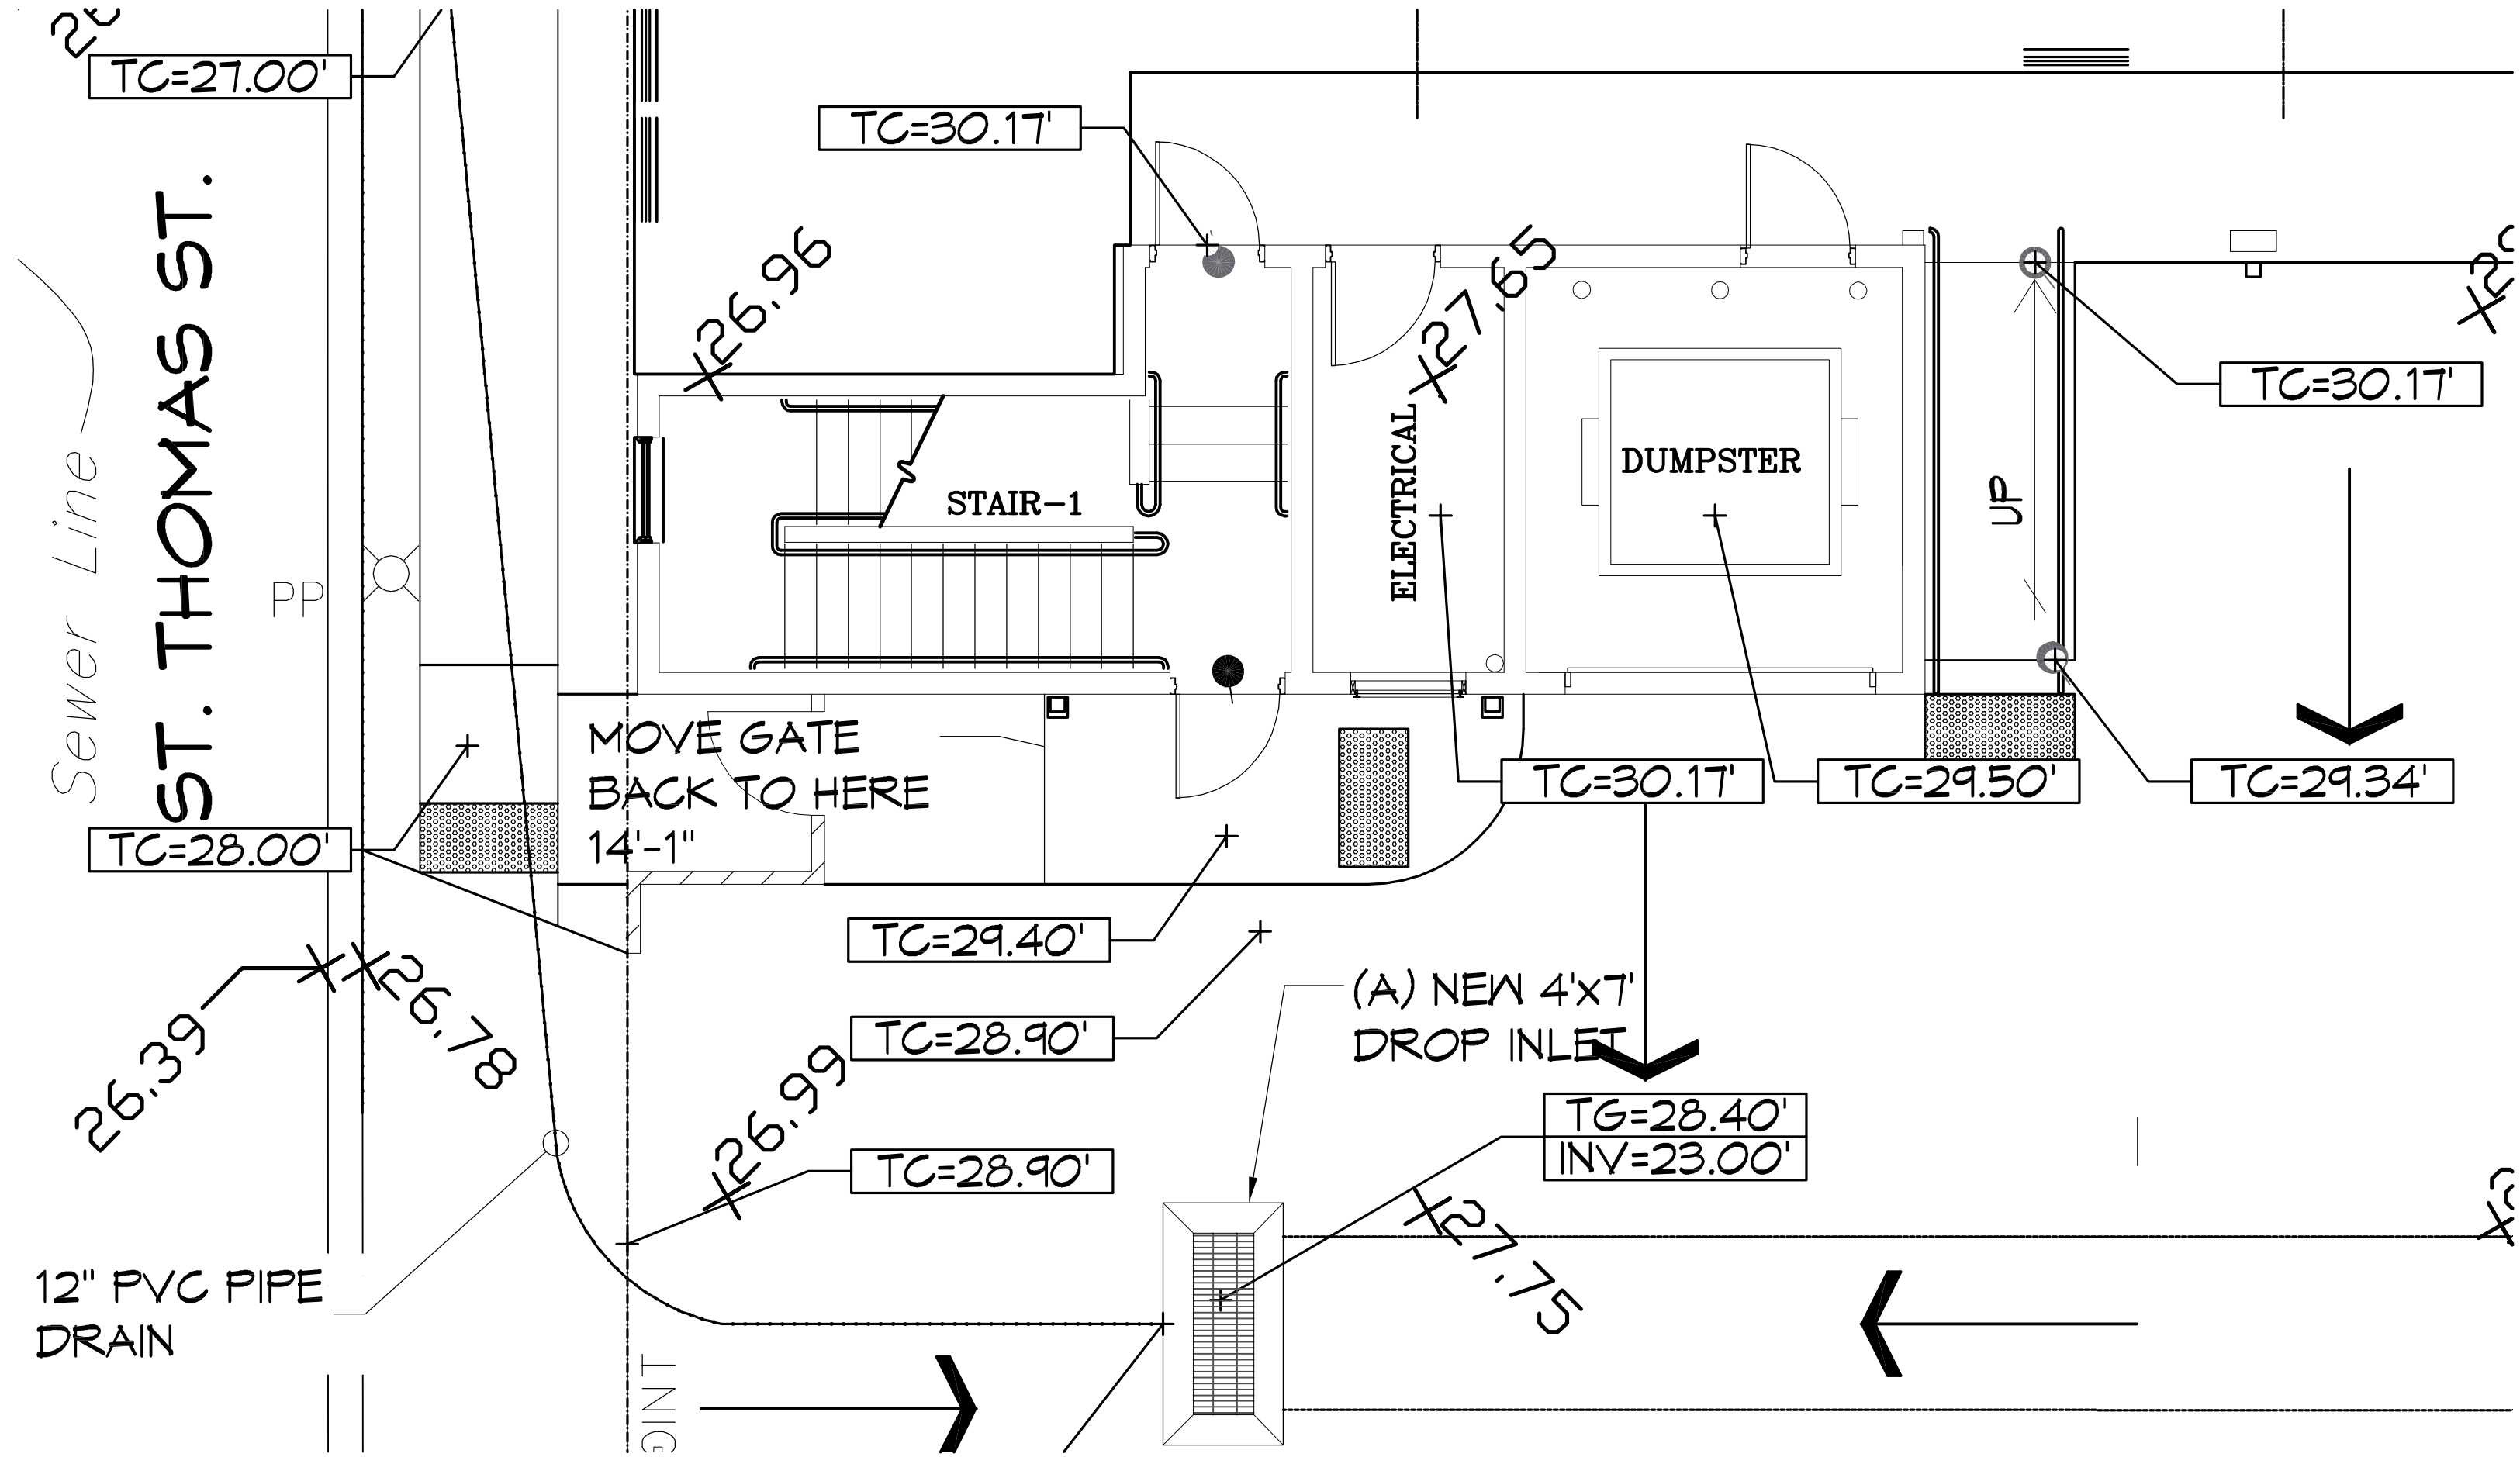
TC=27.00'
TC=30.17'
TC=30.17'
26.96
27.65
STAIR-1
ELECTRICAL
DUMPSTER
UP
TC=30.17'
TC=29.50'
TC=29.34'
Sewer Line
ST. THOMAS ST.
PP
MOVE GATE
BACK TO HERE
14'-1"
TC=28.00'
TC=29.40'
TC=28.90'
(A) NEW 4'x7'
DROP INLET
TG=28.40'
INV=23.00'
26.39
26.78
26.99
TC=28.90'
27.75
12" PVC PIPE
DRAIN