




FRONT ELEVATION  
SCALE: 1/8"=1'

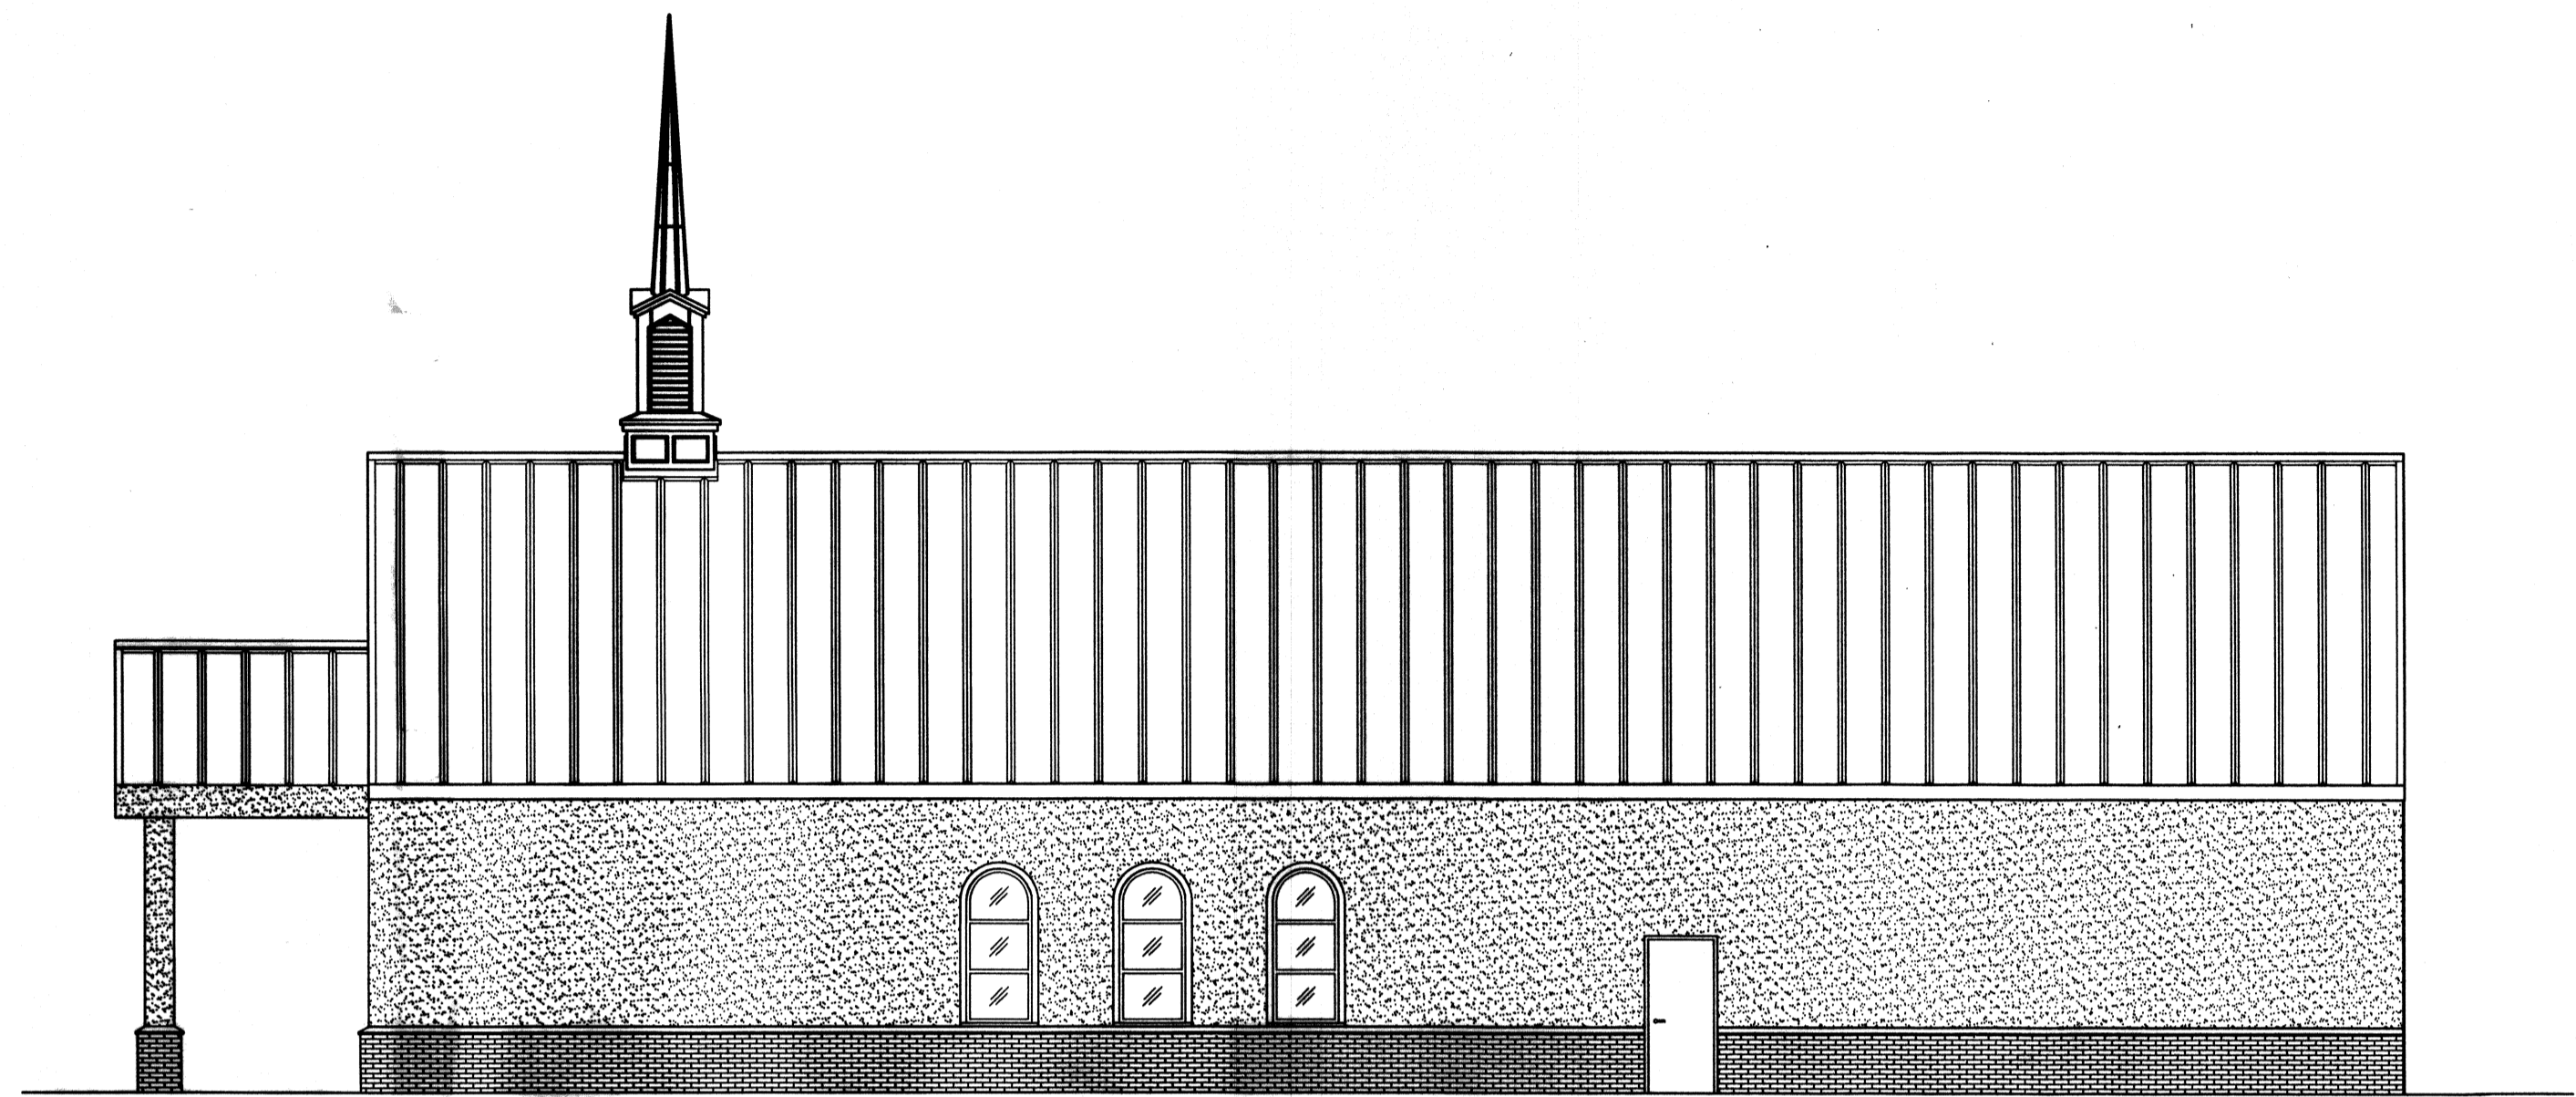

RIGHT ELEVATION  
SCALE: 1/8"=1'

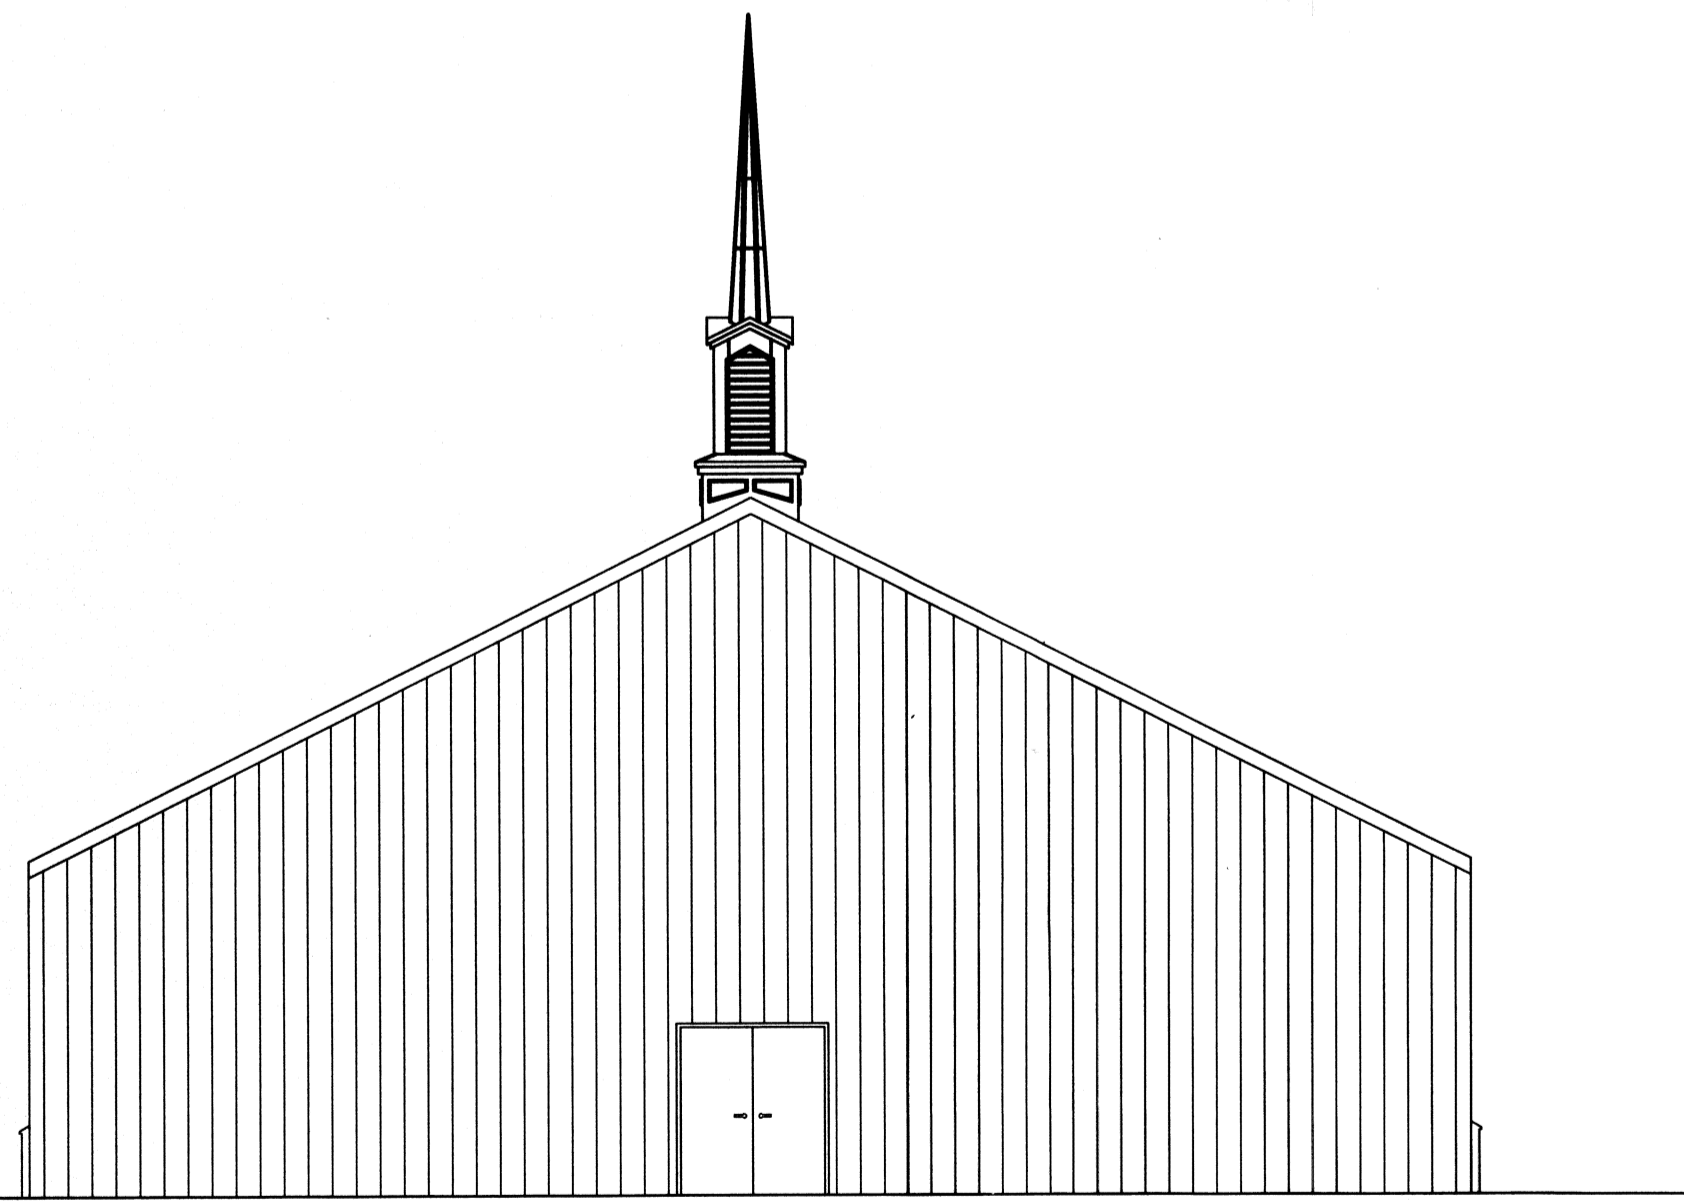

REAR ELEVATION  
SCALE: 1/8"=1'

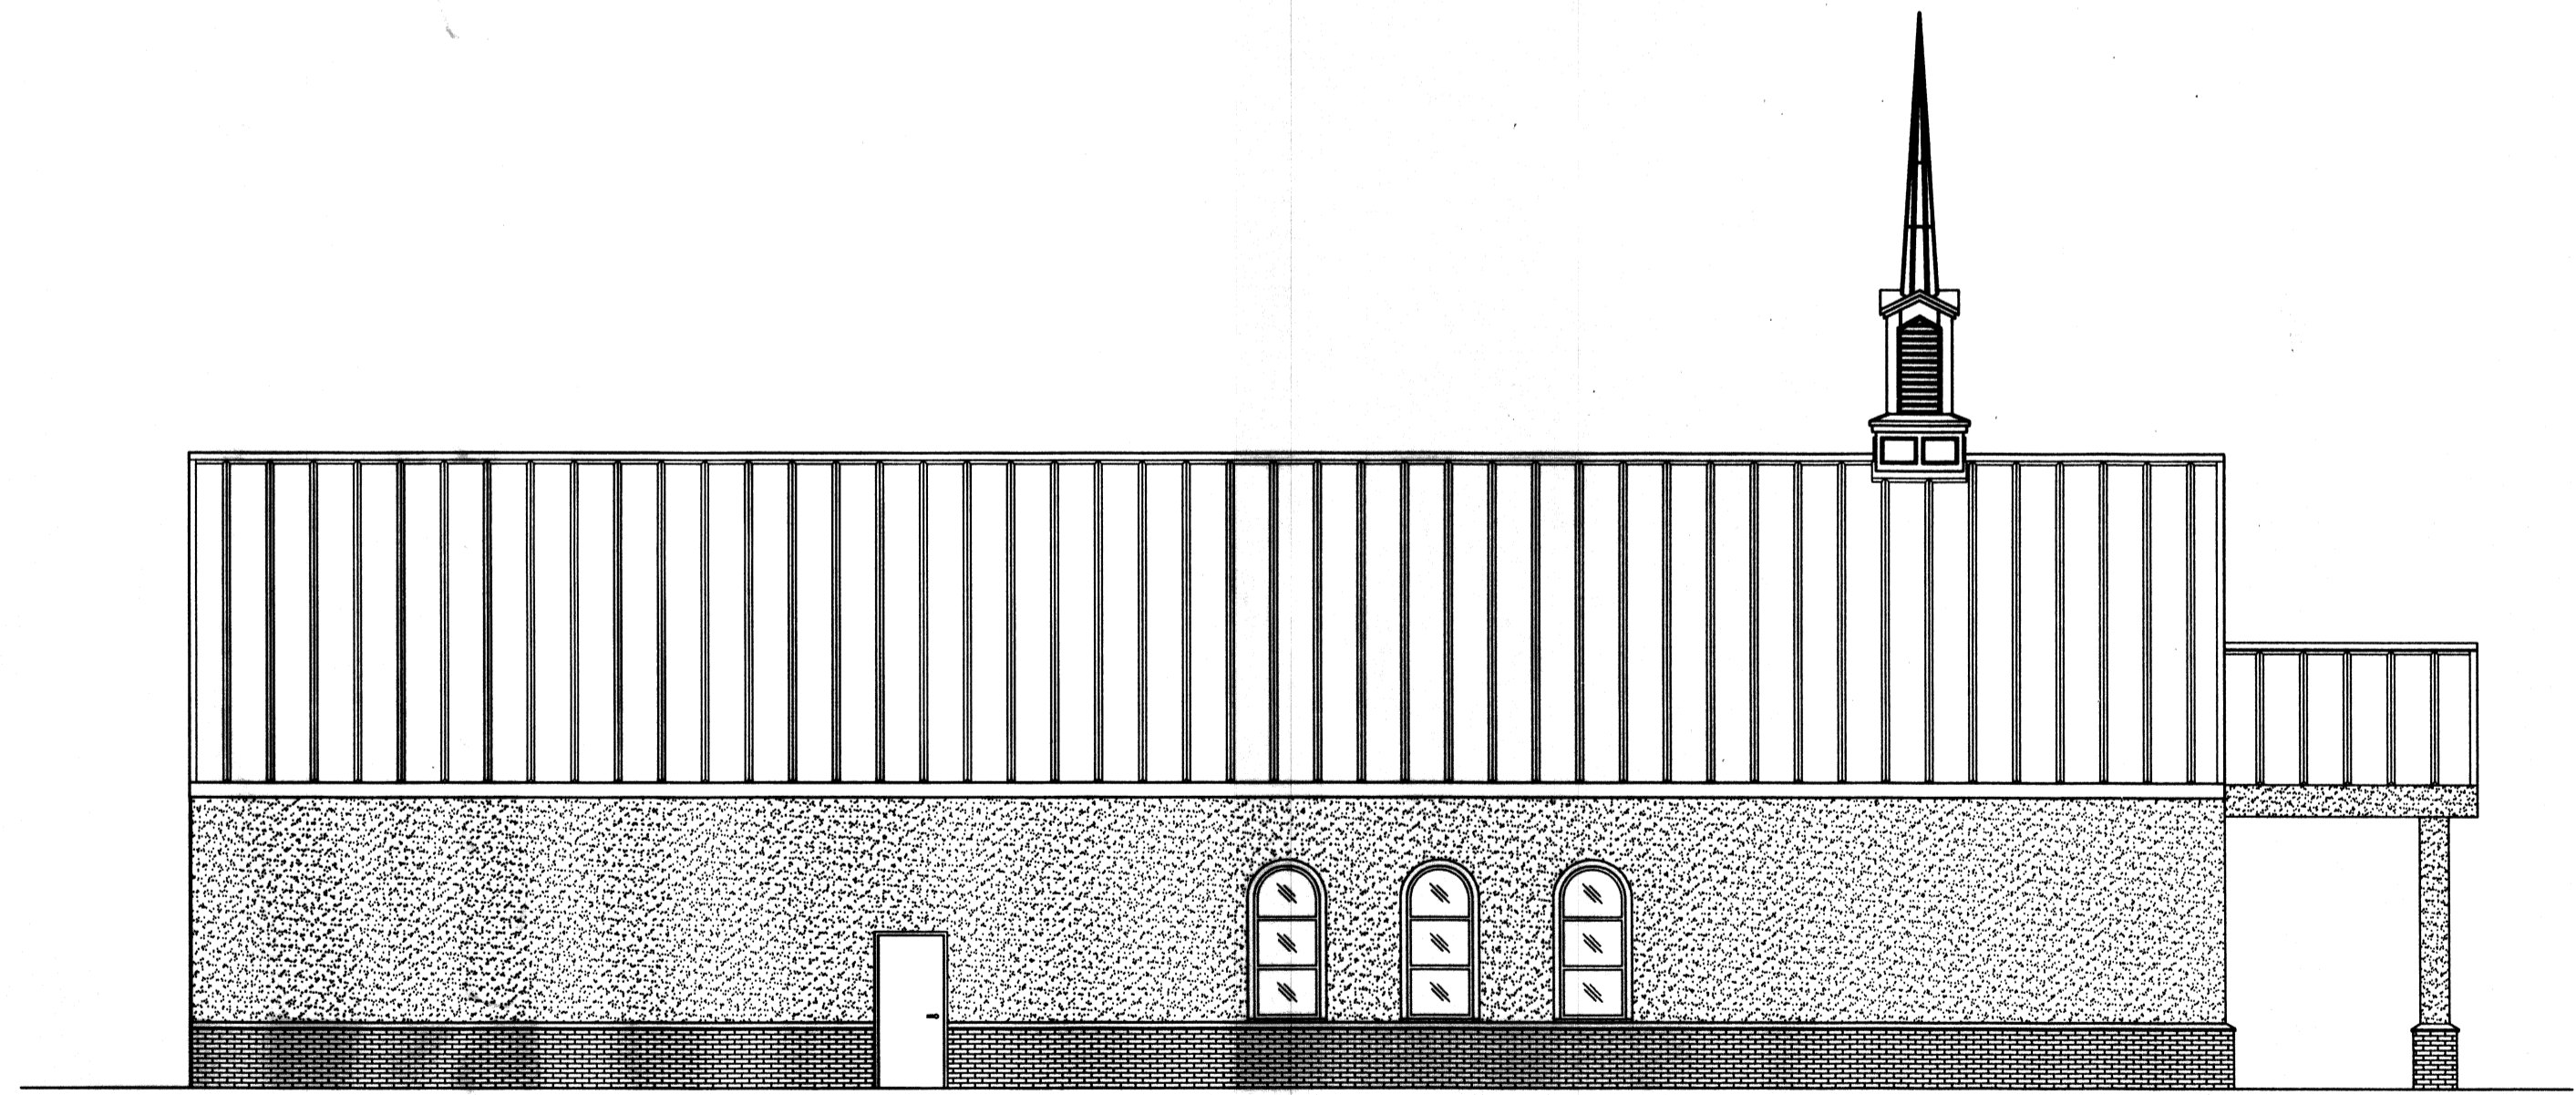

LEFT ELEVATION  
SCALE: 1/8"=1'

MAY 09 2011  
#39 7460  
REVIEWED FOR  
STATE FIRE MARSHAL  
AS PER REVIEW LETTER  
BY: JAMAR T. BARNER

DA  
ENGI  
C  
C  
554  
SL  
OFFI  
FA  
WWW.D  
DAMM  
FI  
645  
PE  
E  
REV:  
SCAL  
JOB#  
DATE:  
SHEE  
OF 1