

CONNECTION	FRAMING SPACING (INCHES)	ROOF SPAN (FEET)	U	L	S	NUMBER OF 6d COMMON NAILS OR 10d BOX NAILS IN EACH END OF 1 1/4" X 20" 6d STRAP
ROOF ASSEMBLY TO WALL ASSEMBLY	16" OC	11	386	246	106R	4
WALL ASSEMBLY TO WALL ASSEMBLY	16" OC	11	386	246	106R	4
HEADER TO HEADER (FACE NAILS)	16" OC	11	110	195	436	4

**TABLE S103.11 - SILL OR BOTTOM PLATE TO FOUNDATION CONNECTIONS RESISTING UPLIFT LOADS - 130 MPH WIND EXP "B"**

UPLIFT LOADS	FOUNDATION SUPPORTING	8 END ZONES	33
1-3 STORES	FOUNDATION SUPPORTING	12" Ø ANCHOR BOLTS	45

**TABLE S103.12 - SILL OR BOTTOM PLATE TO FOUNDATION CONNECTIONS RESISTING SHEAR LOADS - 130 MPH WIND EXP "B"**

UPLIFT LOADS	FOUNDATION SUPPORTING	12" Ø ANCHOR BOLTS	5/8" Ø ANCHOR BOLTS
1-3 STORES	FOUNDATION SUPPORTING	30	45

**TABLE S103.9 - JACK STUD REQ - INTR LOADBEARING WALLS**

HEADER SPAN (FT)	12 FEET				24 FEET			
	3"	4.5"	6.5"	9"	3"	4.5"	6.5"	9"
2	1	1	1	1	1	1	1	1
4	1	1	1	1	1	1	1	1
6	1	1	1	1	1	1	1	1
8	1	1	1	1	2	2	2	2
10	1	1	1	1	2	2	2	2
12	1	1	1	1	2	2	2	2
14	2	1	1	1	3	2	2	2
16	2	1	1	1	3	2	2	2
2	1	1	1	1	1	1	1	1
4	1	1	1	1	1	1	1	1
6	2	1	1	1	2	2	2	2
8	2	1	1	1	3	2	2	2
10	2	2	2	2	3	3	3	3
12	3	2	2	2	5	3	3	4
14	3	2	2	2	5	3	3	4
16	4	3	3	3	6	4	4	5

**DESIGN CRITERIA**

THE CONSTRUCTION FOR SFD RESIDENCE WHERE BASIC WIND SPEED IS 130 MPH PER HOUR AND EXPOSURE ZONE C, IS DESIGNED IN ACCORDANCE WITH AMERICAN FOREST AND PAPER ASSOCIATION (AF&PA) WOOD FRAME CONSTRUCTION MANUAL FOR ONE AND TWO FAMILY DWELLINGS (MFCM) 2001 EDITION AS WELL AS THE INTERNATIONAL RESIDENTIAL CODE (IRC) 2012 EDITION.

**TABLE S103.8 - THERMAL COMPONENT CRITERIA (U-VALUE FACTOR & R-VALUE**

MANUAL INSULATION R-VALUE	U-VALUE FACTOR	

**TABLE S103.3 - HEADER SPANS - INTERIOR LOADBEARING WALLS**

HEADER SUPPORTING	OPENING WIDTH (FT)		
	12	24	36
(2) 2x4	4'-4"	3'-1"	2'-6"
(2) 2x6	6'-5"	4'-6"	3'-0"
(2) 2x8	8'-1"	5'-4"	4'-0"
(2) 2x10	9'-11"	7'-0"	5'-4"
(3) 2x12	11'-6"	8'-2"	6'-7"

**TABLE S103.4 - ROOF SHEATHING OR CLADDING REQUIREMENT - WIND LOAD EXP "C"**


SHEATHING LOCATION	RAFTER / TRUSS SPACING	MAX NAIL SPACING FOR 8d COMMON NAILS (INCHES 0-0)	
		E	F
INTERIOR ZONE	12" OC	6	12
	24" OC	6	12
PERIMETER EDGE ZONE	12" OC	6	12
	24" OC	6	6

**TABLE S103.5 - WALL SHEATHING OR CLADDING REQUIREMENT - WIND LOAD EXP "C"**

SHEATHING LOCATION	STUD SPACING	MAX NAIL SPACING FOR 8d COMMON NAILS OR 10d BOX NAILS (INCHES 0-0)	
		E	F
INTERIOR ZONE	16" OC	6	12
	24" OC	6	12
PERIMETER EDGE ZONE	16" OC	6	12
	24" OC	6	12

**TABLE S103.6 - WINDBORNE DEBRIS PROTECTION FASTENING SCHEDULE FOR WOOD STRUCTURAL PANELS**

FASTENER TYPE	FASTENER SPACING		
	PANEL SPAN 4'	4' PANEL SPAN 6' PANEL SPAN 8' 8'	8' 8'
3/16" 4d NAIL SCREWS	16"	12"	12"

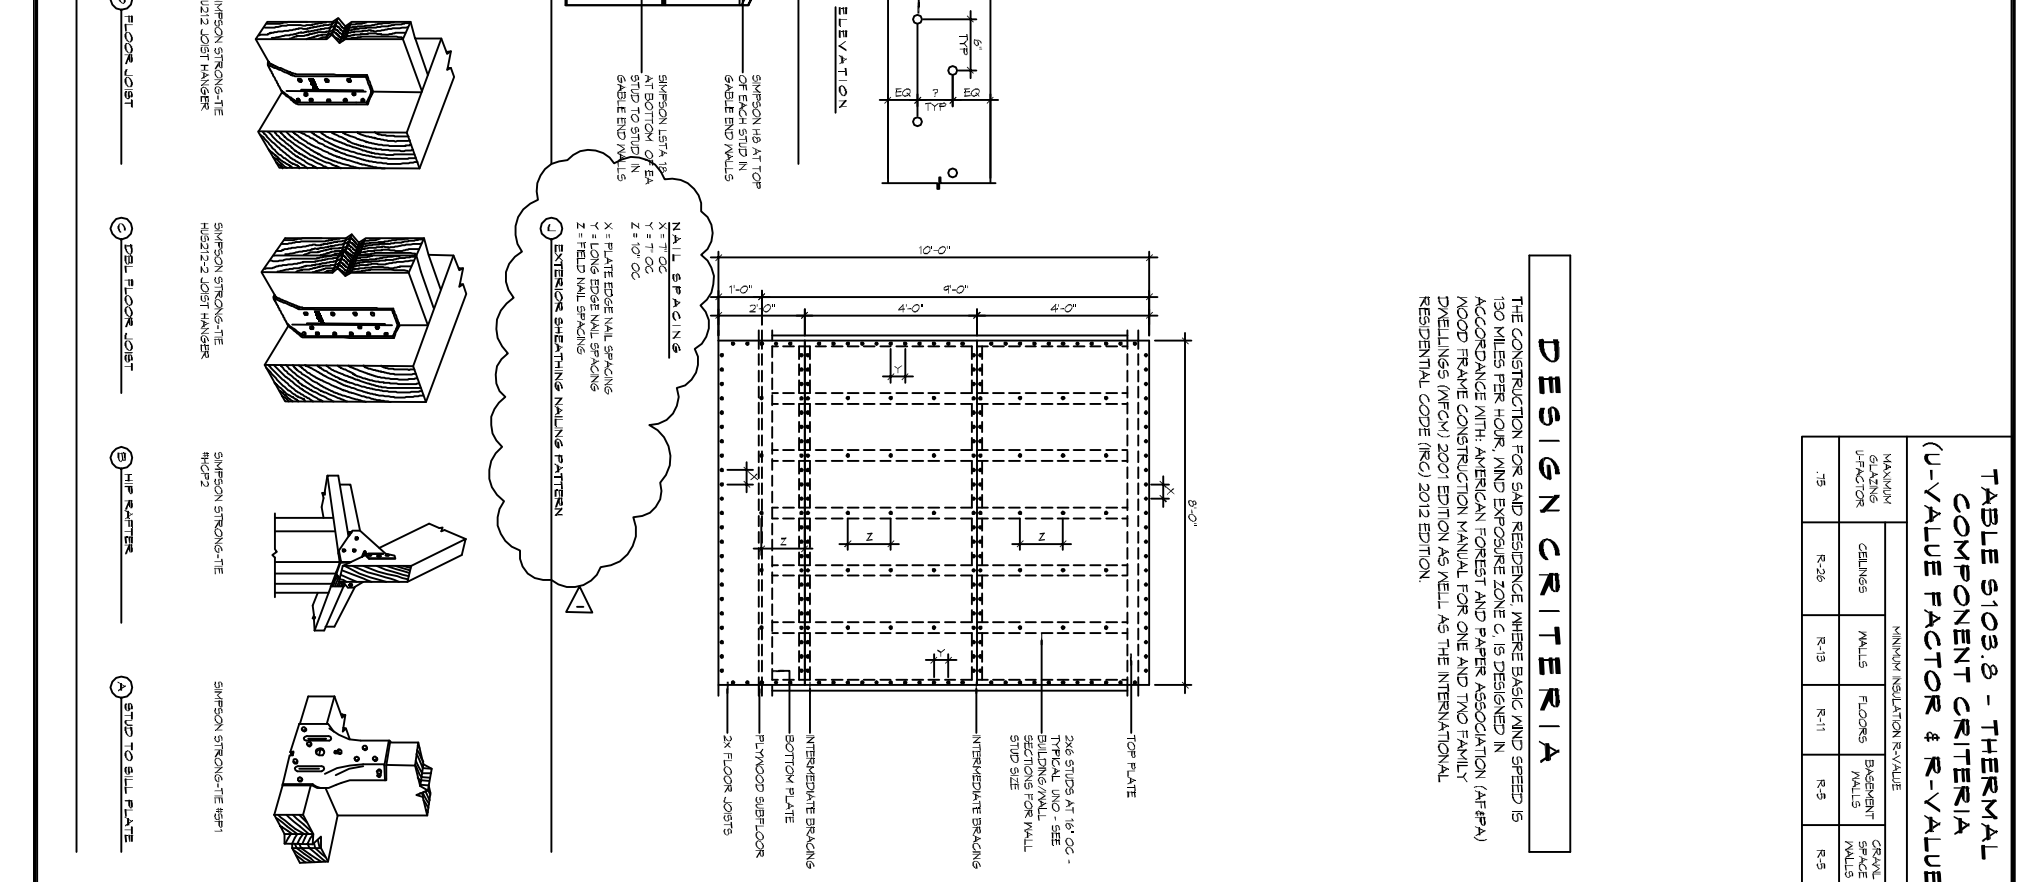

**TABLE S103.7 - HEADER NAILING SCHEDULE**

DESCRIPTION	NUMBER OF COMMON NAILS	NUMBER OF BOX NAILS	SPACING
HEADERS TO HEADERS (FACE NAILS)	8d	10d	6" OC EDGES 12" OC FIELD

**SHINGLE APPLICATION NOTES**

- ASPHALT SHINGLE SHINGLES SHALL HAVE A MINIMUM OF SIX FASTENERS PER SHINGLE WHERE THE ROOF IS IN ONE OF THE FOLLOWING CATEGORIES: WIND SPEED IS 110 MPH OR GREATER AND THE SLOPE IS 30 DEGREES OR HIGHER ABOVE GRADE.
- THE BASIC WIND SPEED IS 120 MPH OR GREATER.
- SPECIAL WIND ZONES.

**GENERAL UPLIFT CONNECTION NOTES**

ROOF ASSEMBLY TO WALL ASSEMBLY:  
UPLIFT CONNECTIONS SHALL BE FROM RAFTER OR TRUSS TO WALL STUD. MEN RAFTERS OR TRUSSES ARE NOT LOCATED DIRECTLY ABOVE STUDS. PLATE SHALL BE ATTACHED TO THE WALL STUD WITH UPLIFT CONNECTIONS. UPLIFT CONNECTIONS SHALL BE IN ACCORDANCE WITH TABLE S103.10.

WALL ASSEMBLY TO WALL ASSEMBLY:  
ROOF TO STORY WALL STUD CONNECTIONS FROM UPPER STORY WALL STUD TO LOWER STORY WALL STUD: MEN UPPER STORY WALL STUDS ARE NOT ATTACHED TO A COMMON MEMBER IN THE FLOOR ASSEMBLY BY UPLIFT CONNECTIONS. UPLIFT CONNECTIONS SHALL BE IN ACCORDANCE WITH TABLE S103.11.

**TABLE S103.1 - HEADER SPANS - EXPOSURE "C" FOR EXTERIOR LOADBEARING WALLS**

HEADER SIZE	SPAN	NUMBER FULL-HEIGHT STUDS REQ AT EA END
(2) 2x4	4'-3"	TWO
(2) 2x6	6'-6"	TWO
(2) 2x8	6'-4"	THREE
(2) 2x10	6'-4"	THREE
(2) 2x12	7'-1"	THREE
(3) 2x6	7'-5"	THREE
(3) 2x10	8'-3"	THREE
(4) 2x6	8'-1"	THREE
(4) 2x8	8'-6"	THREE
(4) 2x12	10'-0"	FOUR

**TABLE S103.2 - JACK STUD REQ - EXPOSURE "C" FOR EXT LOADBEARING WALLS**

HEADER SPAN (FT)	4 JACK STUDS REQUIRED
2	1
4	1
6	2
8	2
10	3
12	3
14	4
16	4













**DAMMON ENGINEERING INC.**  
LOUISIANA & MISSISSIPPI

Chief Engineer: Brian Mstich, PE  
554 Old Spanish Trail  
Slidell, LA 70458

www.dammonengineering.com  
PH: 985.649.5832 F: 985.641.5950

**REVISIONS**

#	DESCRIPTION	DATE
1 <td>CHANGE NAILING PATTERN <td>06-18-16</td> </td>	CHANGE NAILING PATTERN <td>06-18-16</td>	06-18-16

SCALE: 1/8" = 1'-0"

7/28/16

**TITLE BLOCK**

1341 SULLIVAN DR.  
SLIDELL, LA 70460

JOB NO: 2274 DATE: 07/21/2016  
DRAWN BY: JTL CHECKED BY: BAN

**S103**

6 OF 11