


AVG EE 26.76'

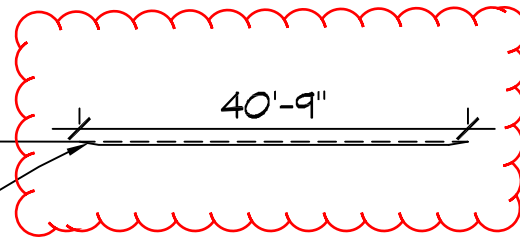

SLOPE CUT AREA SLOPES 1H:0.2V
FOR 1ST 2FT, THEN SLOPE TO
CENTER AREA (TYP).

K SECTION
SCALE: 1"=30'
