


BUILDOUT AREA

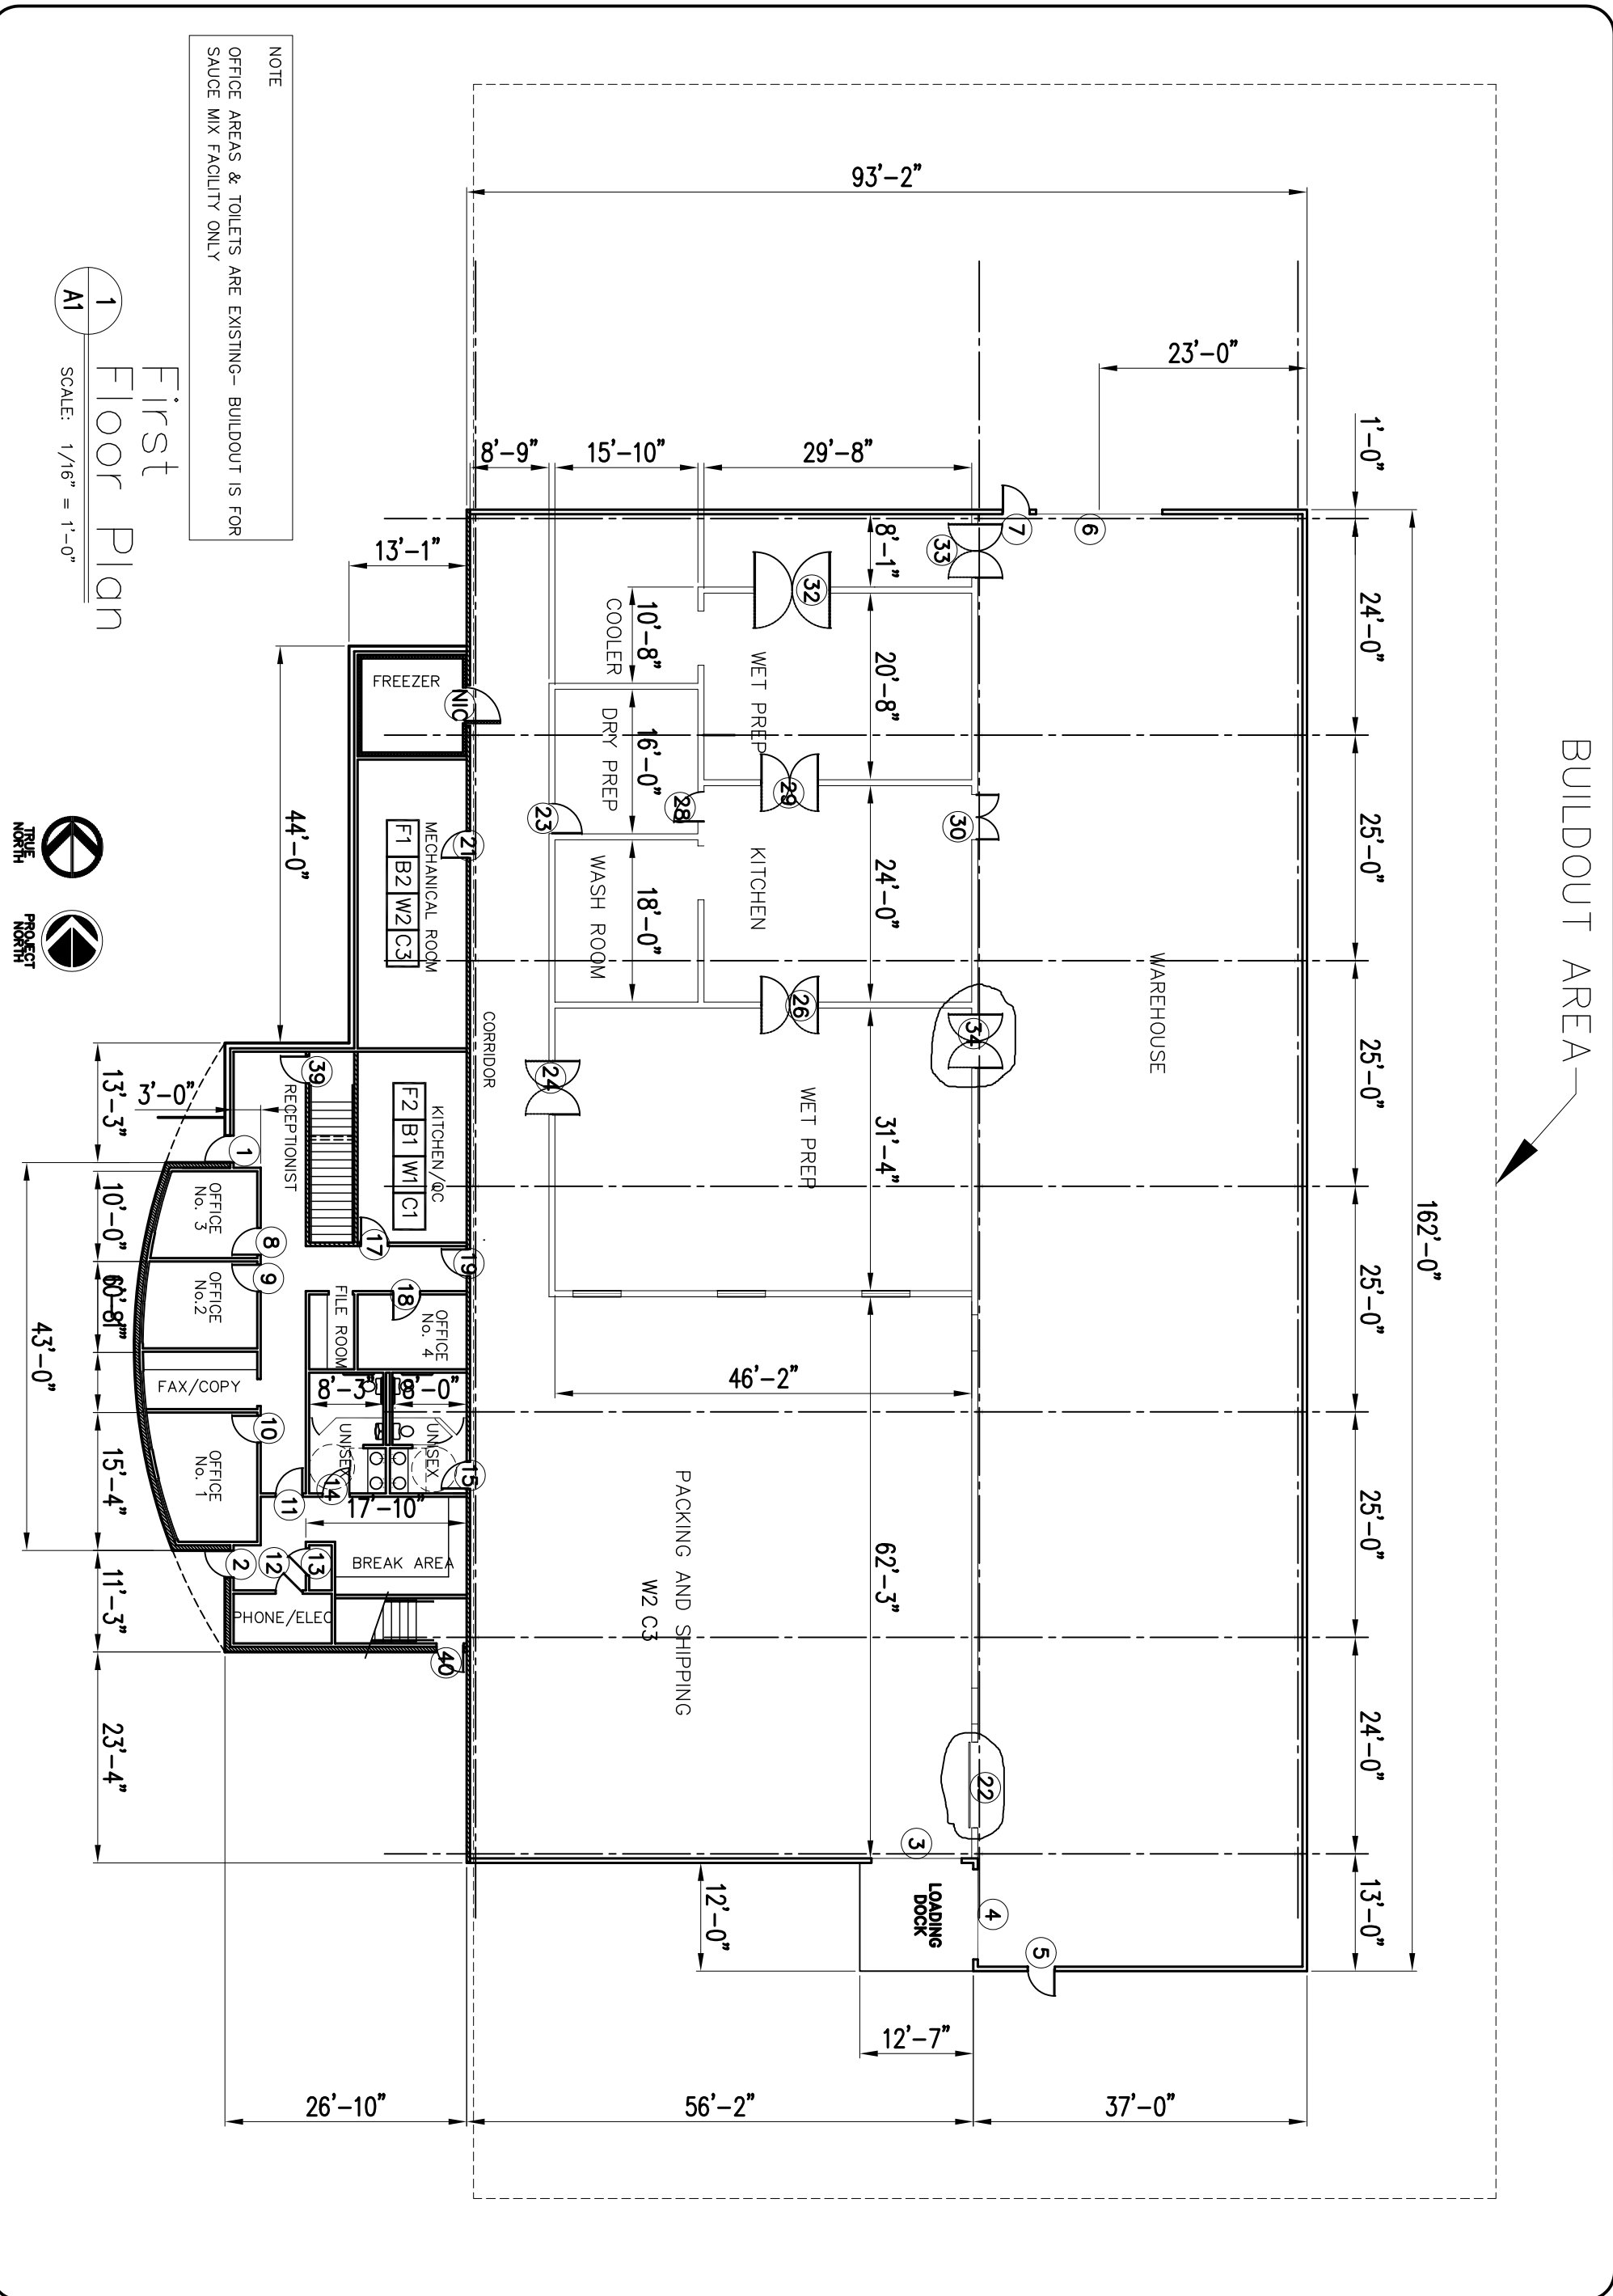

NOTE  
OFFICE AREAS & TOILETS ARE EXISTING— BUILDOUT IS FOR SAUCE MIX FACILITY ONLY

1  
A1  
First Floor Plan  
SCALE: 1/16" = 1'-0"



OF A-1	SHEET	DATE: 05/25/07	JOB NO.	FILE:	SLIDELL LA	SAL AND JUDY'S SAUCE MIX PLANT		FLOOR PLAN	
		<b>DAMMON ENGINEERING, INC.</b> 1095 FLORIDA AVENUE 985-649-5832 SLIDELL, LA. 70458 DAMMONENGINEERING.COM				LOT 36 JOHNNY SMITH AVE. JOHNNY SMITH MEM. PARK SLIDELL, LA.			