


Center vac will result in loss of several vac lanes (my guess 4)

ONE WAY TRAFFIC

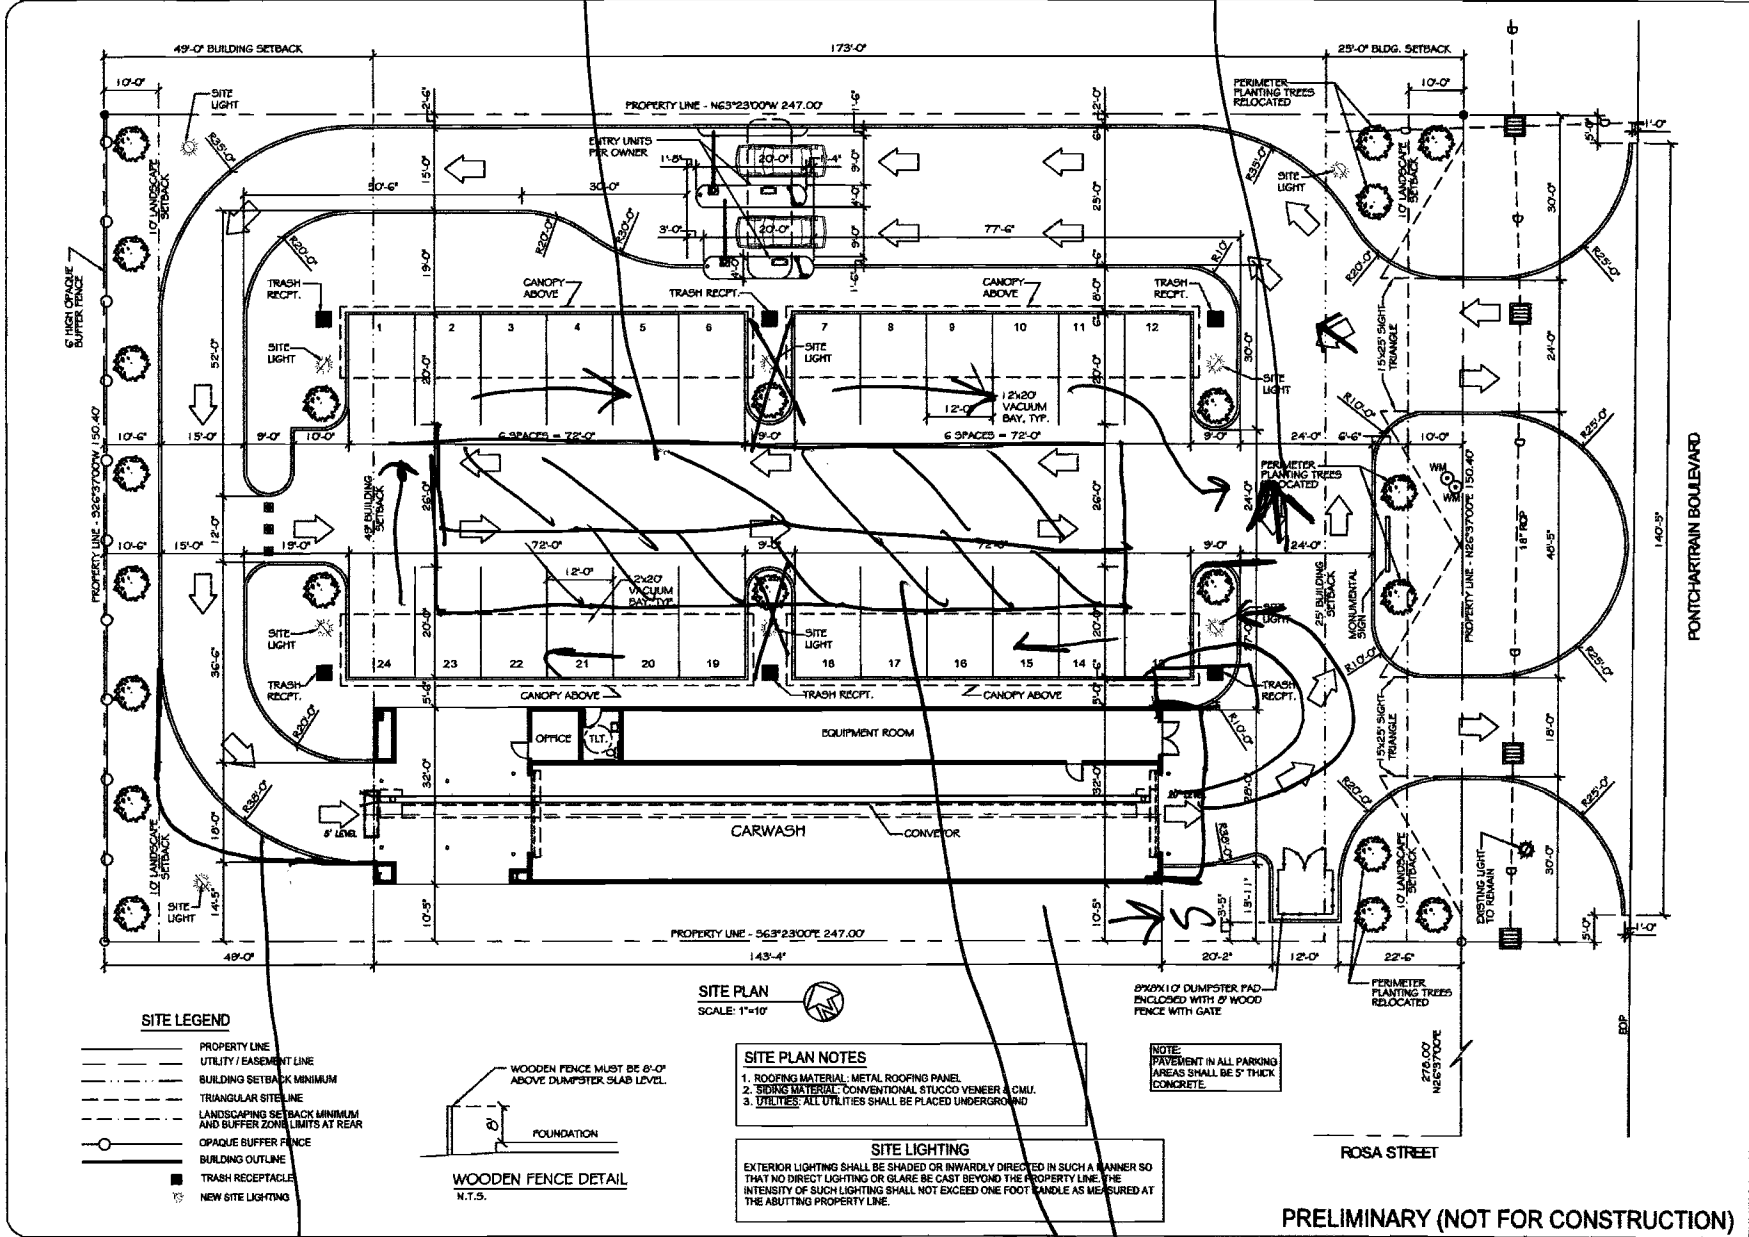

DAMMON ENGINEERING, INC.

CHIEF ENGINEER
BRUNO DAMON, P.E.
CHIEF ARCHITECT
ROBERT WILTSE

1095 FLORIDA AVENUE
SLIDELL, LA 70458
OFFICE: 905-648-5832
FAX: 905-641-5990

WEBSITE:
WWW.DAMMONENGINEERING.COM
EMAIL:
DAMMONING@GULFSOUTH.NET

ARCHITECTURE
ENGINEERING
STUDIES
PLANNING
INVESTIGATION
EXPERT WITNESS

NORTHSPARK CARWASH

3017
PONTCHARTRAIN
DRIVE
SLIDELL, LA
70458

SITE PLAN SCHEME ONE

REV:

SCALE: AS NOTED

JOB#: 2085

DATE: 11-10-10

SHEET

C-2

OF

20' straight before conveyor.

Shift Bld 5' toward Blvd.
To avoid 2 way traffic have a ~~two~~ double canopy in center