




5 CANOPY SECTION
A4.1 1/2" = 1'-0"

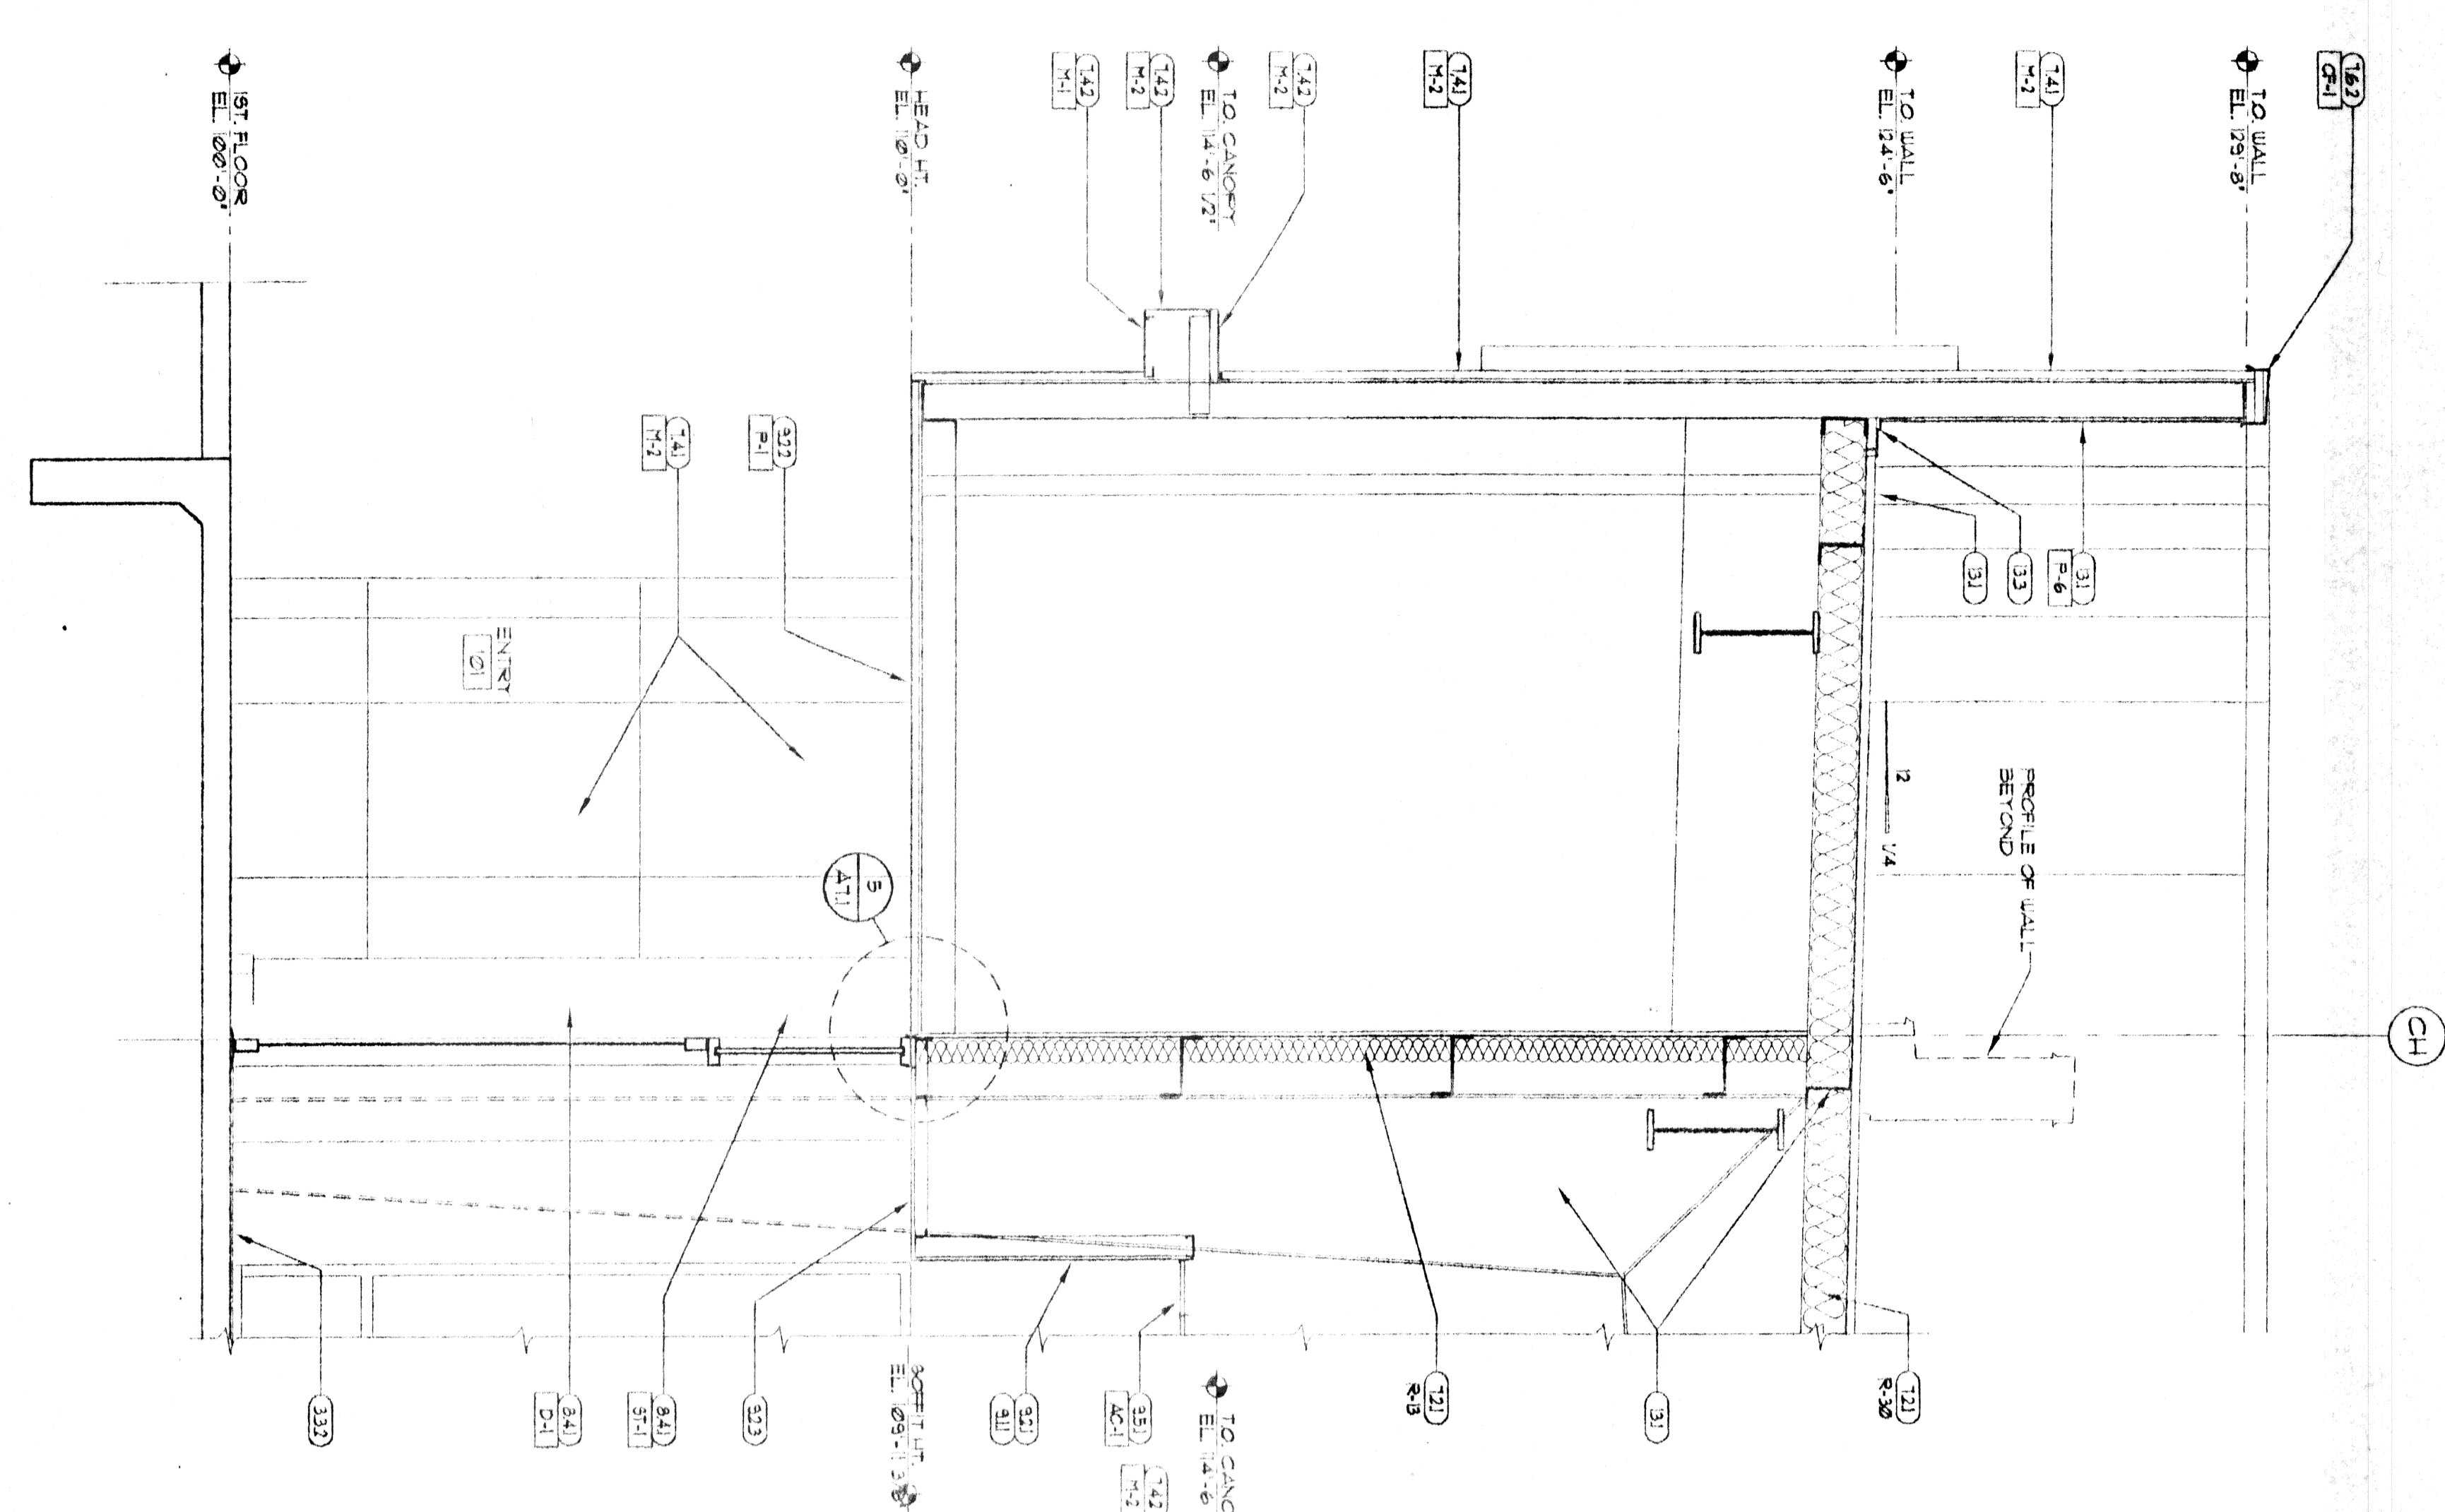


4 WALL SECTION
A4.1 1/2" = 1'-0"

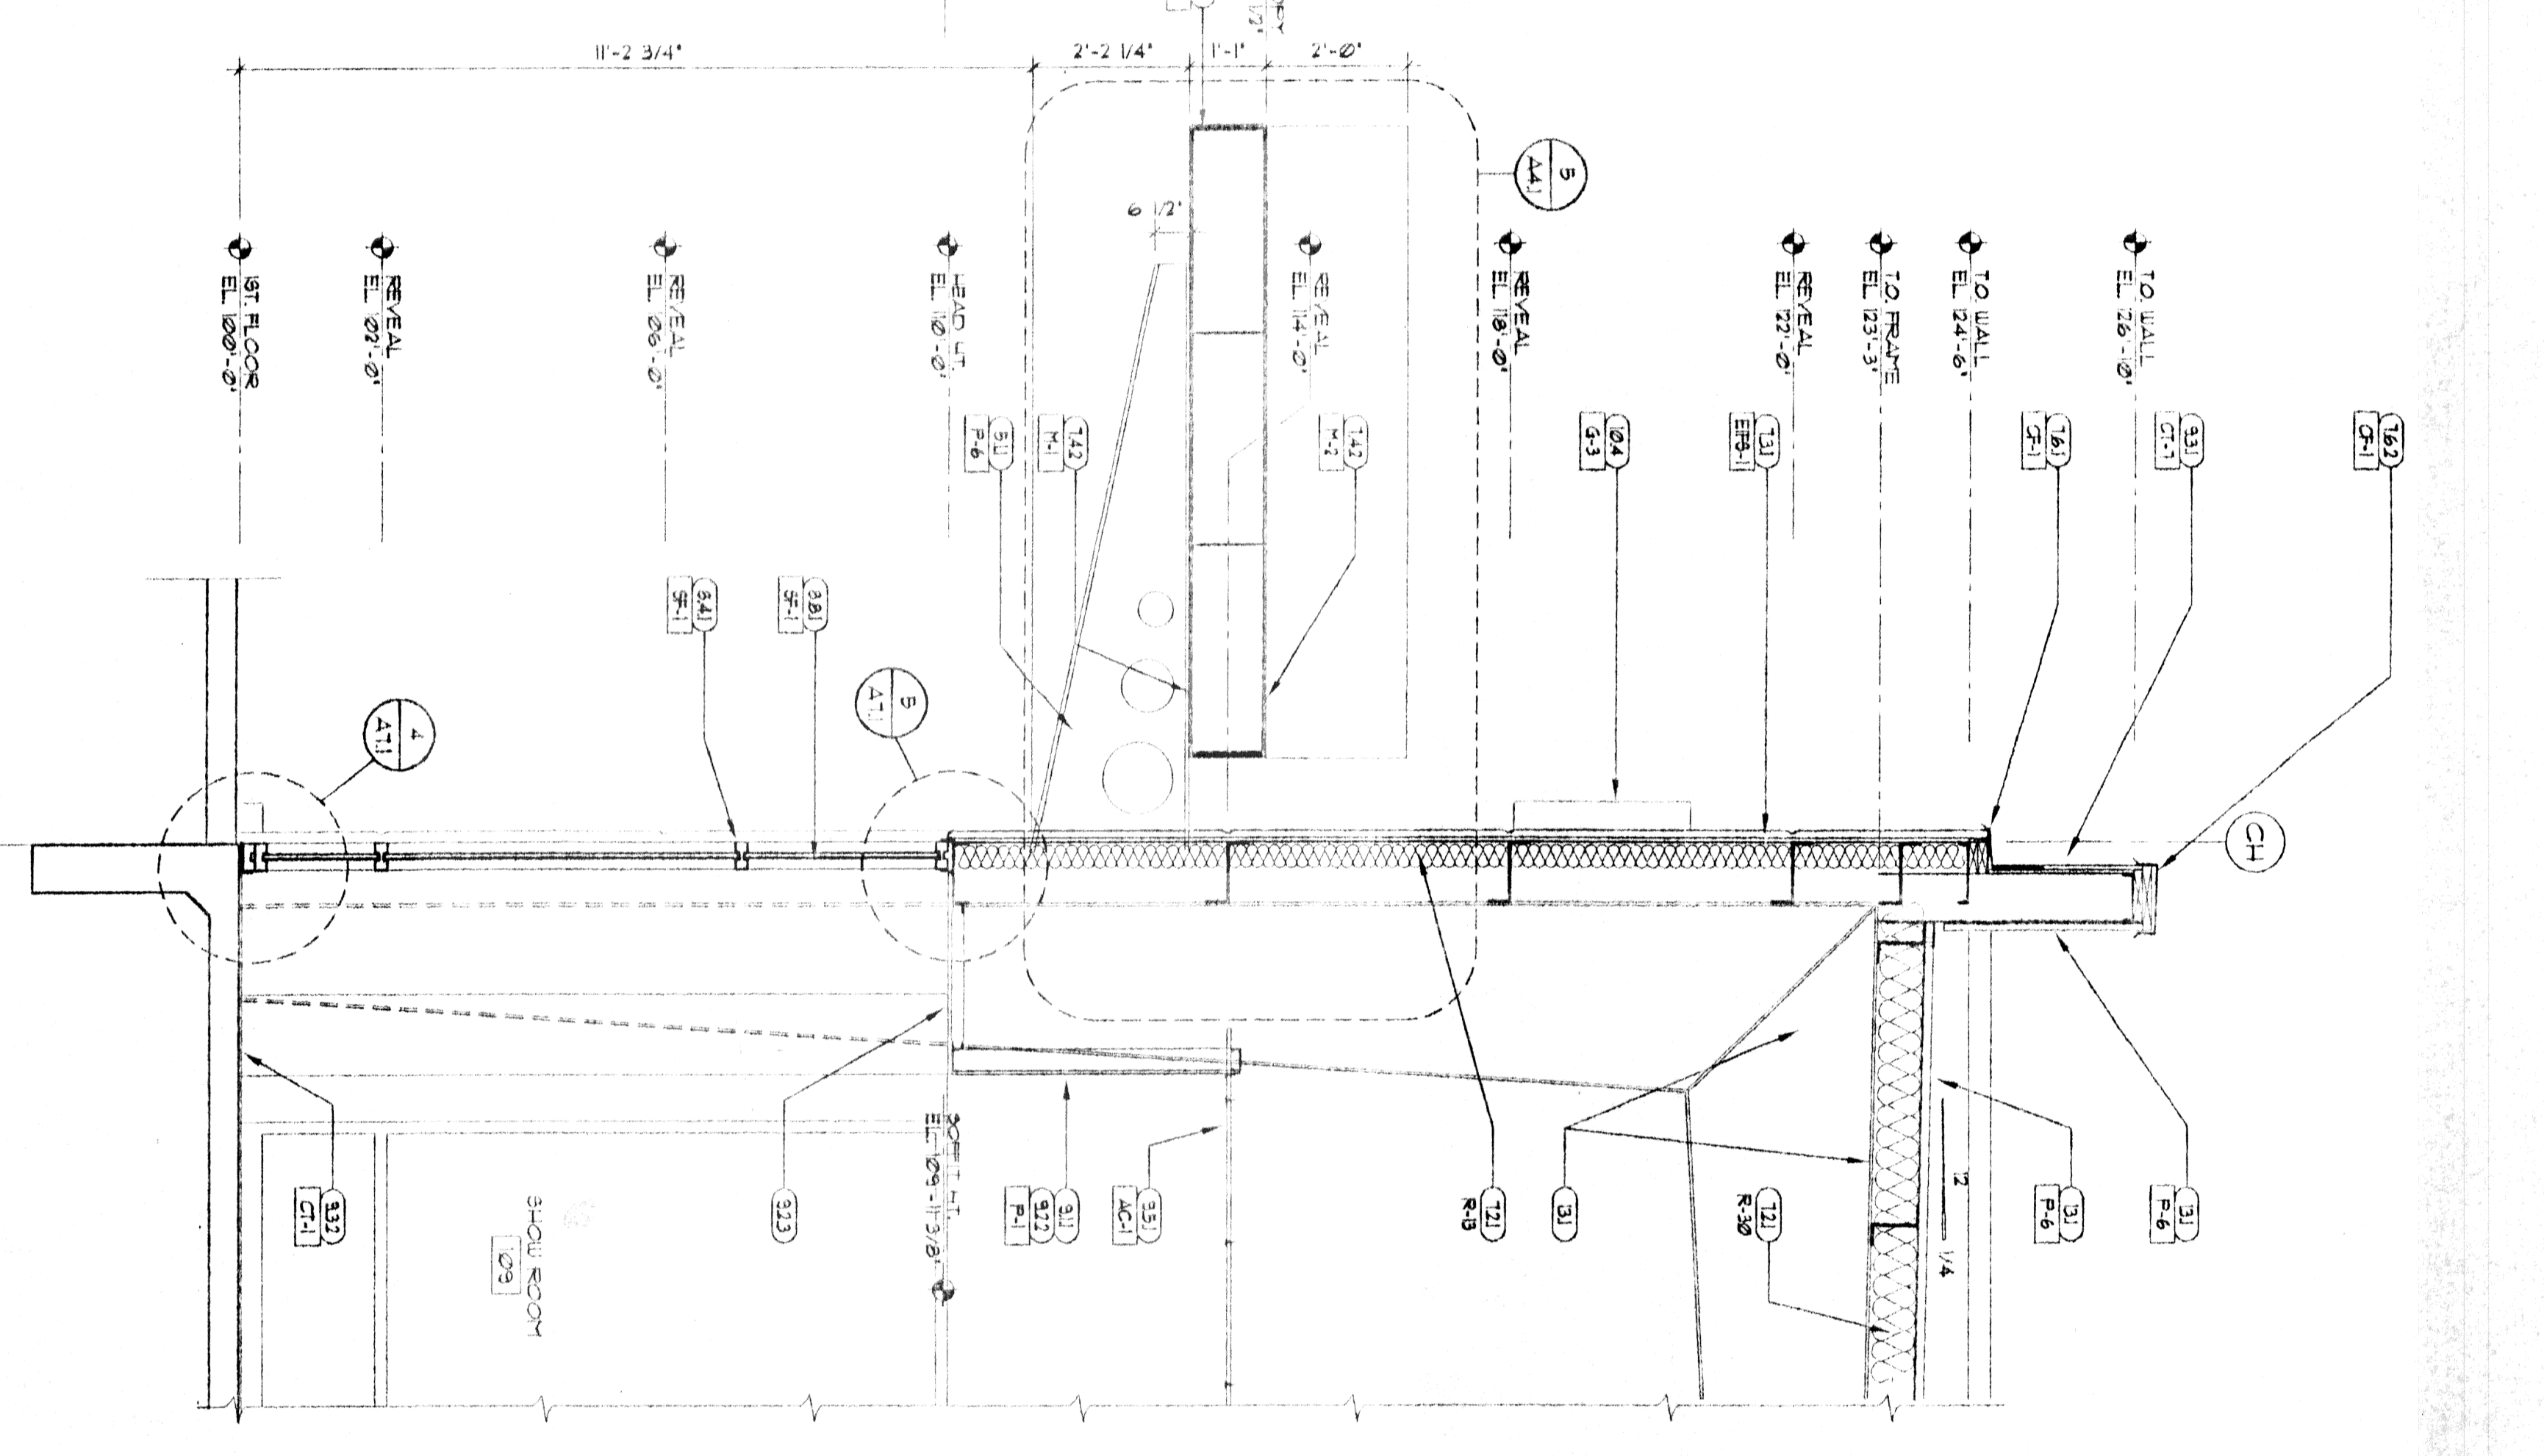

3 WALL SECTION
A4.1 1/2" = 1'-0"

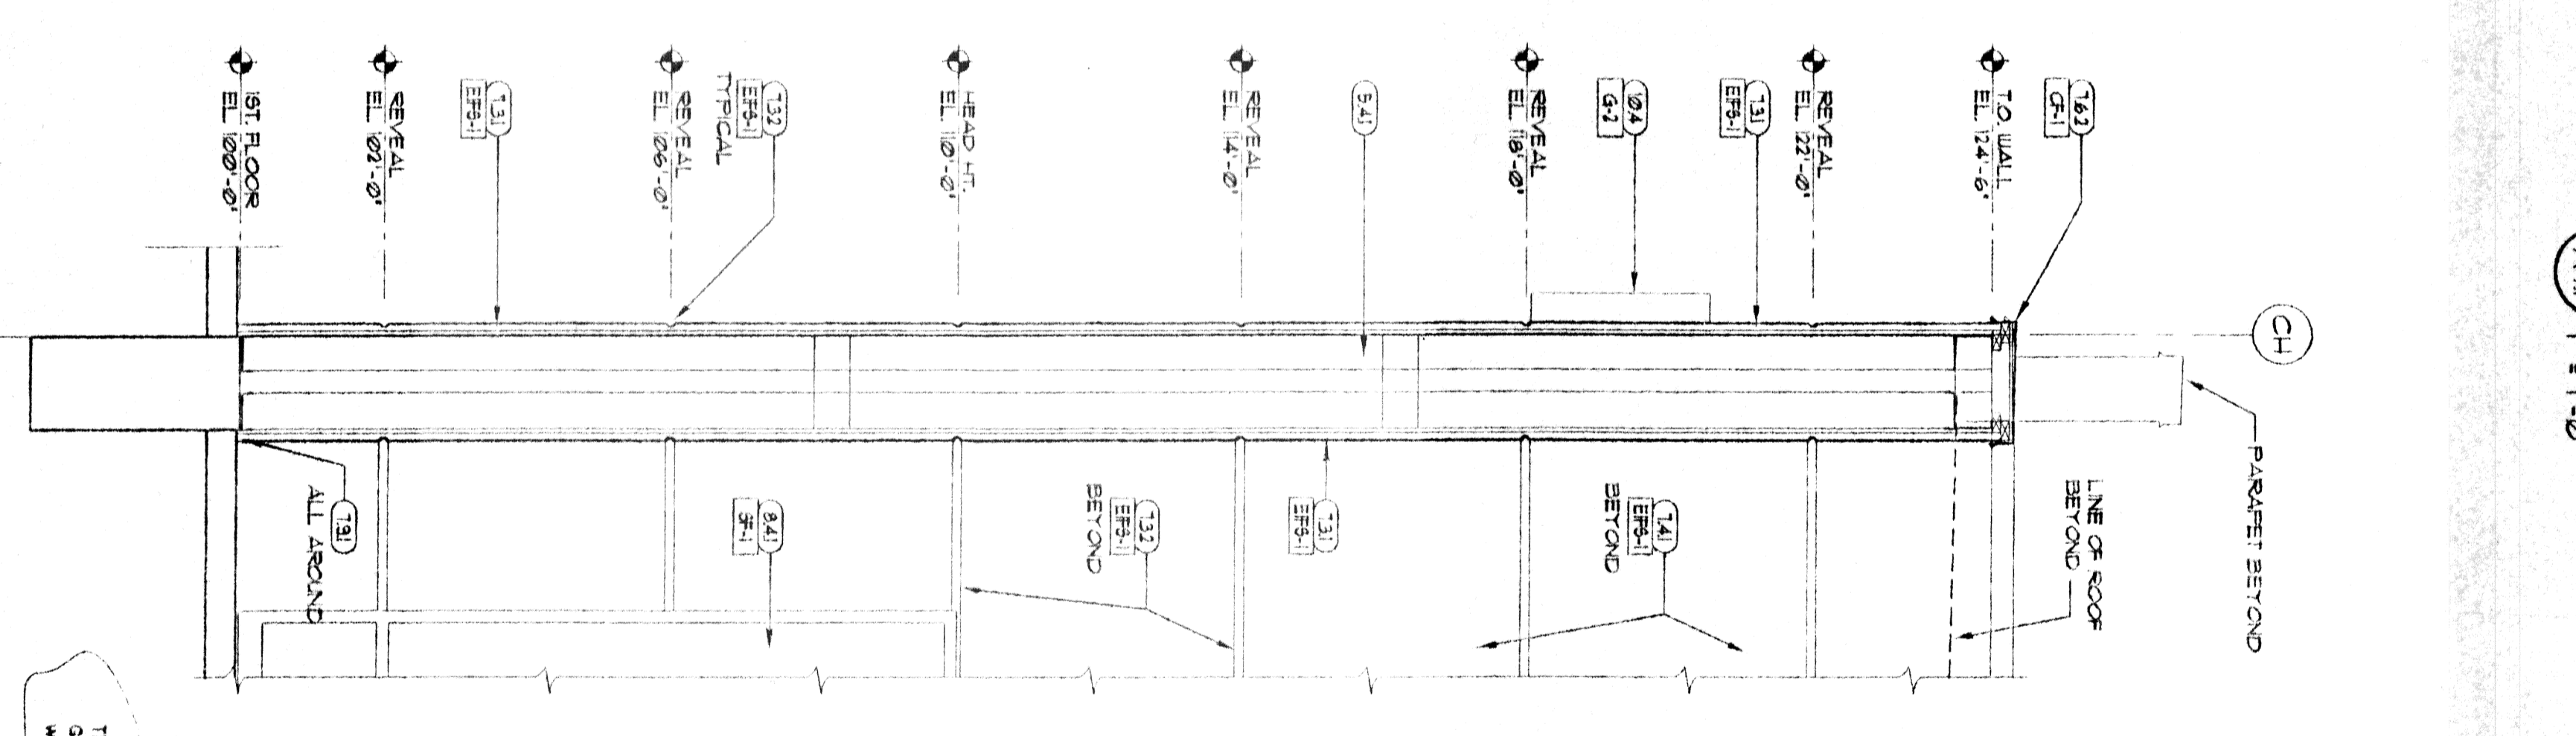

2 WALL SECTION
A4.1 1/2" = 1'-0"

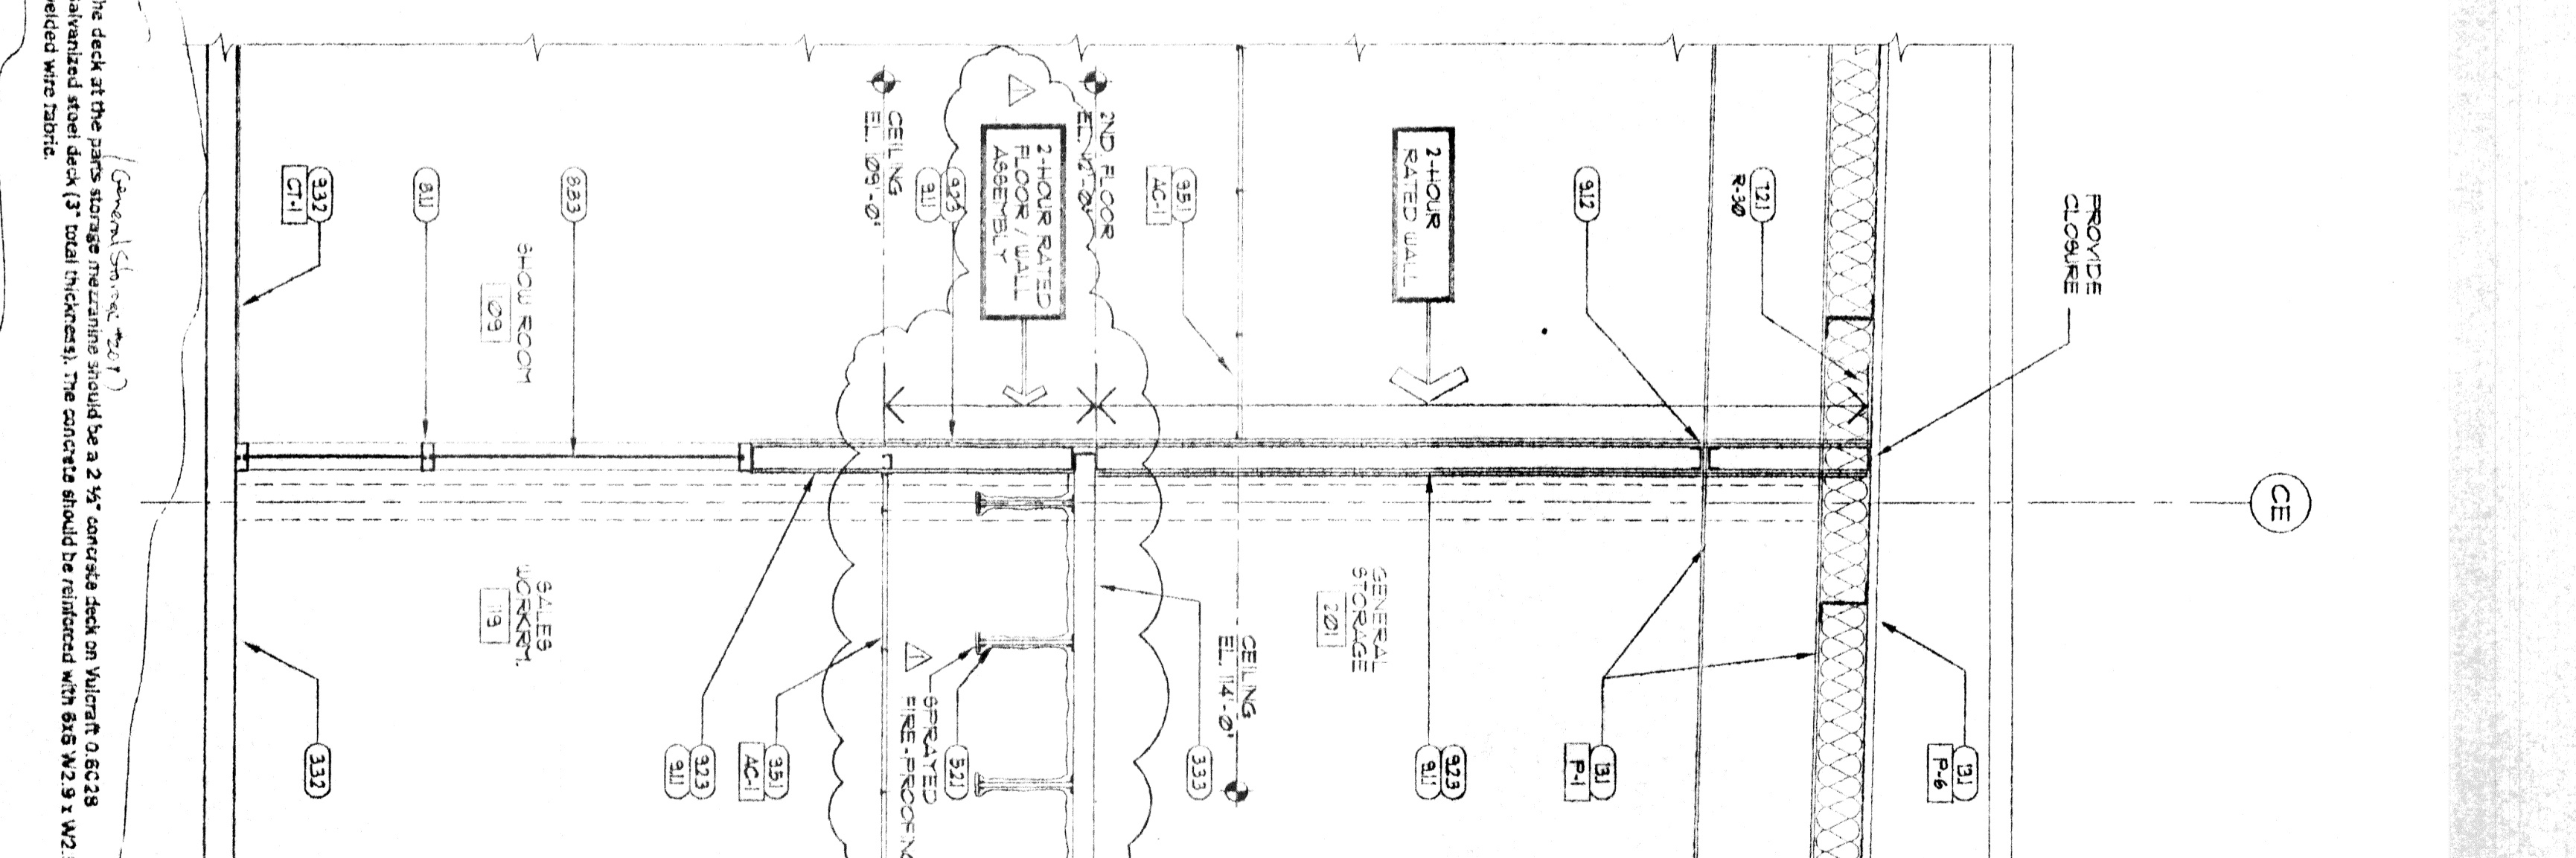

1 ENTRY SECTION
A4.1 1/2" = 1'-0"

- KEYED NOTES**
- (2.1) RE: CIVIL FOR EXTERIOR FINISH
 - (2.11) 1/2" DWP J/I

NOTE: REFER TO STRUCTURAL DRAWINGS FOR ALL FOUNDATIONS

RESUBMITTAL 3/10/03
DATE: 2/12/03
DRAWN BY: GBT/LW/WH
SCALE: AS NOTED
JOB NUMBER: 2002.1
DRAWING TITLE: WALL SECTIONS

HONDA OF SLIDELL
NEW FACILITY
SLIDELL, LA.

THOMAS PARTNERSHIP
ARCHITECTURE-PLANNING
3000 SOUTH VINE STREET, DENVER, COLORADO 80210 PHONE (303) 589-7504 FAX (303) 691-9790

A4.1