




5 CANOPY SECTION
A4.1 1/2" = 1'-0"

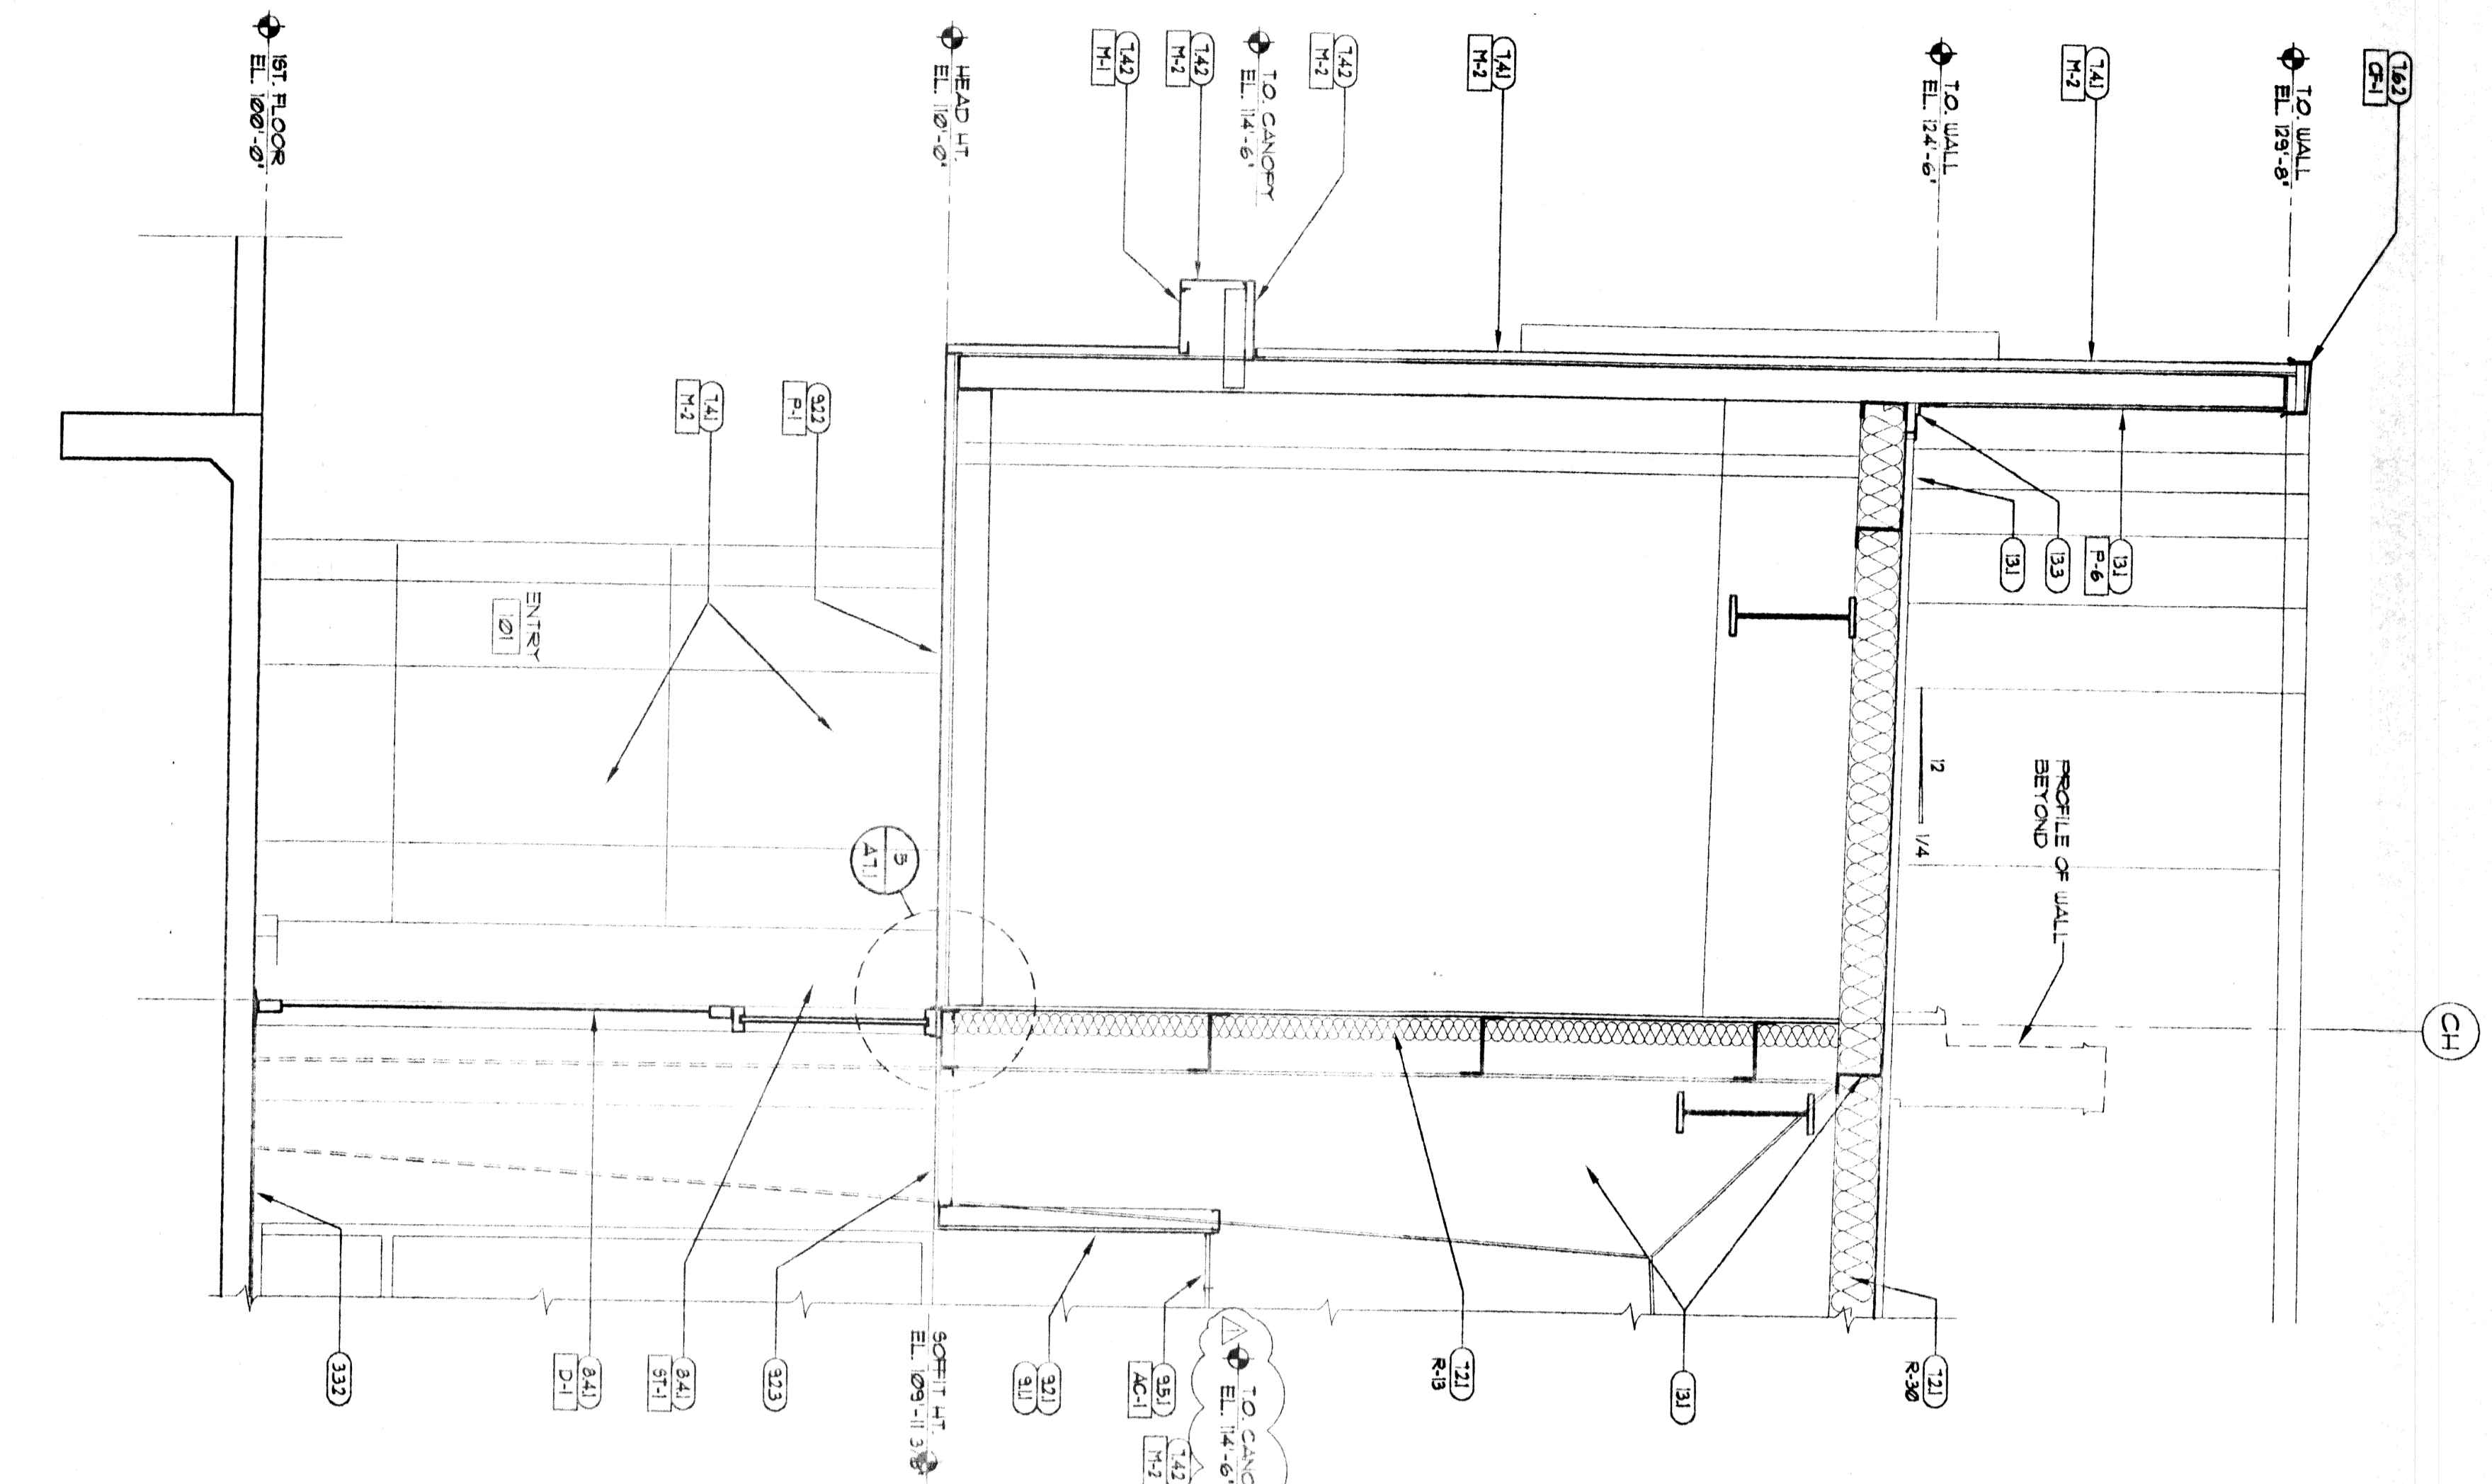

4 WALL SECTION
A4.1 1/2" = 1'-0"

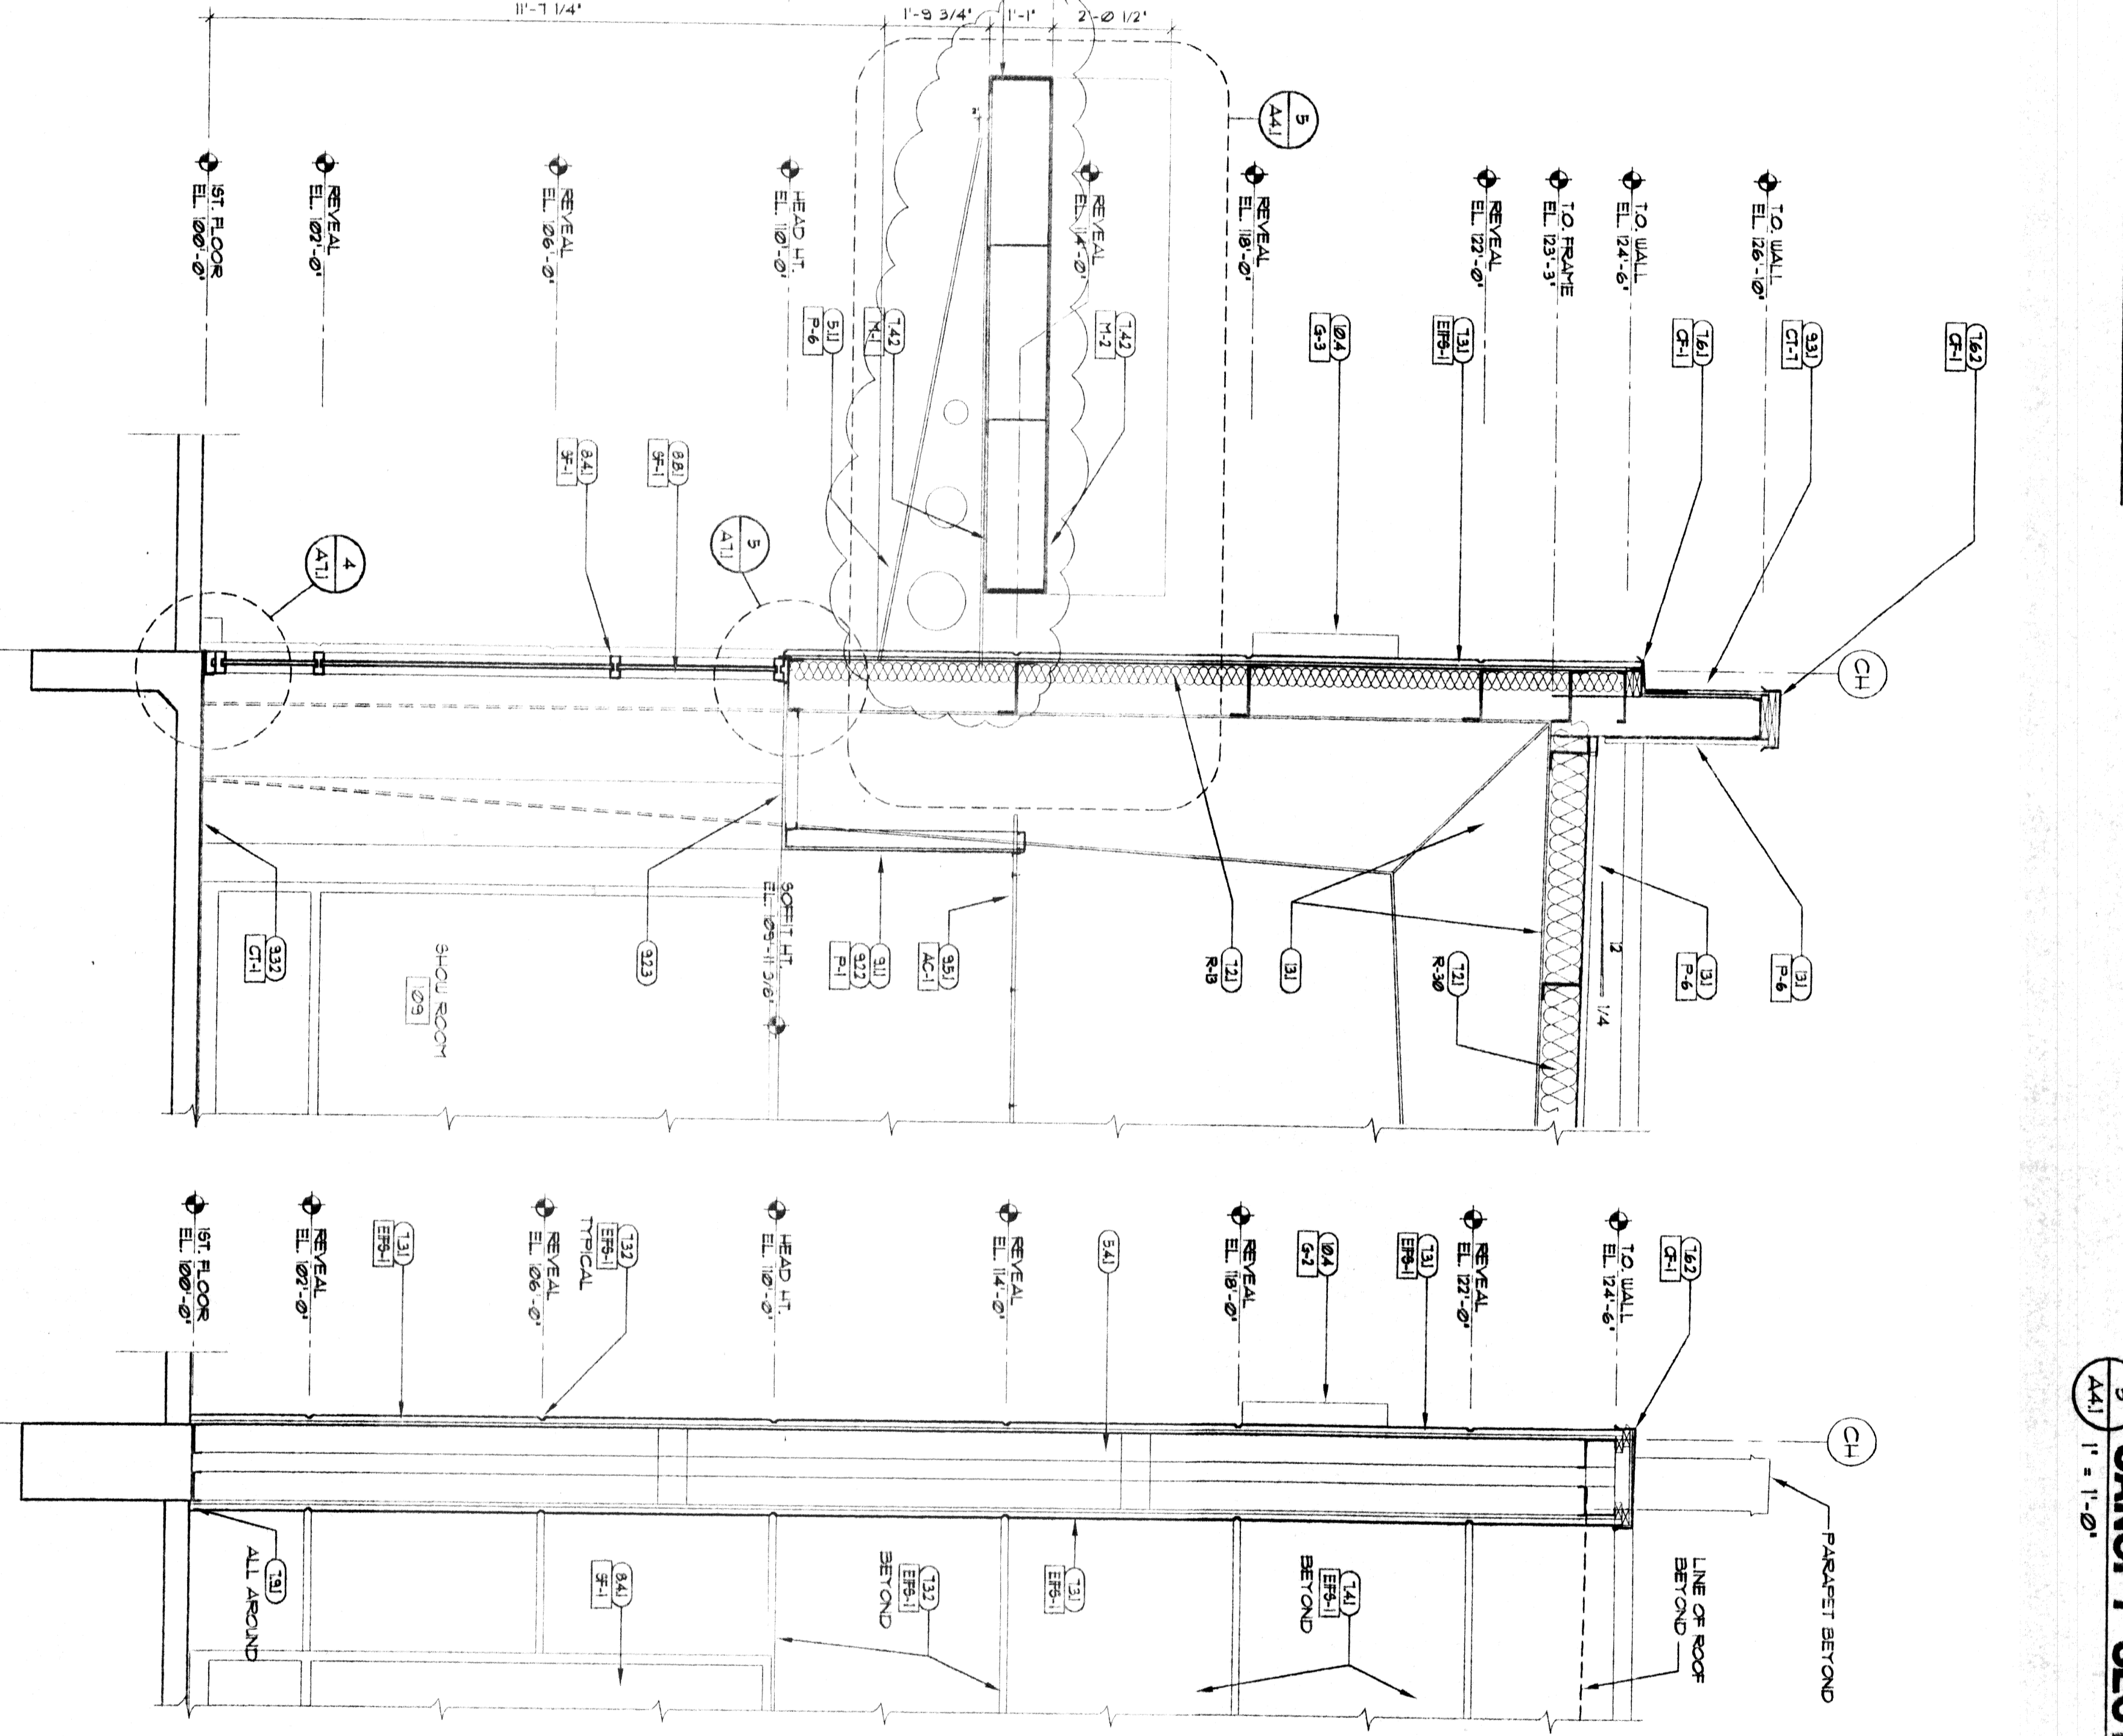

3 WALL SECTION
A4.1 1/2" = 1'-0"

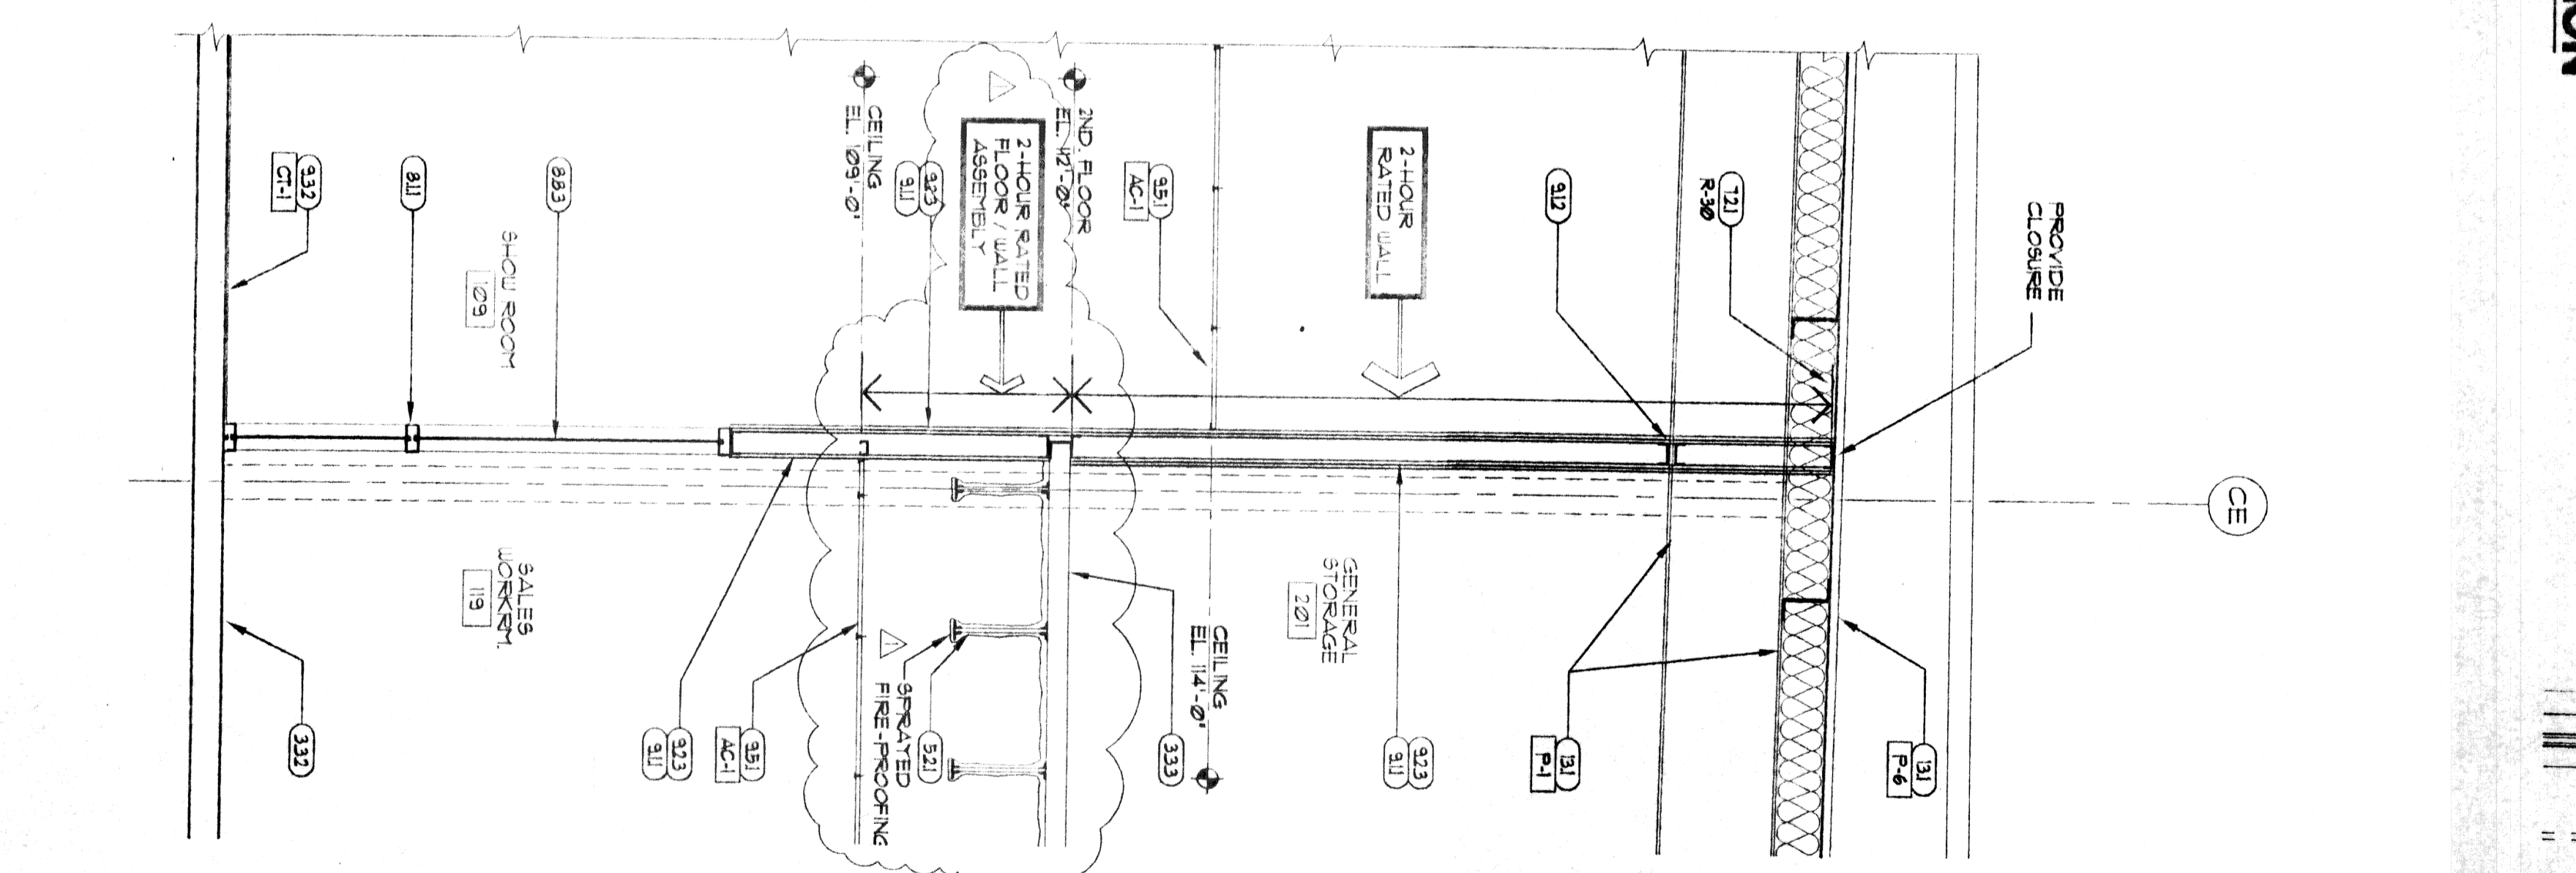

1 ENTRY SECTION
A4.1 1/2" = 1'-0"

- KEYED NOTES**
- (21) RE: CIVIL FOR EXTERIOR PAVING
 - (22) 1/2" EXP. JT.
 - (331) CONCRETE FOUNDATION RE: STRUCT.
 - (332) CONC SLAB ON PREPARED GRADE
 - (333) CONC FLOOR ON HTL DECK

- FOR CONSTRUCTION**
- NOTE: REFER TO STRUCTURAL DRAWINGS FOR ALL FOUNDATIONS
- OWNER: HONDA OF SLIDELL
CONTRACTOR: [REDACTED]
- DATE: 2/12/03
- ARCHITECT: THOMAS PARTNERSHIP ARCHITECTURE-PLANNING
- REVISION 3/8/03
- DRAWN BY: CBT/JW/WH
SCALE: AS NOTED
- JOB NUMBER: 2002.1
WALL SECTIONS

THOMAS PARTNERSHIP
ARCHITECTURE-PLANNING

3000 SOUTH VINE STREET, DENVER, COLORADO 80210 PHONE (303) 569-7504 FAX (303) 691-9790

HONDA OF SLIDELL
NEW FACILITY
SLIDELL, LA.

A4.1