


1 UPPER LVL. STAIR - RM. 150
1/4" = 1'-0"

6 BREAK RM. & STAIR - RMS. 122, 150
1/4" = 1'-0"


5 STAIR SECTION
3/8" = 1'-0"

TOILET ACCESSORY LIST - 10800



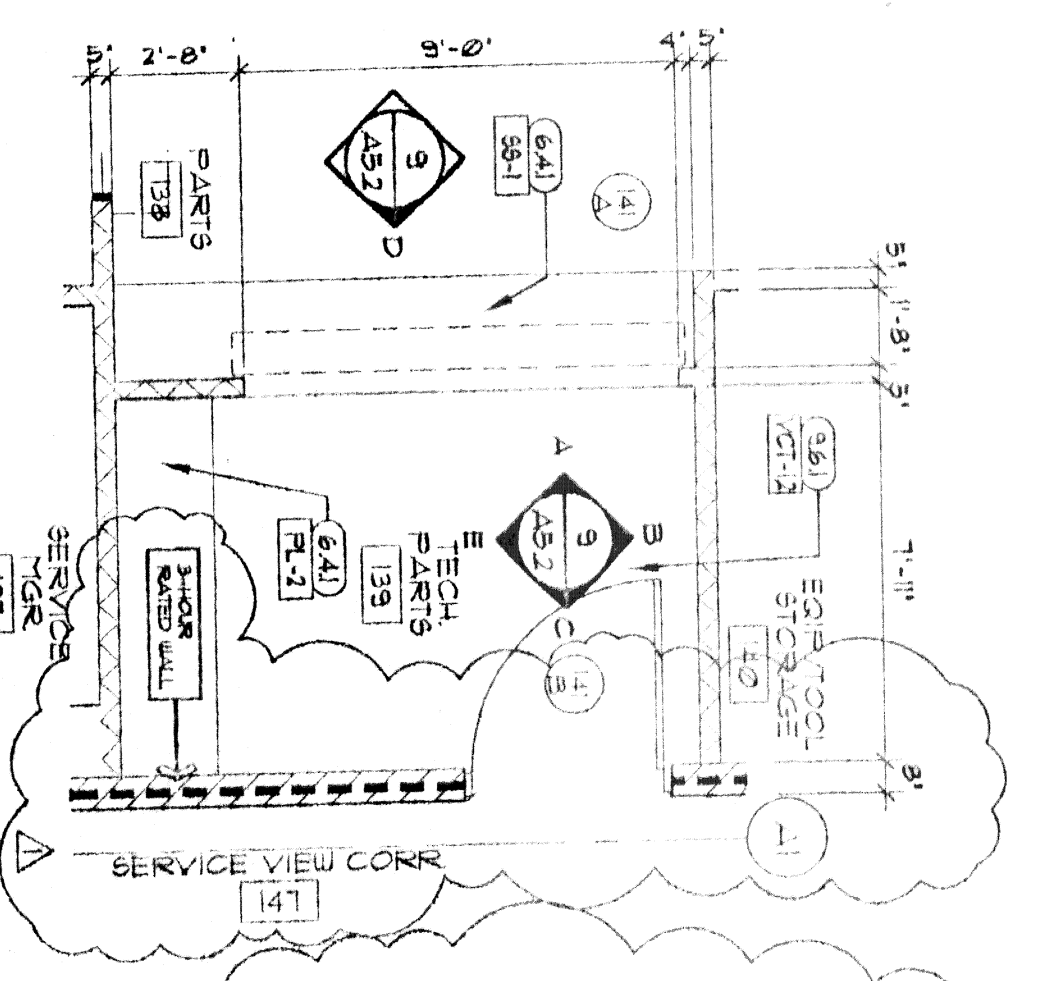


4 TECH. PARTS - RM. 139
1/4" = 1'-0"

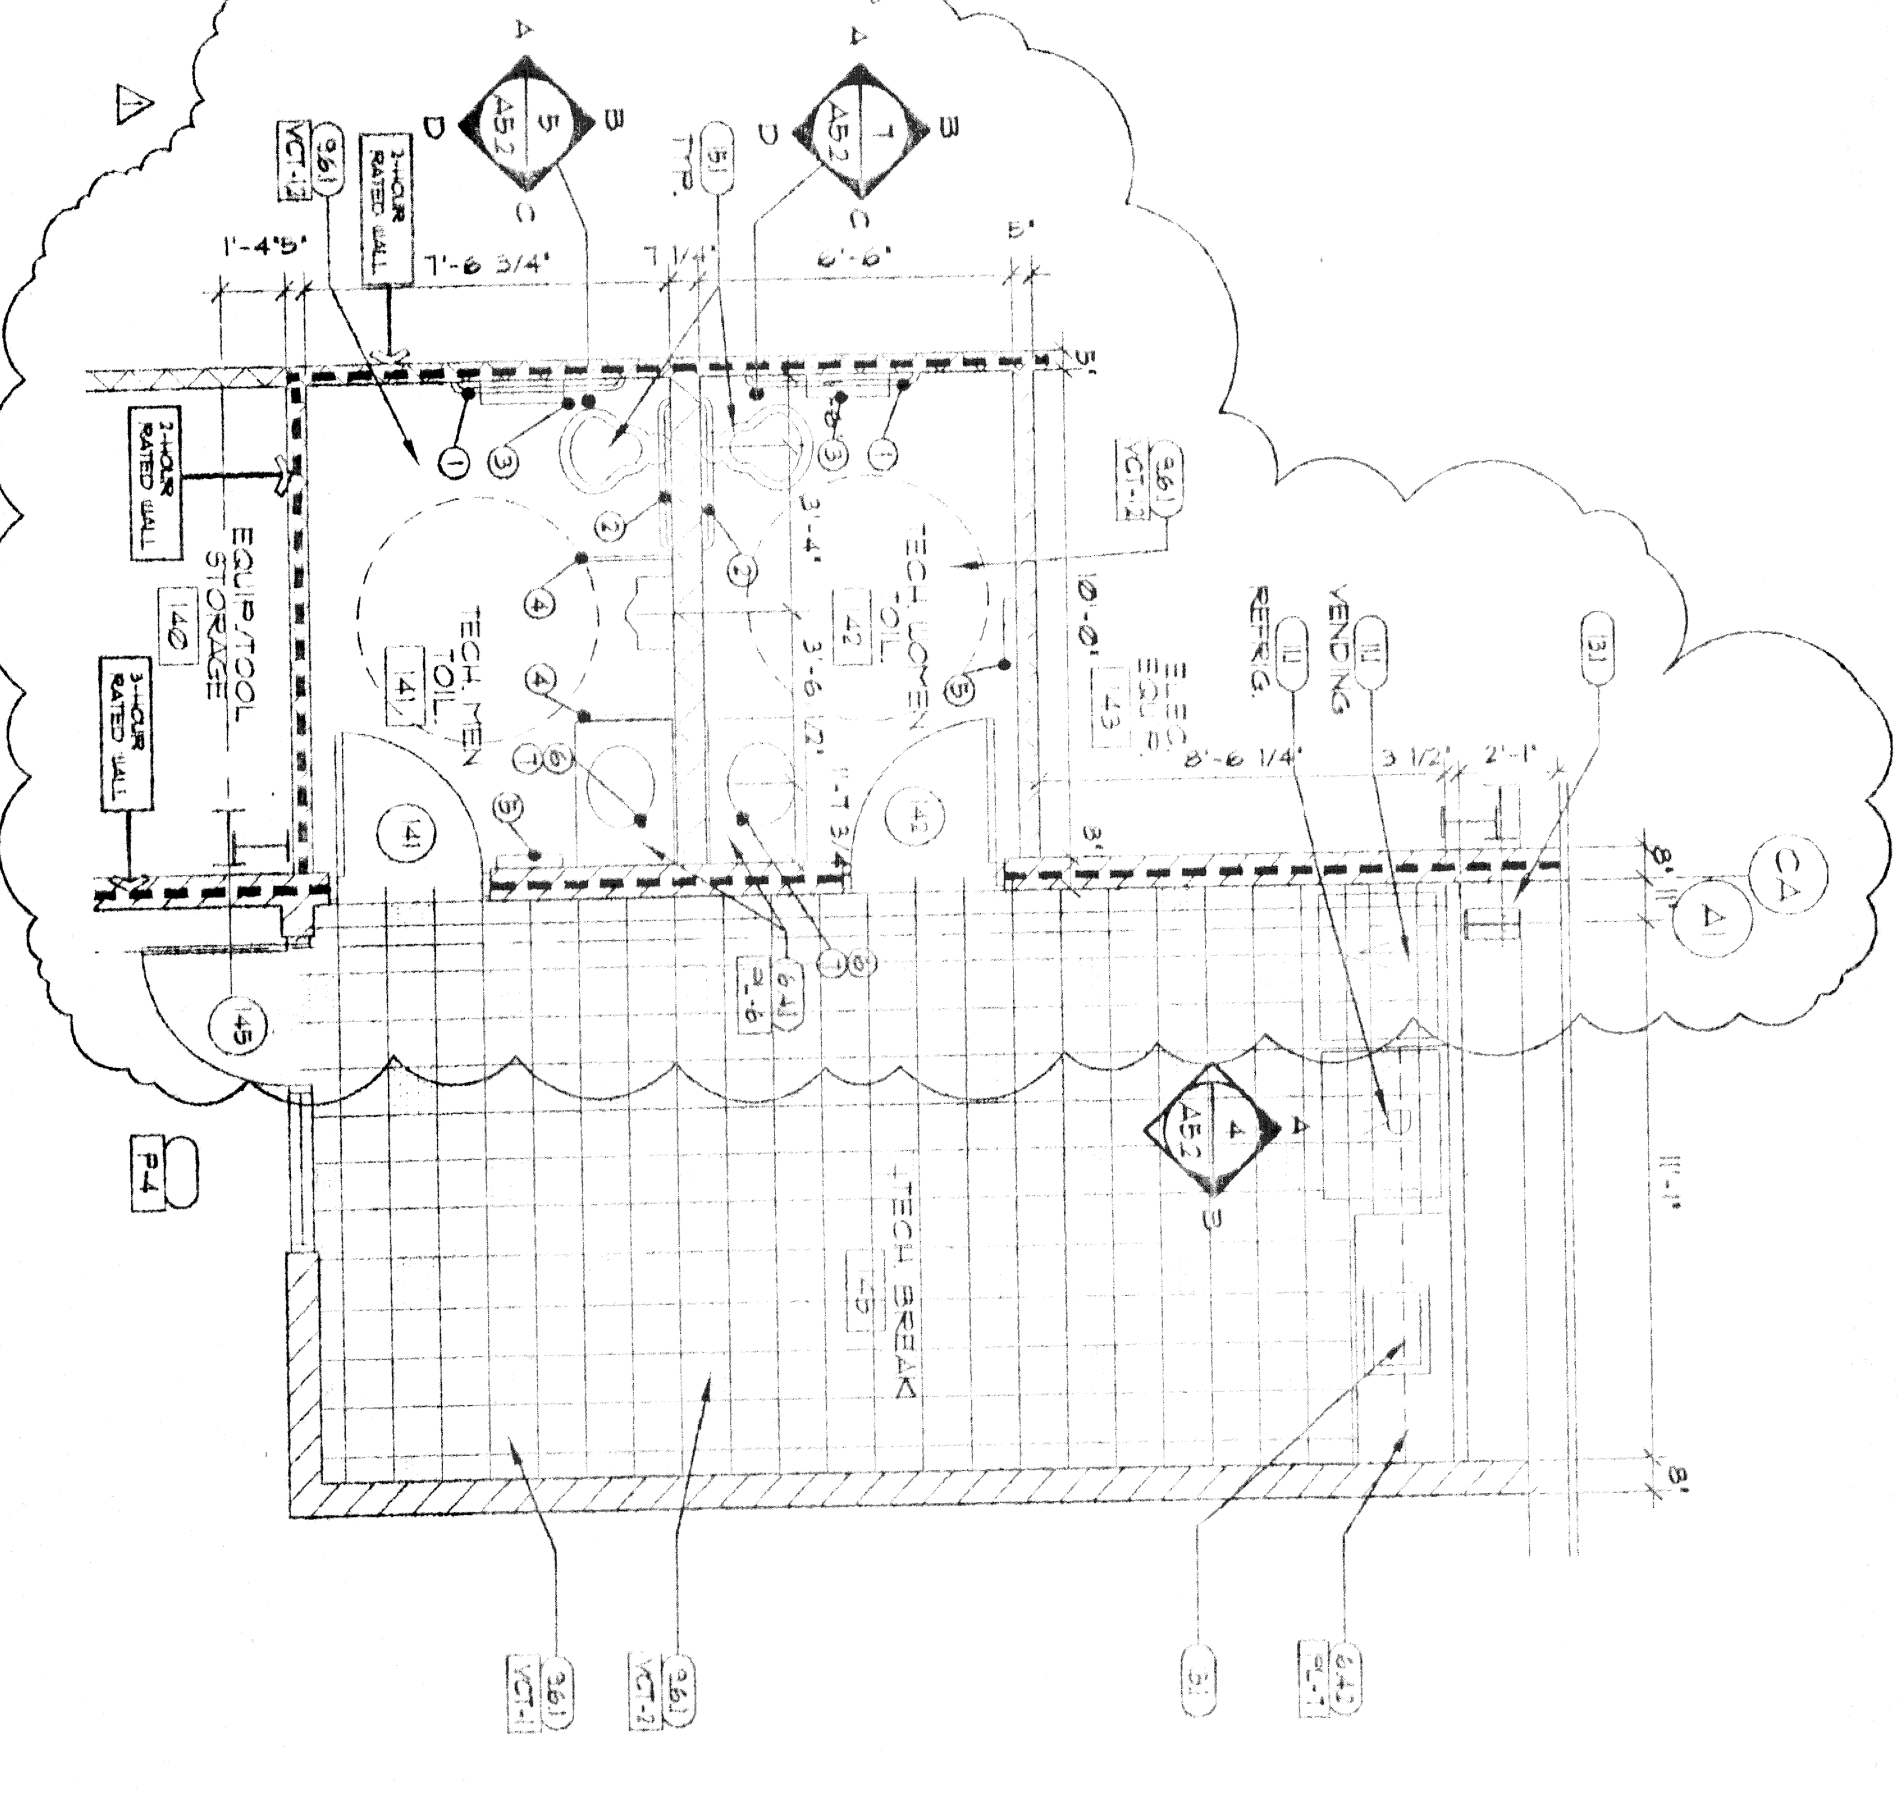

3 TECH. BREAK/TOILETS - RMS. 141, 142, 145
1/4" = 1'-0"

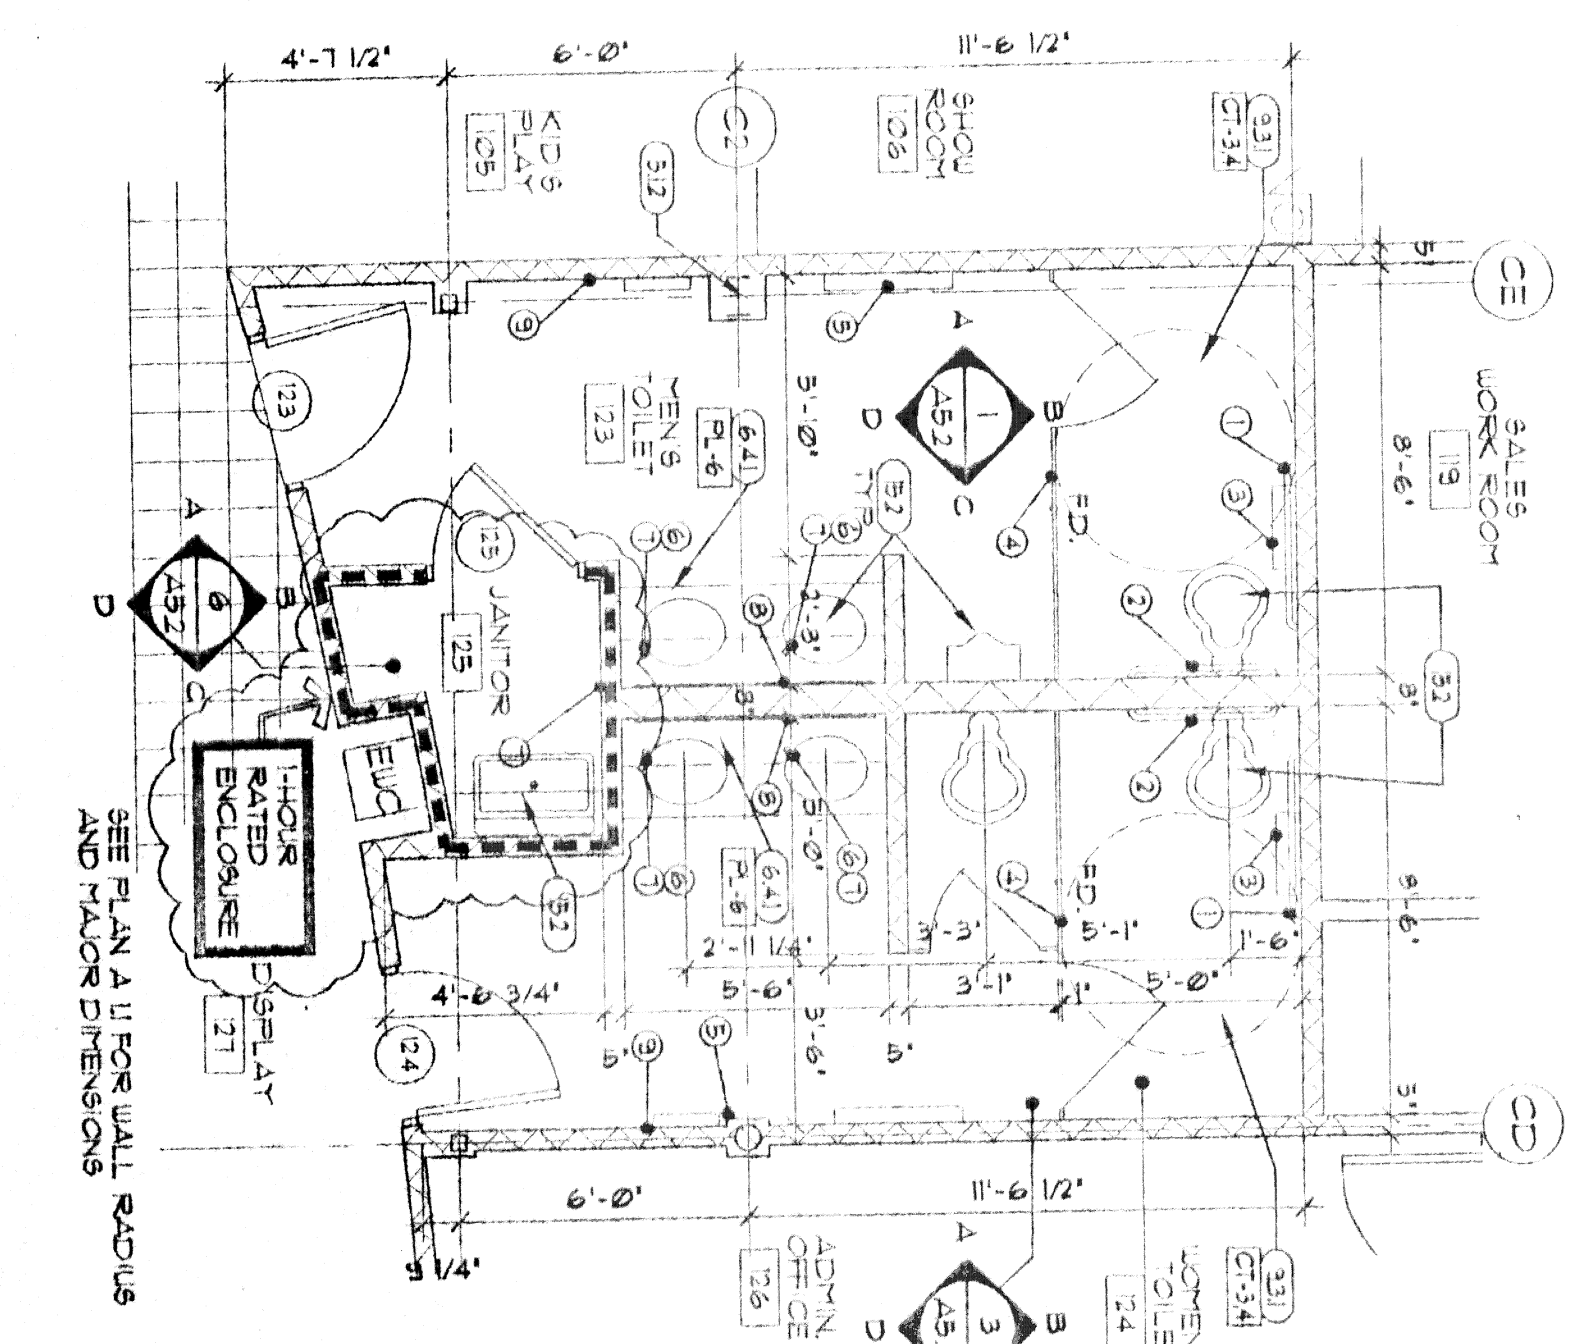

2 PUBLIC TOILETS - RMS. 123, 124
1/4" = 1'-0"

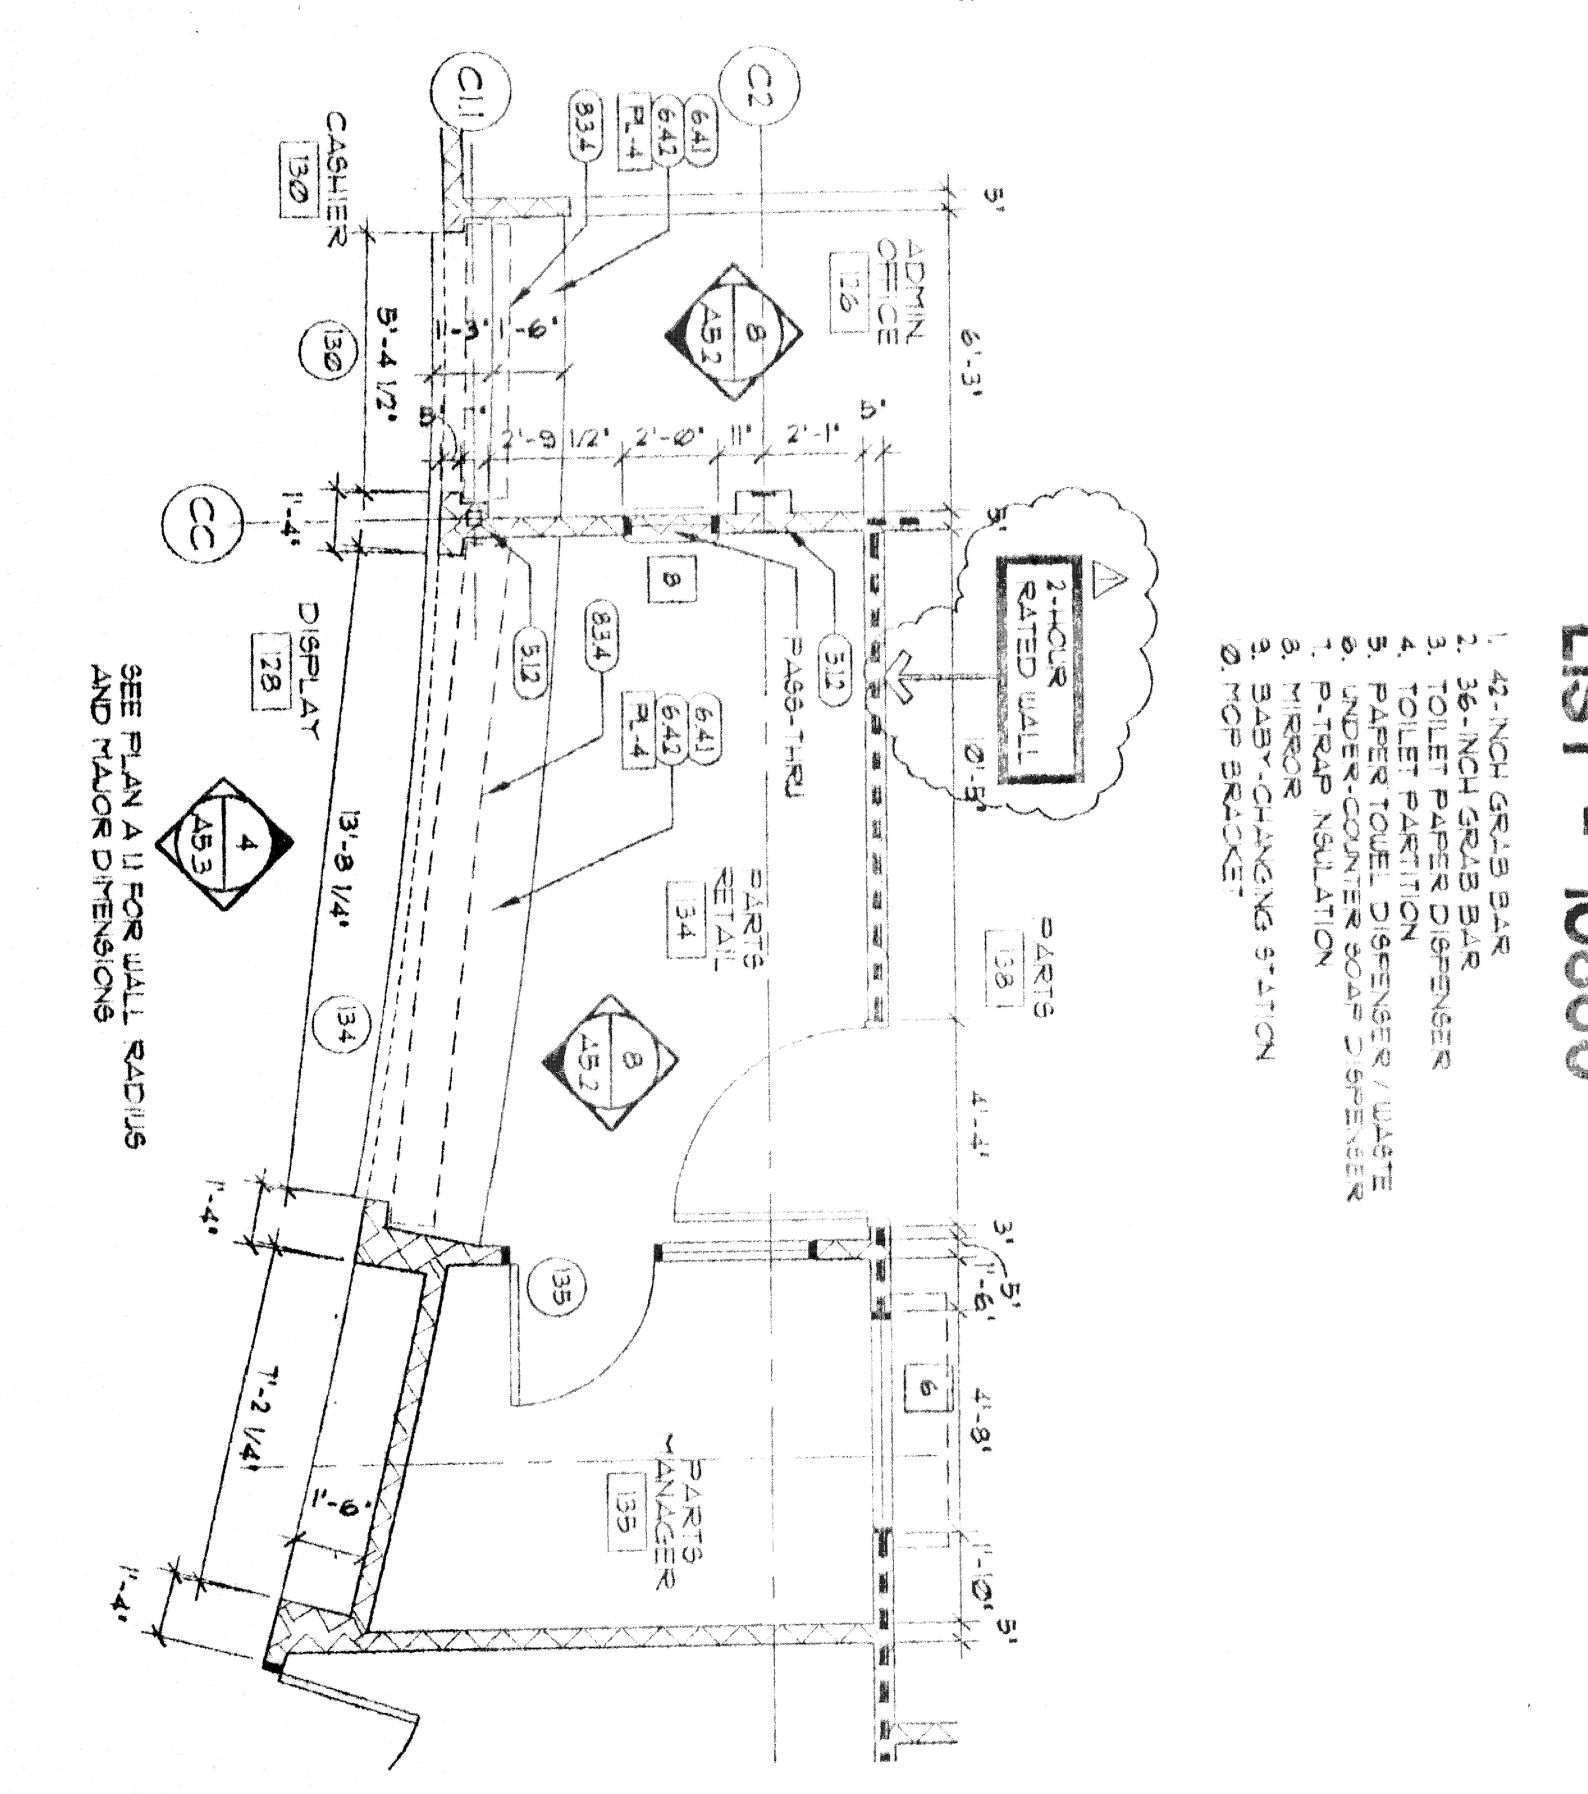

1 CASHIER/RETAIL PARTS - RMS. 130, 135
1/4" = 1'-0"

KEYED NOTES

- (21) REB. CIVIL FOR EXTERIOR PAVING
- (213) 1/2" EXP. JT.
- (333) CONCRETE FOUNDATION REB. STRUCT.
- (333) CONC. SLAB ON PRECAST GRADE
- (333) CONC. FLOOR ON HLL. DECK
- (42) CHU WALL REB. STRUCT FOR REIN.
- (312) STEEL COLUMN REB. STRUCT.
- (312) STEEL BEAM REB. STRUCT.
- (312) STEEL JOIST REB. STRUCT.
- (333) STEEL DECK REB. STRUCT.
- (333) COLD FORMED STEEL PAVING REB. STRUCT.
- (522) 5/8" GPM SHEATHING
- (523) AIR INFILTRATION BARRIER
- (531) STEEL STAMPS
- (532) 1/2" DRIFT PIN, FIRE BRACKET, MINOR WALL
- (611) 6" DIA. FIRE BOLLARD
- (613) WOOD BLOOD-CURATION CORER
- (622) PLAS. LAM. COUNTERTOP
- (623) PLAS. LAM. CABINETS
- (623) WOOD SHELVES
- (713) BATT INSUL. UNLESS REQUIRED, SEE SECTIONS
- (733) ACoustICAL BATT INSULATION
- (733) EIPA. HEADC. ATTACH
- (733) HONDA COLOR COMPOSITE METAL PANELS
- (743) HONDA CANTY/ LAME
- (762) 3/4" GAL. SALT. SHT. TYP. CORRUG.
- (783) BEALANT JOINT
- (811) HLT. DOOR AND FRAME
- (811) 6C WOOD DOOR
- (832) ACCESS PANEL
- (832) COLLING FINE DOOR-LHR
- (832) OVERHEAD SECTIONAL DOOR
- (832) COLLING CENTER SHUTTER
- (832) ANOD. ALUM. STROGEMONT/ SHIMAWAY/UNICO
- (832) ANOD. ALUM. STROGEMONT TO MATCH STROGEMONT FINISH
- (832) 1" LOW E. GLAZING
- (832) 1/4" CLEAR GLAZING
- (832) REB. ELEC. FOR LIGHTING

THOMAS PARTNERSHIP
ARCHITECTURE-PLANNING

3000 SOUTH VINE STREET, DENVER, COLORADO 80210 PHONE (303) 589-7504 FAX (303) 691-9790

HONDA OF SLIDELL
NEW FACILITY
SLIDELL, LA.

RESUBMITTAL 3/10/03
DATE: 2/12/03
DRAWN BY: CBH/JWH
SCALE: AS NOTED
JOB NUMBER: 20021
DRAWING TITLE: ENLARGED PLANS, SECTIONS

A5.1