




9 TECH. PARTS 141 ELEVATIONS
1/4" = 1'-0"

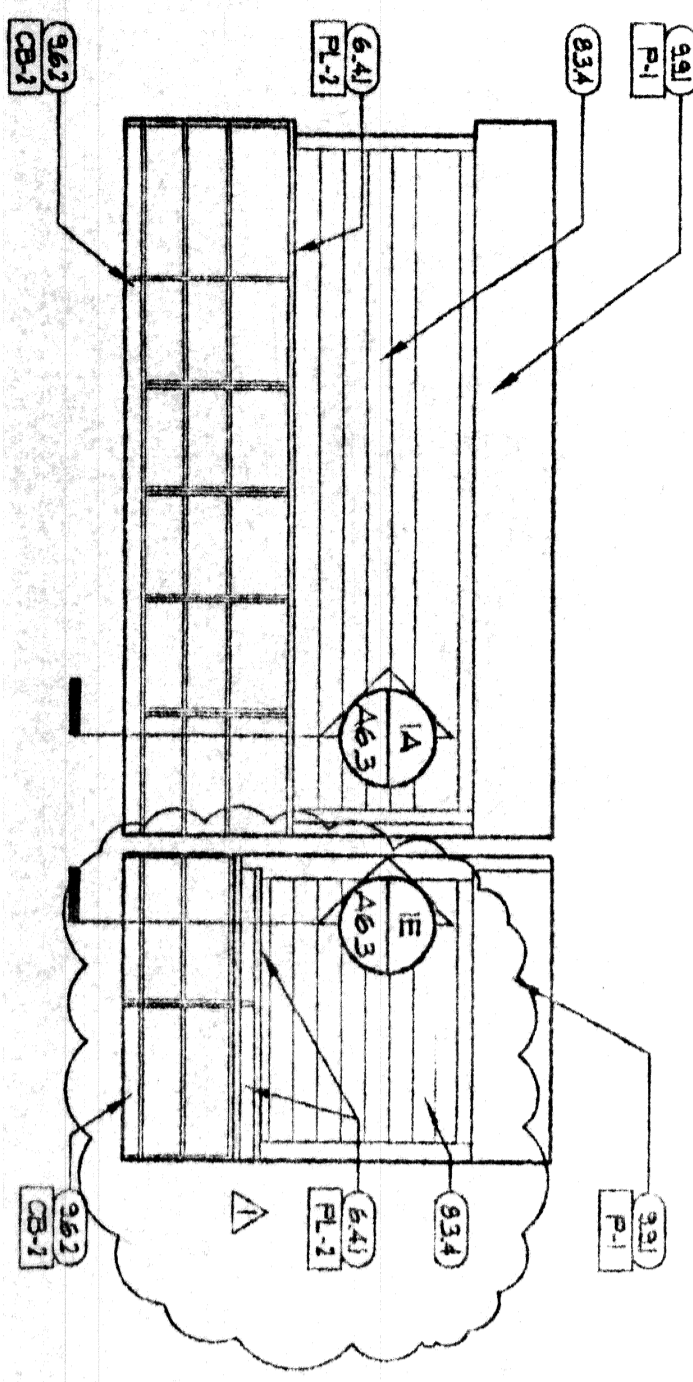


8 CASHIER AND RETAIL PARTS 130, 135
COUNTER ELEVATIONS
1/4" = 1'-0"

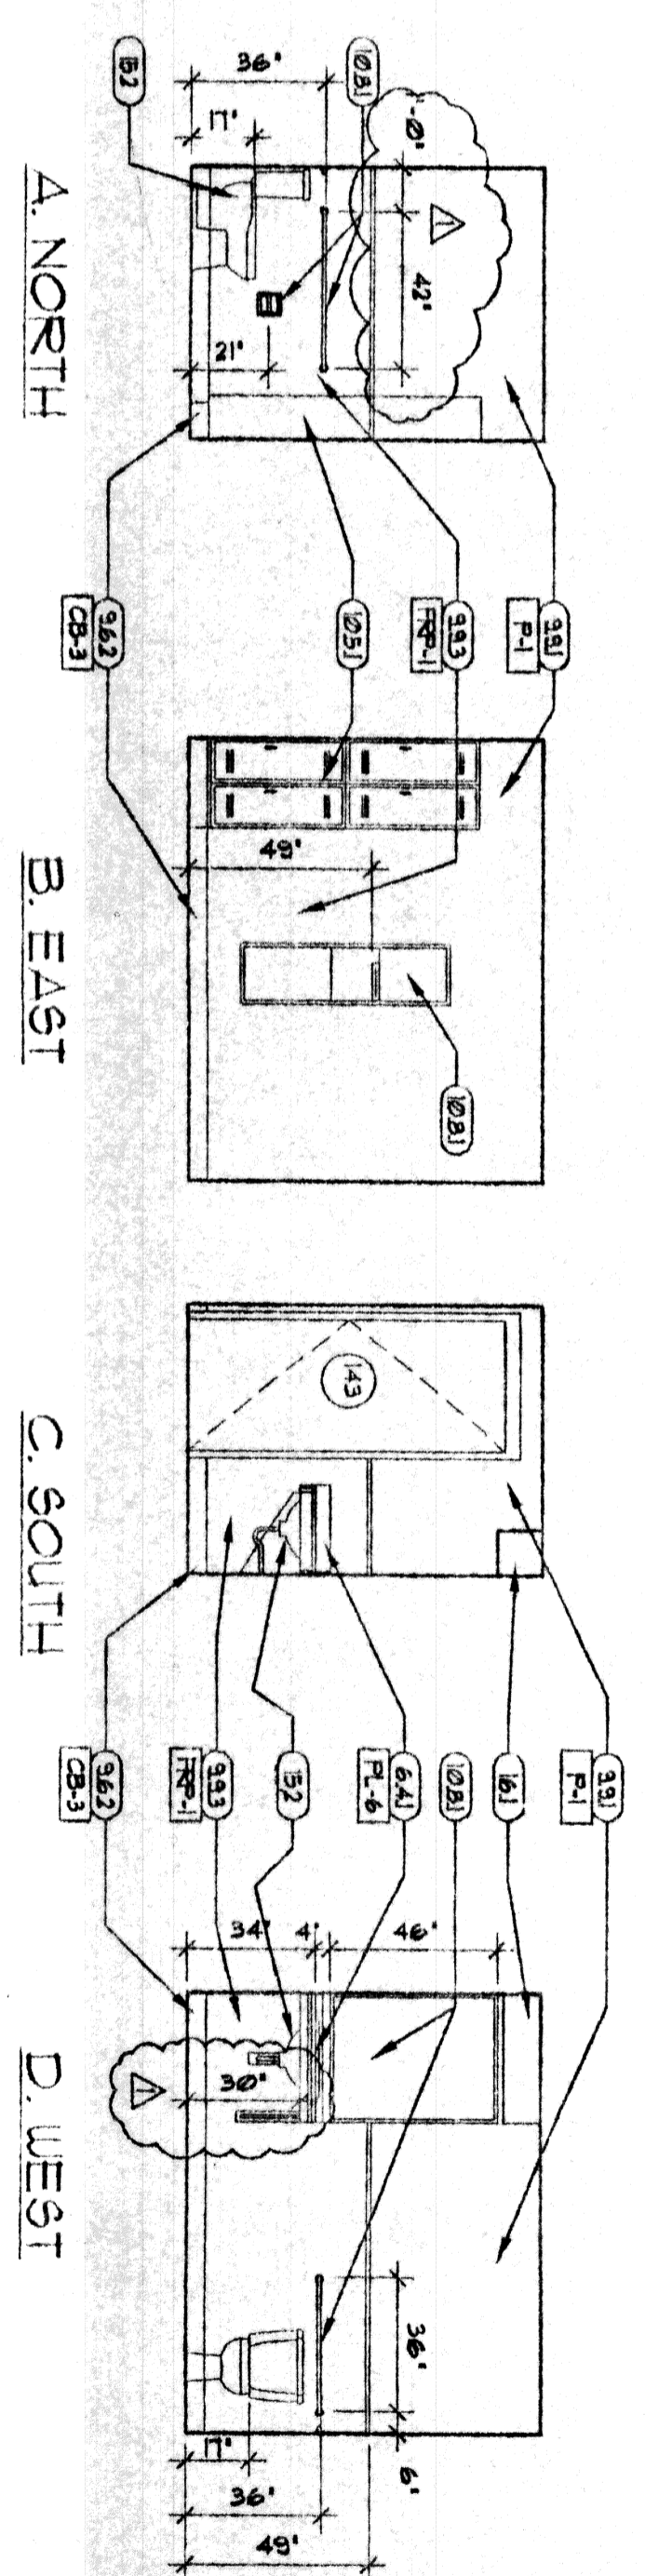


7 TECH. WOMEN'S TOILET 142 ELEVATIONS
1/4" = 1'-0"

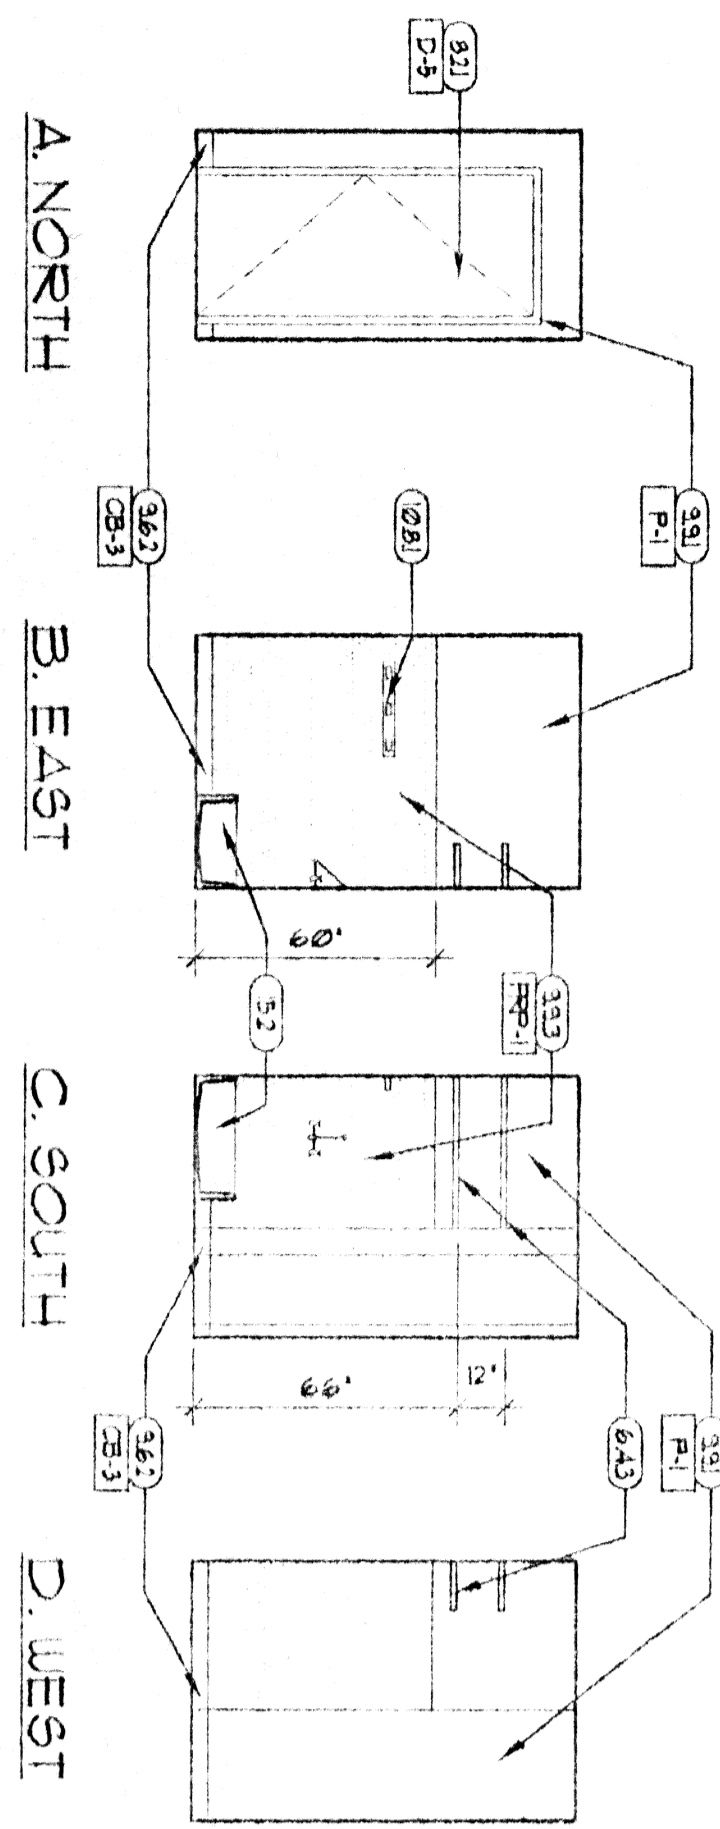


6 JANITOR CLOSET 125 ELEVATIONS
1/4" = 1'-0"

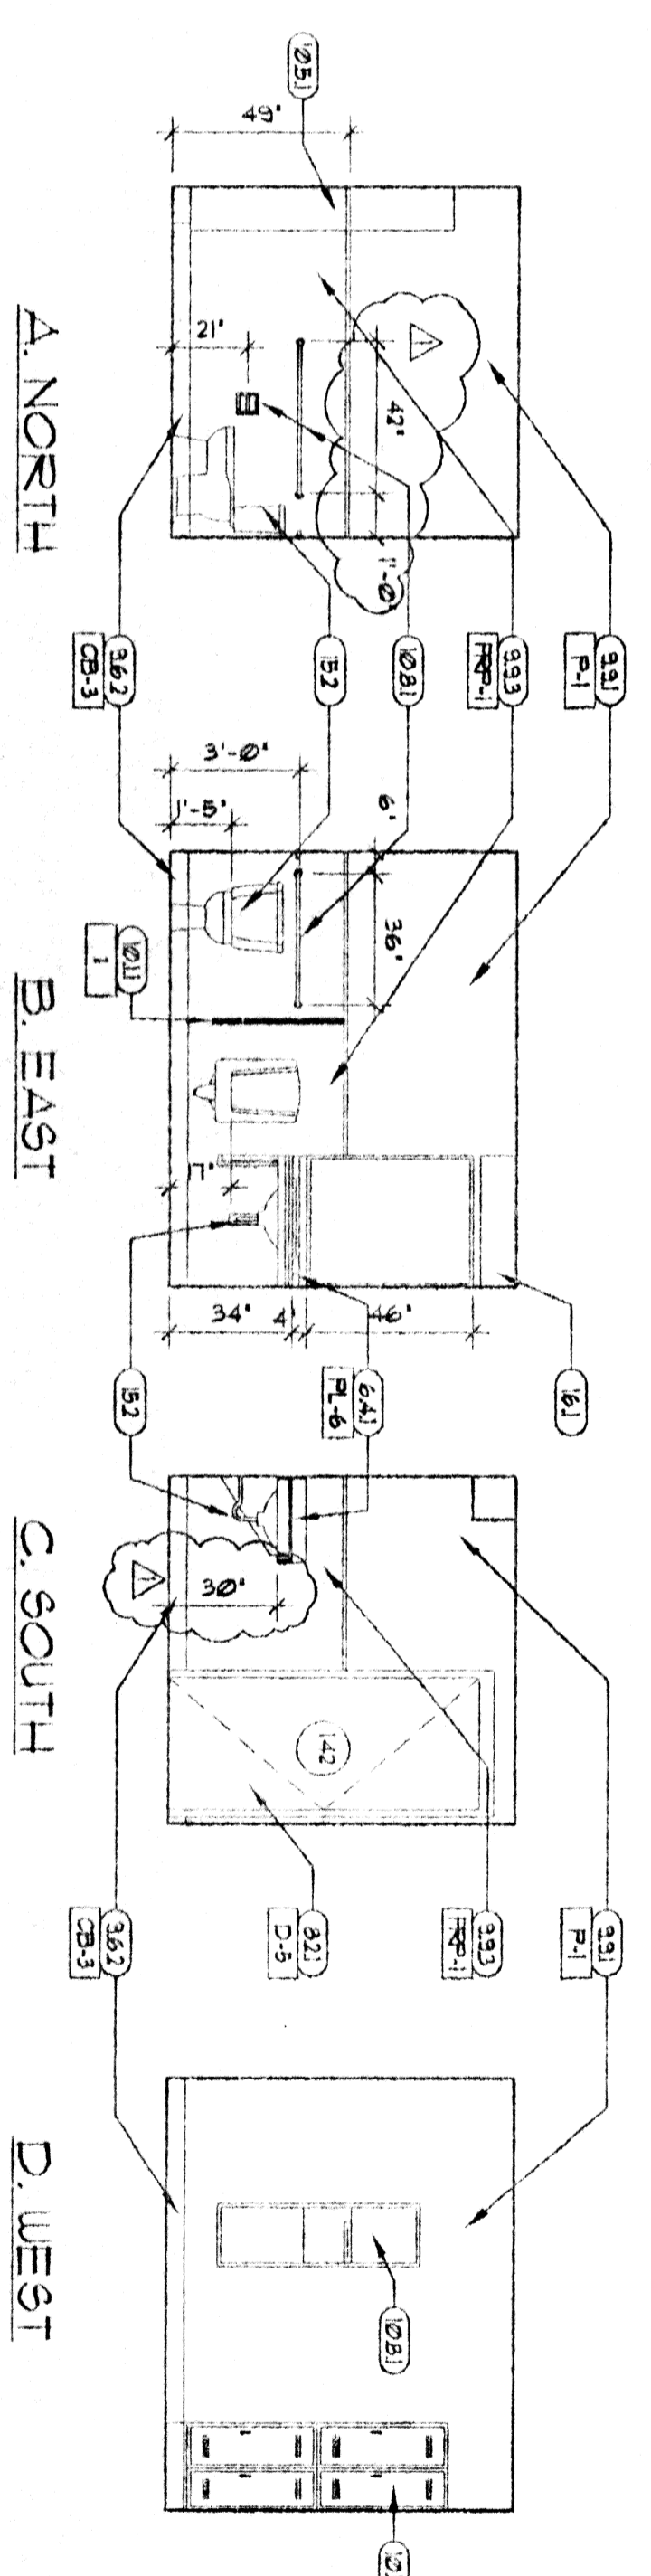


5 TECH. MEN'S TOILET 141 ELEVATIONS
1/4" = 1'-0"

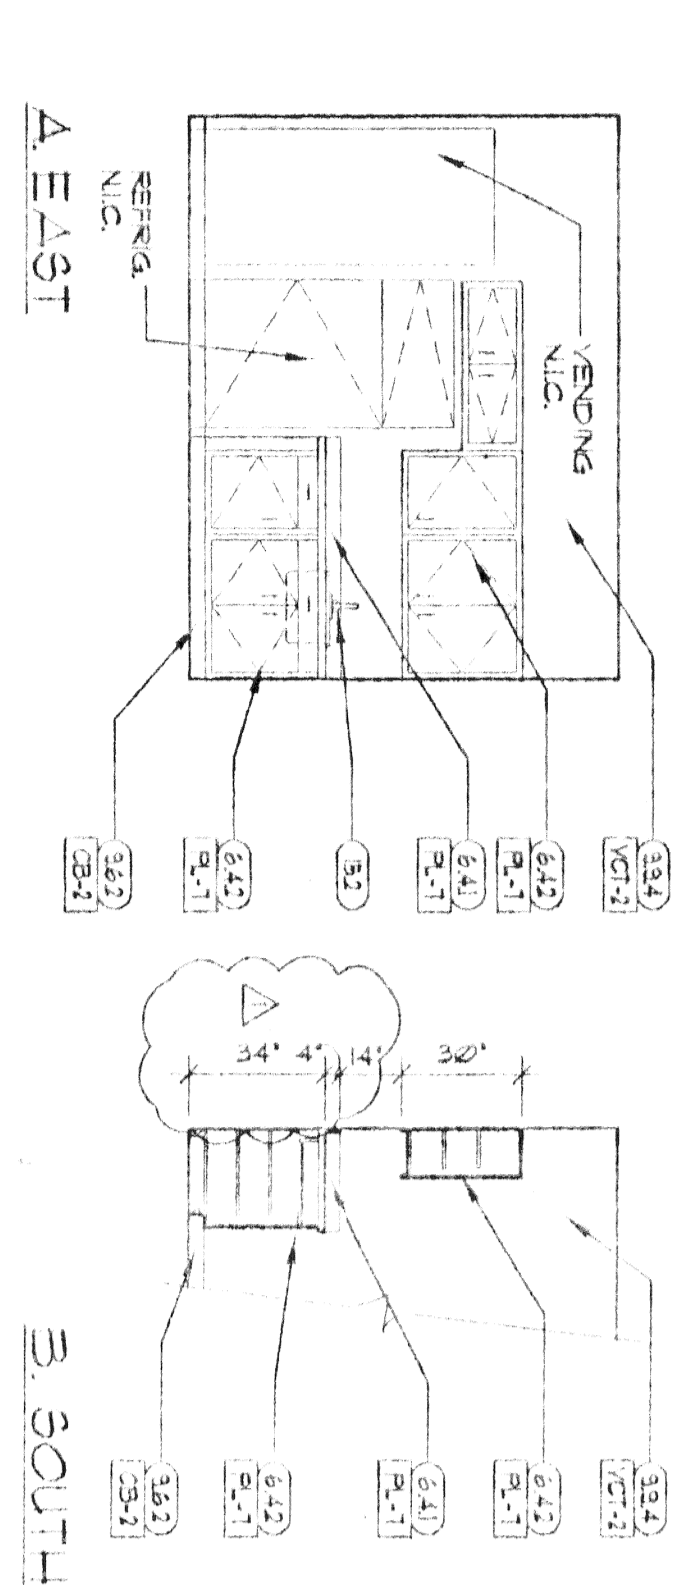


4 TECH. BREAK 145 ELEVATIONS
1/4" = 1'-0"

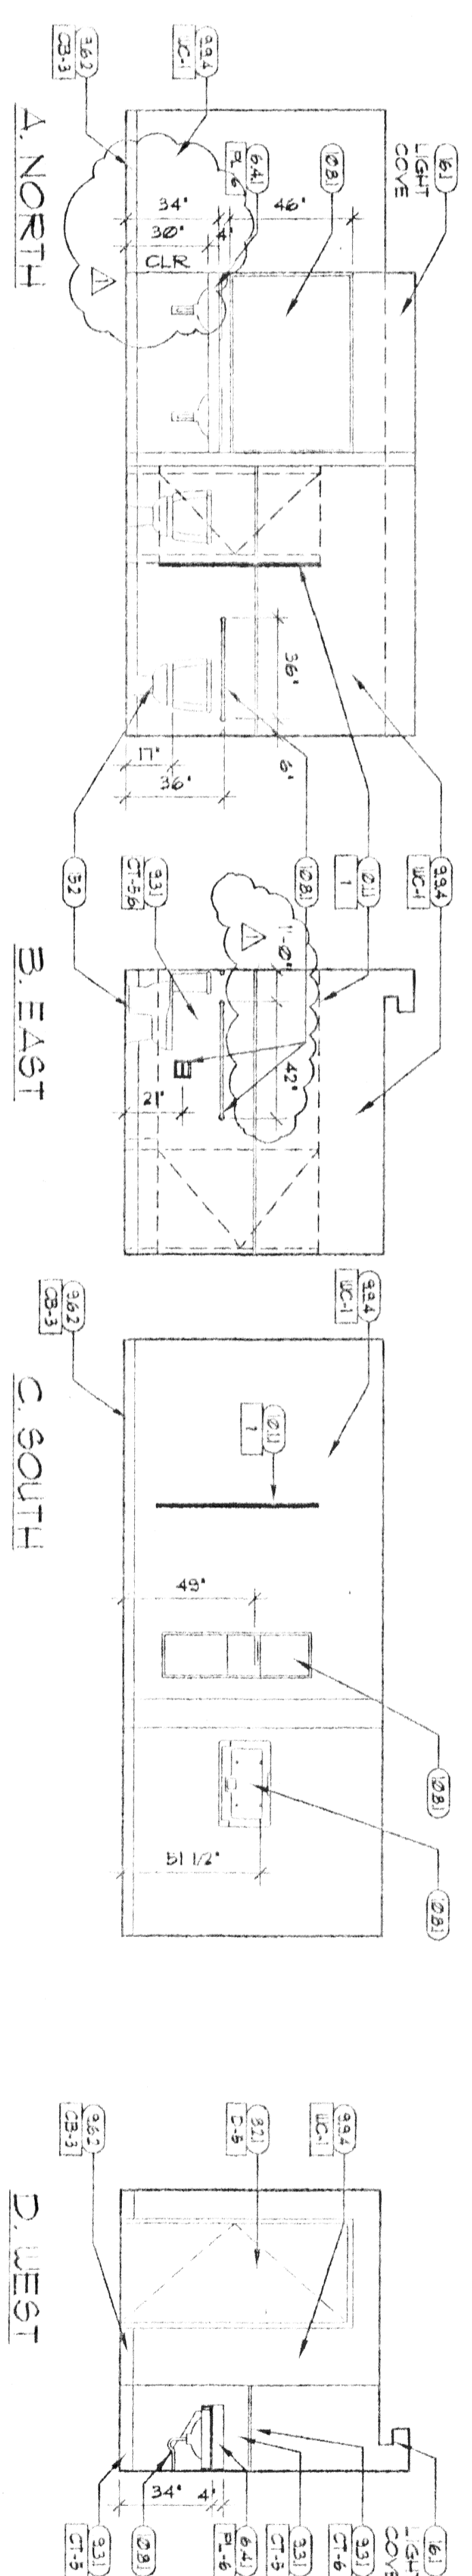

3 WOMEN'S PUBLIC TOILET 124 ELEVATIONS
1/4" = 1'-0"

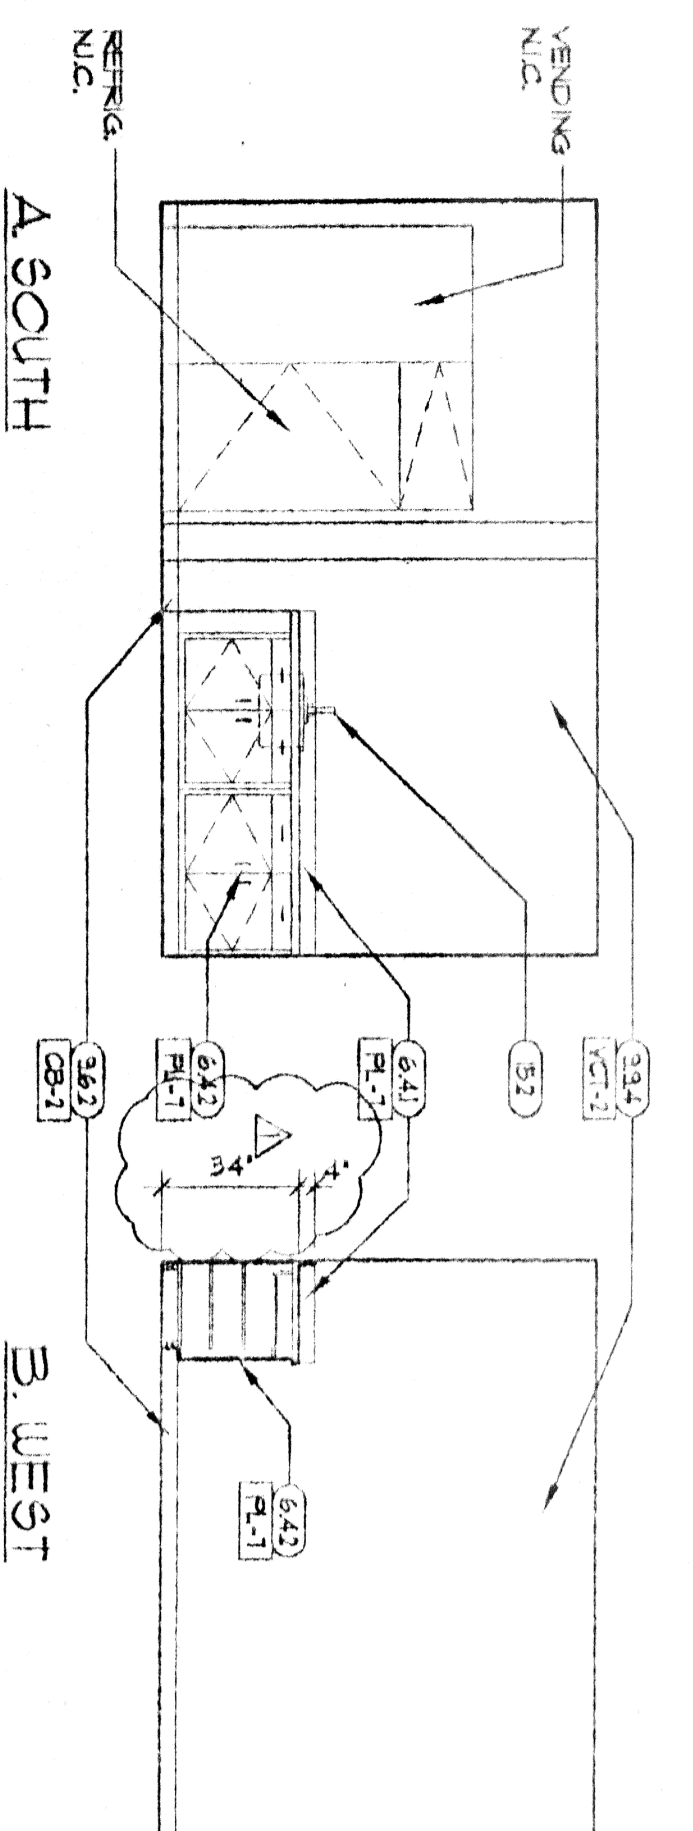

2 CONFERENCE / BREAK 122 ELEVATIONS
1/4" = 1'-0"

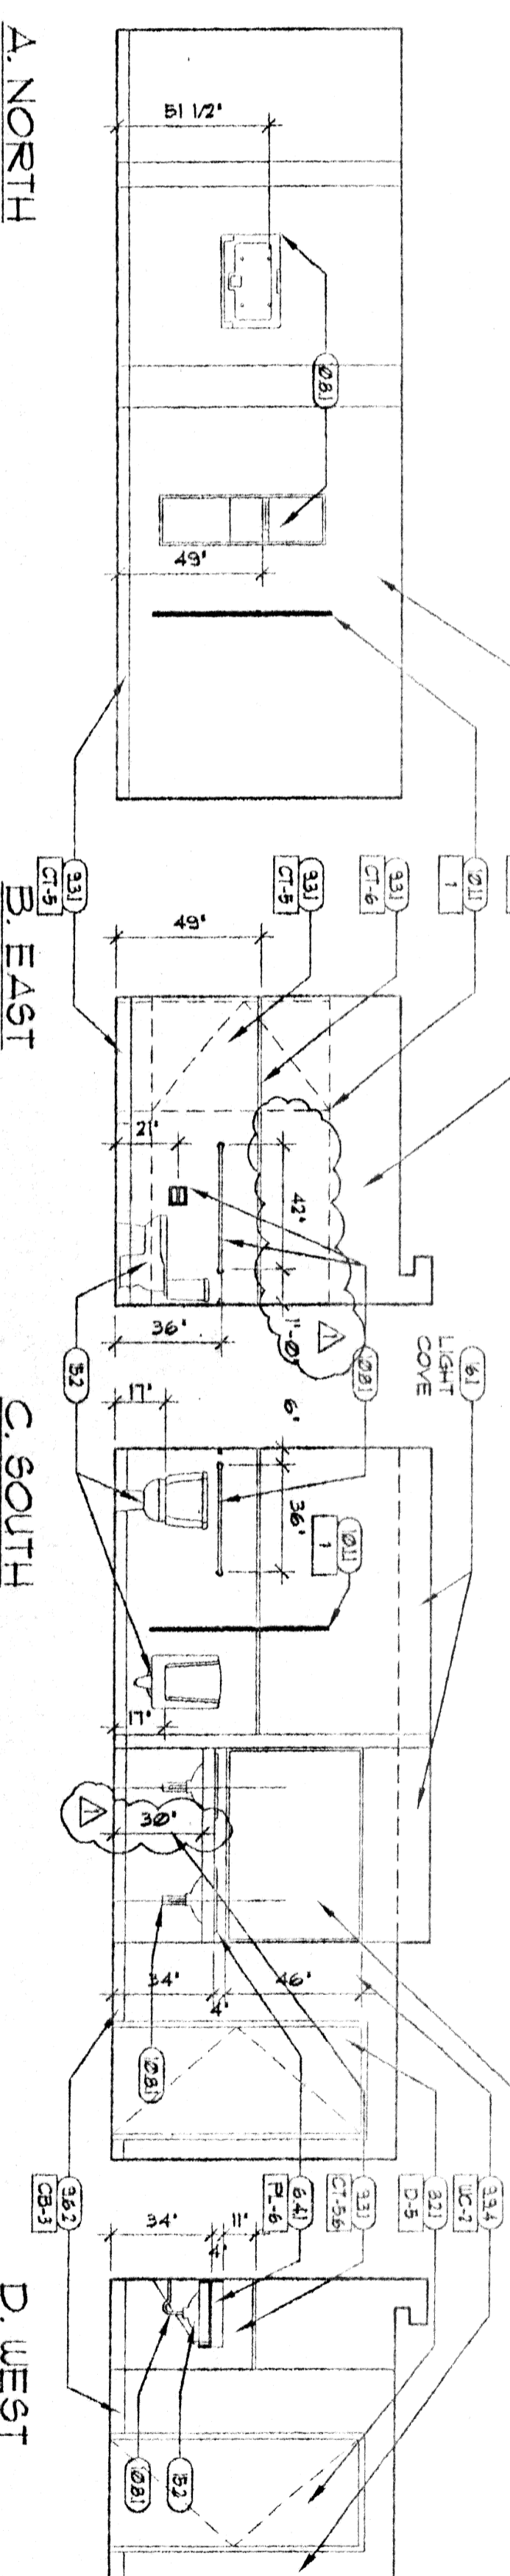

1 MEN'S PUBLIC TOILET 123 ELEVATIONS
1/4" = 1'-0"

KEYED NOTES

- (21) RE. CIVIL FOR EXTERIOR PAVING
- (211) 1"X EXP. JT.
- (331) CONCRETE FOUNDATION RE. STRUCT.
- (332) CONC. SLAB ON PREPARED GRADE
- (333) CONC. FLOOR ON H.T.L. DECK
- (420) CRUI WALL RE. STRUCT FOR REIN.
- (421) STEEL SEAM RE. STRUCT.
- (422) STEEL COLUMN RE. STRUCT.
- (423) STEEL JOIST RE. STRUCT.
- (424) STEEL DECK RE. STRUCT.
- (520) GALV. FORMED STEEL FRAMING RE. STRUCT.
- (521) 3"X 6"X 1/2" SEATING
- (522) 3"X 6"X 1/2" AIR INFILTRATION BARRIER
- (523) STEEL STAIRS
- (524) 1"X 1" DIA. 9"X 1" PIPE DAMPCOLL. HORIZONTAL
- (525) 6" DIA. FIRE BOLLARD
