



INTERSTATE HIGHWAY No. 10
(450' R.O.W.)

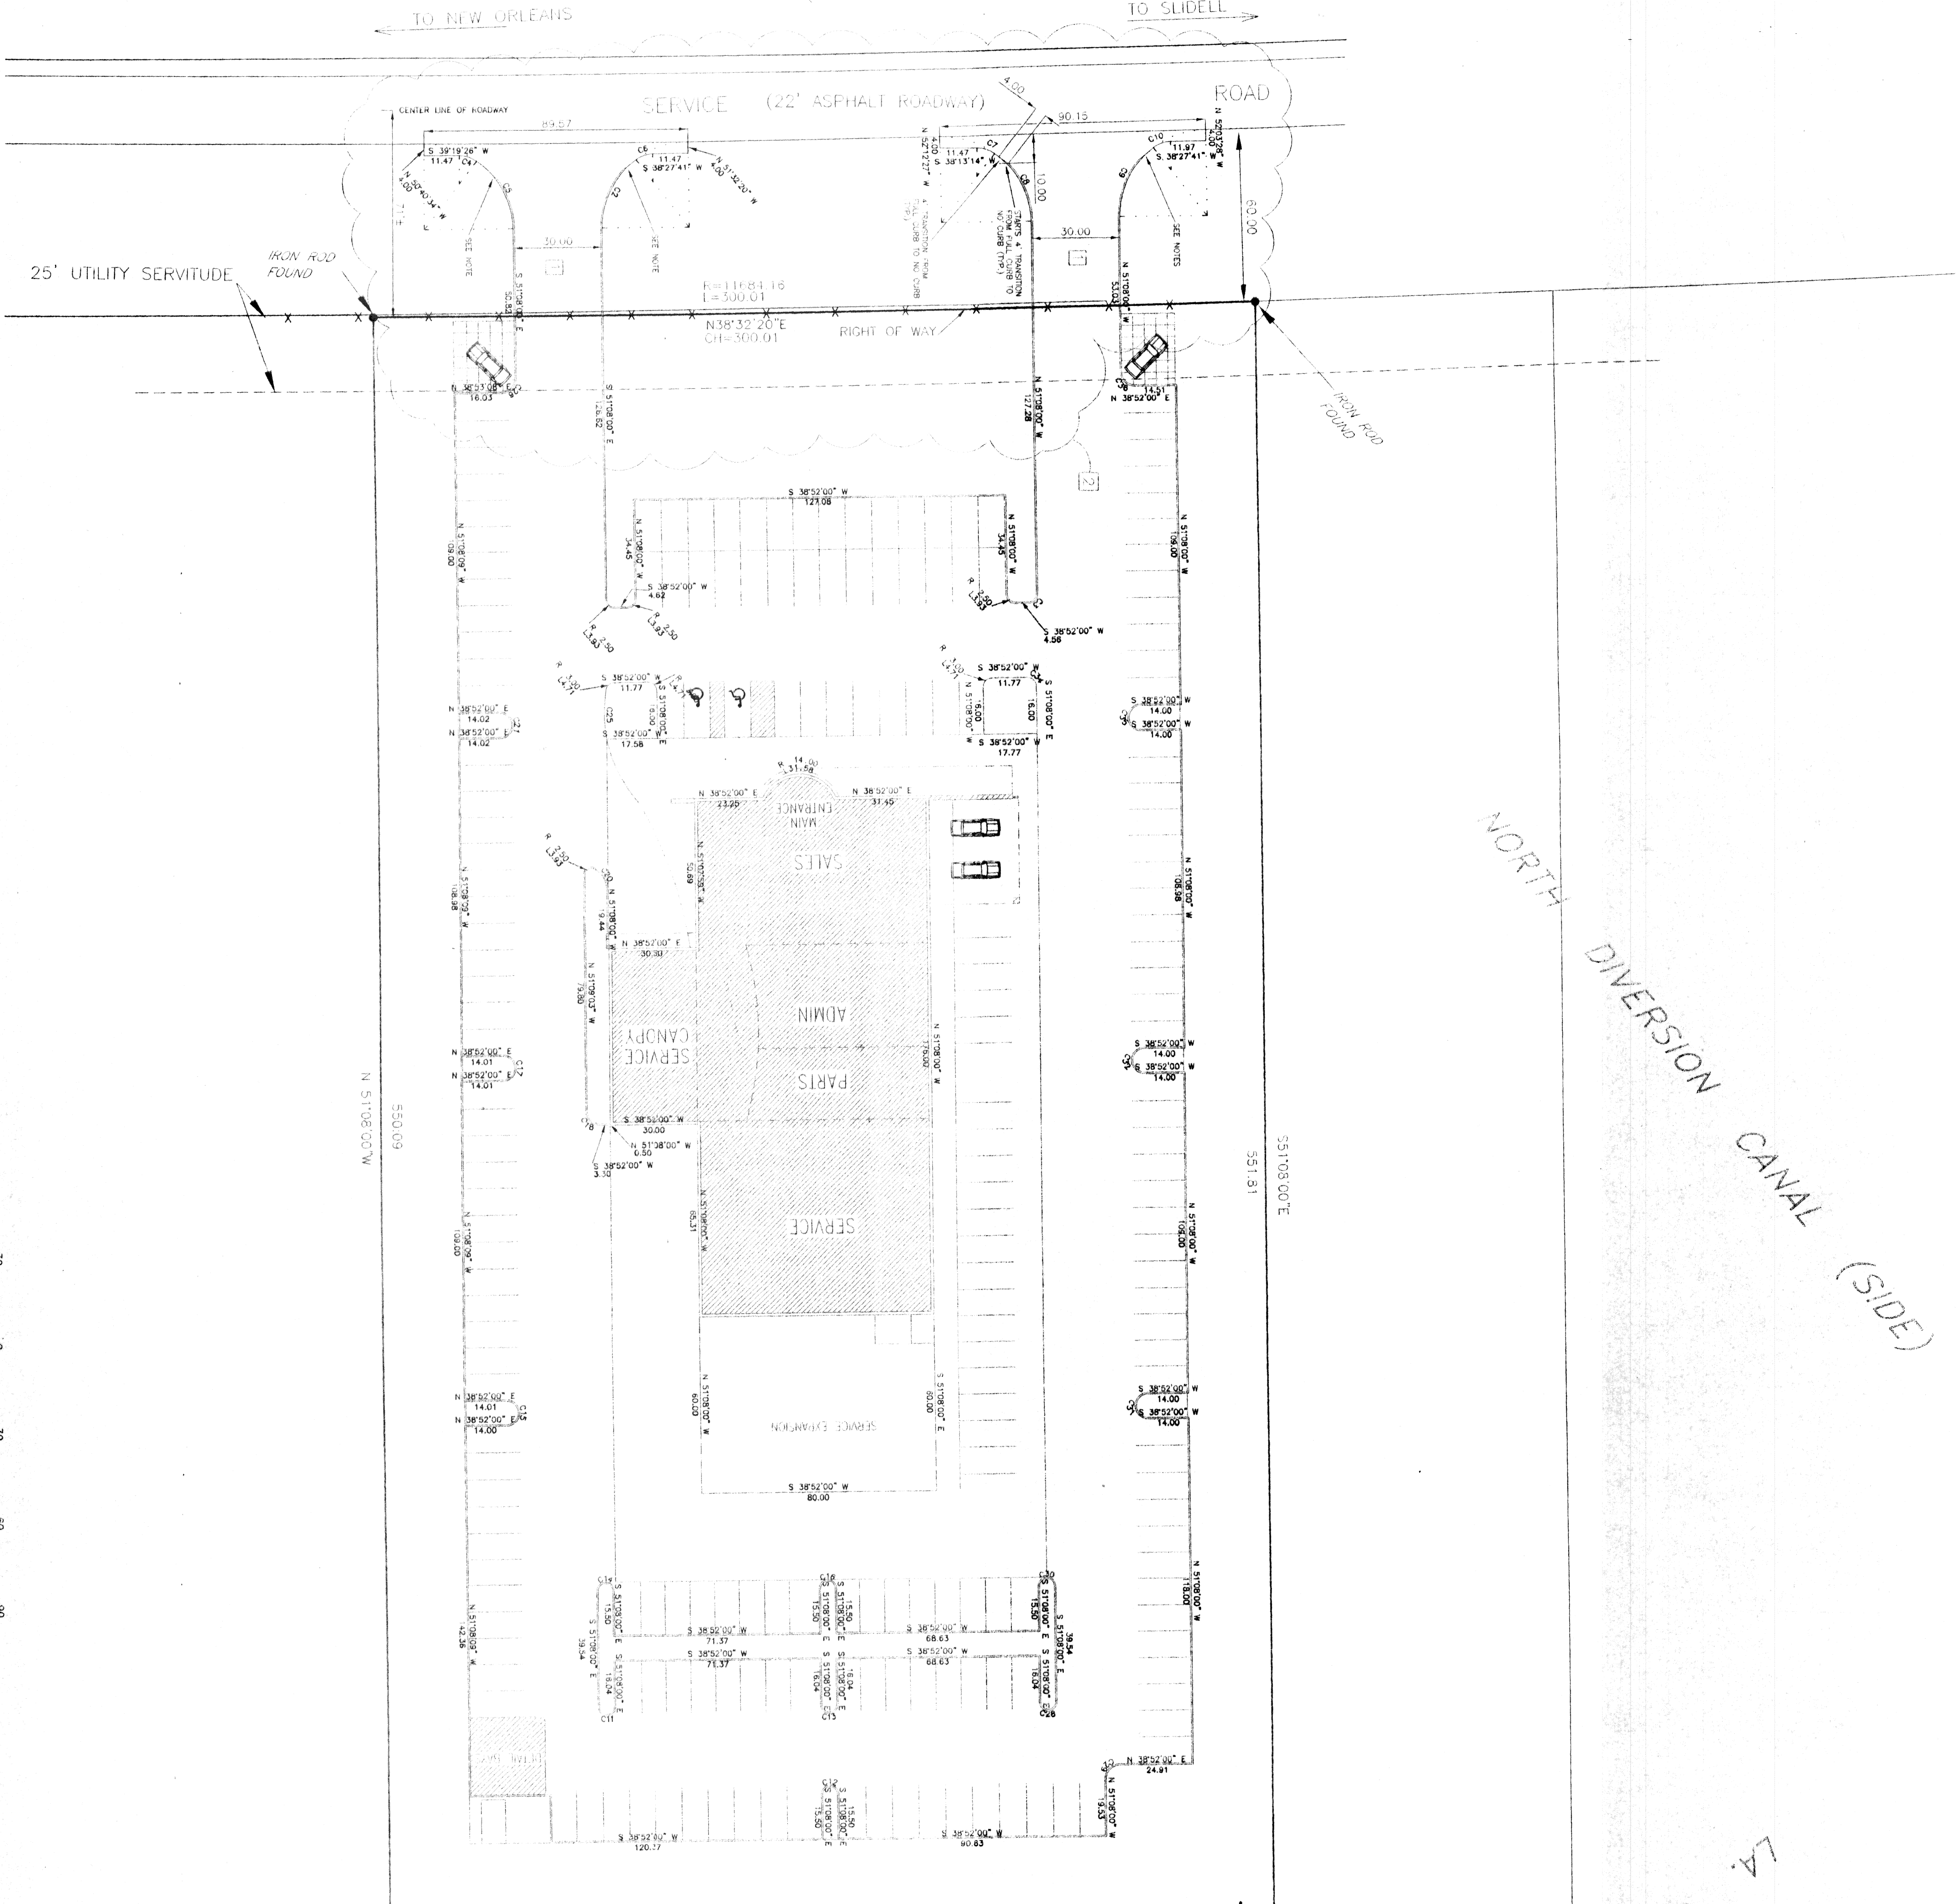

NORTH DIVERSION CANAL (SIDE)


LA STATE HIGHWAY NO. 433 (SIDE)

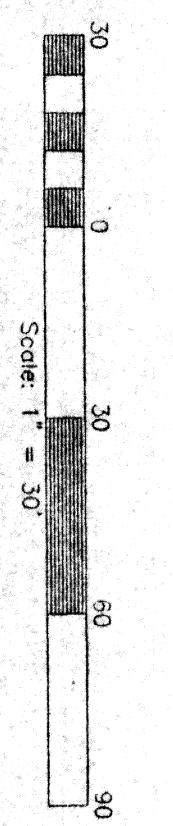

NUMBER CHORD DIRECTION, BEARINGS, ARC LENGTH, CHORD LENGTH

01	N 24°40'00" W	2.50	2.50
02	N 24°40'00" W	2.50	2.50
FOR CONSTRUCTION
ARCHITECT _____ OWNER _____ CONTRACTOR _____
DATE: 11/19/03

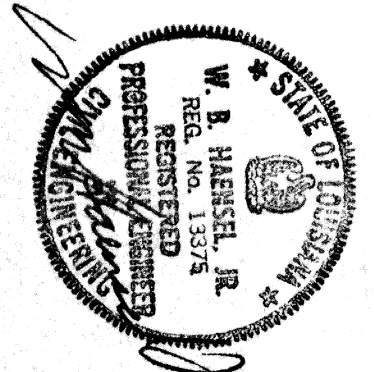

KREBS, LASALLE, JEMTEUX, CONSULTANTS, INC.
ENGINEERING • PLANNING • SURVEYING • HYDROLOGY • ENVIRONMENTAL
3013 27TH STREET METairie, LA 70002 (504)837-9470
2107 NOLDSWAMY BLVD. SUITE F, WABDEVILLE, LA 70448 (504)824-5125
DATE: OCTOBER 1, 2002 SCALE: 1" = 30'

HONDA DEALERSHIP
LAKESHORE ESATES
ST. TAMMANY PARISH, LA

GEOMETRIC LAYOUT PLAN

CHECKED BY: _____ C.A.C. APPROVED BY: _____
DATE: _____