NUMBER	CHORD DIRECTION	RADIUS	ARC LENGTH	CHORD LENGTH
C1	S 51°08'00" E	4.00	12.57	8.00
C2	S 51°08'00" E	4.00	12.57	8.00
C3	S 51°08'00" E	4.00	12.57	8.00
C4	N 51°08'00" W	4.00	12.57	8.00
C5	N 51°08'00" W	4.00	12.57	8.00
C6	N 51°08'00" W	4.00	12.57	8.00
C7	S 55°39'09" W	10.00	6.08	5.99
C8	N 79°01'28" W	29.50	28.72	27.60
C9	S 20°30'37" W	10.00	6.08	5.99
C10	S 24°01'39" E	29.50	27.31	26.38
C11	S 56°46'21" W	10.00	6.08	5.99
C12	N 78°28'22" W	29.50	28.15	27.10
C13	S 21°01'43" W	10.00	6.08	5.99
C14	S 23°48'05" E	29.50	28.18	27.12

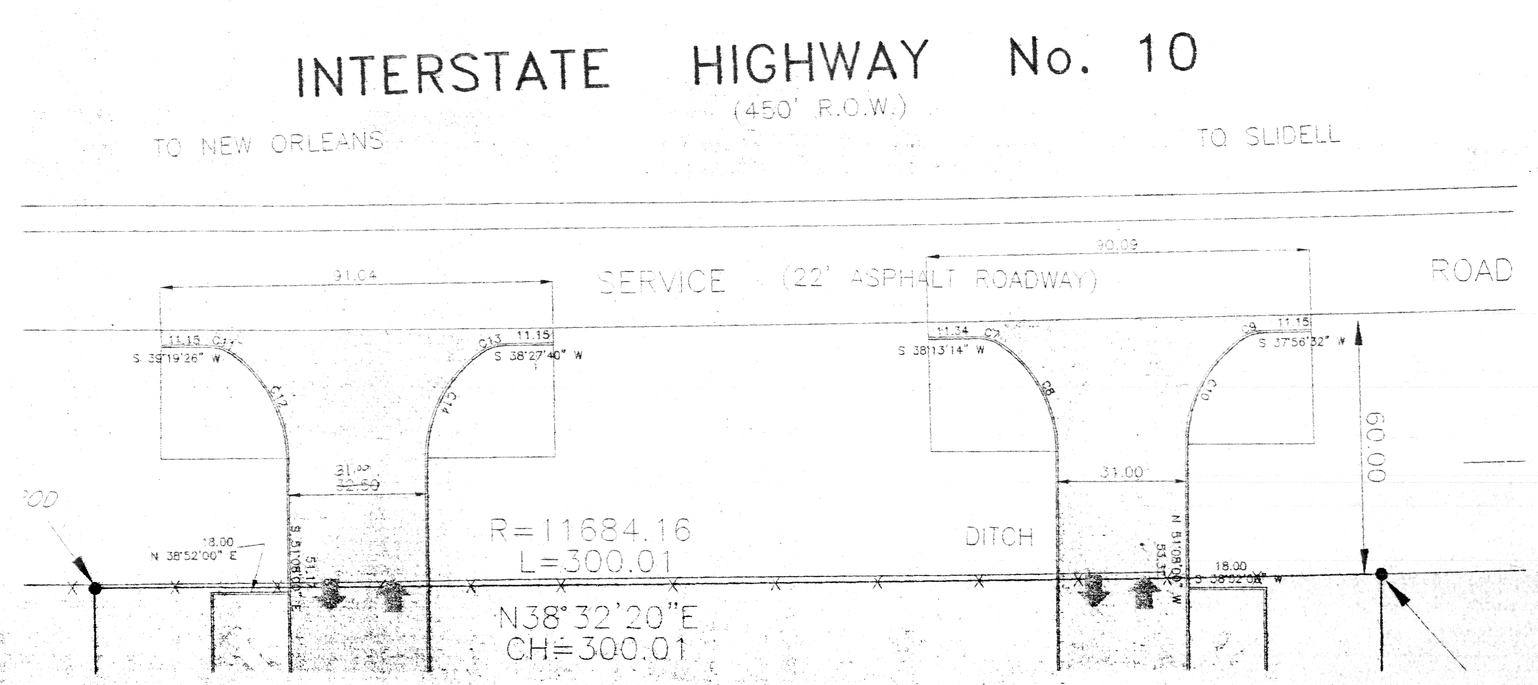

HONDA DEALERSHIP
LAKESHORE ESATES
ST. TAMMANY PARISH, LA.

HWY. PERMIT GEOM.

KREBS, LaSALLE, LeMIEUX, CONSULTANTS, INC.
ENGINEERING • PLANNING • SURVEYING • HYDROLOGY • ENVIRONMENTAL
3013 27TH STREET • METAIRIE, LA. 70002 (504) 837-9420
2107 NORTHWAY BLVD. SUITE 3, MANDEVILLE, LA. 70448 (504) 624-5125

DATE	DESCRIPTION	NO.

DATE: OCTOBER 1, 2000 SCALE: 1" = 20' DRAWING NO. 7 of 14
DESIGNED BY: DRAWN BY: JMB
CHECKED BY: CHECKED BY: APPROVED BY: