


INTERSTATE HIGHWAY No. 10

(450' R.O.W.)

TO NEW ORLEANS

TO SLIDELL

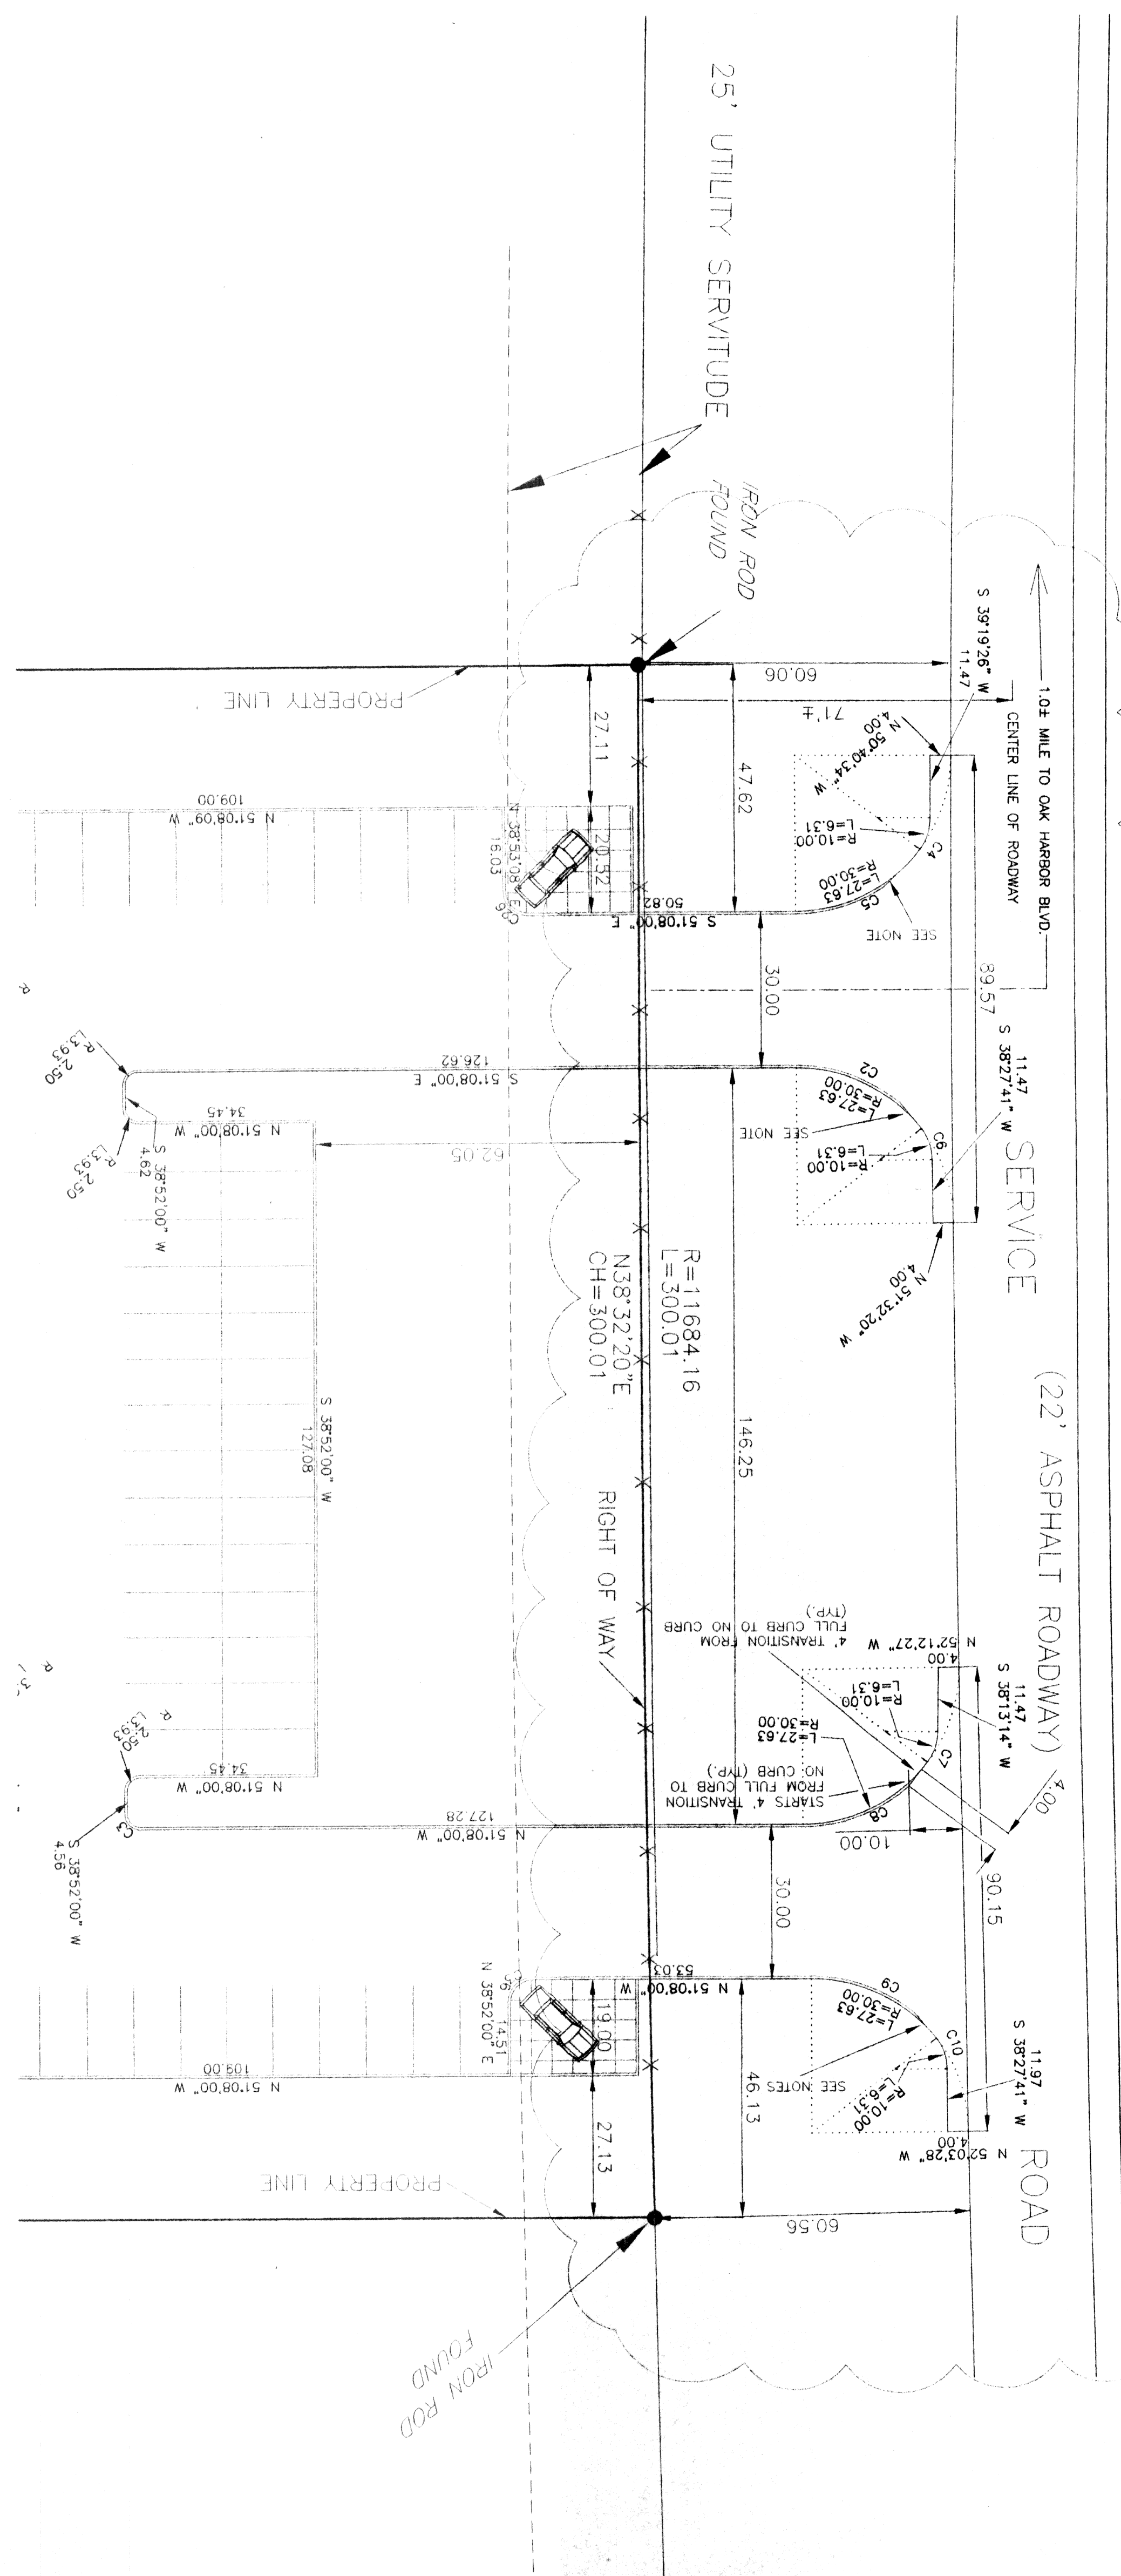

NUMBER	CHORD	DIRECTION	RADIUS	ARC LENGTH	CHORD LENGTH

FOR CONSTRUCTION

ARCHITECT: **KREBS, LASALLE, LAMIEUX, CONSULTANTS, INC.**

OWNER: **HONDA DEALERSHIP**

DATE: **11/19/03**

CONTRACTOR: **HONDA DEALERSHIP**

HONDA DEALERSHIP

LAKE SHORE ESATES

ST. TAMMANY PARISH, LA.

HWY. PERMIT GEOM.

NO.	DESCRIPTION	DATE	BY	APPROVED BY
1	5/7/2003 REVISIONS	5/7/2003	REVISIONS	
