




- KEYED NOTES**
- (21) RE: CIVIL FOR EXTERIOR PAVING
 - (21) 1/2" EXP. JT.
 - (32) CONCRETE FOUNDATION RE: STRUCT.
 - (32) CONC. SLAB ON PREPARED GRADE
 - (32) CONC. FLOOR ON INTL. DECK
 - (42) CMU WALL RE: STRUCT. FOR REINFT.
 - (51) STEEL BEAM, RE: STRUCT.
 - (52) STEEL COLUMN, RE: STRUCT.
 - (52) STEEL JOIST, RE: STRUCT.
 - (52) STEEL DECK, RE: STRUCT.
 - (52) CORRUGATED STEEL ROOFING, RE: STRUCT.
 - (52) 5/8" STP. SHEETING
 - (52) AIR FILTRATION BARRIER
 - (52) STEEL STAIRS
 - (52) 1/2" DIA. ST. PIPE
 - (52) 6" DIA. PIPE BOLLARD
 - (61) 3/4" EXTERIOR GRADE PLANKWOOD
 - (62) WOOD BLOCKING ON COMB.
 - (62) PLAS. LAM. COUNTERTOP
 - (62) PLAS. LAM. CABINETS
 - (62) WOOD SHELVES
 - (72) BATT INSUL. WHERE REQUIRED REE SECTION
 - (72) ACoust. CAL. BATT. INSULATION
 - (72) EPS. INS. ATTACH.
 - (72) EPS. PORTED RETAIL
 - (74) HONDA COLOR. COMPOSITE METAL PANELS
 - (74) HONDA GANTRY LANE
 - (82) 24 GA. GALV. BMT. TILE COFFING
 - (82) SEALANT JOINT
 - (82) HT. DOOR AND RAVE
 - (82) 6C WOOD DOOR
 - (82) ACCESS PANEL
 - (82) COILING FIRE DOOR IHR
 - (82) OVERHEAD SECTIONAL DOOR
 - (82) COILING COUNTER SAUITER
 - (82) WOOD ALUM. FRAGMENT/ENTRANCE LUNDS
 - (82) WOOD ALUM. FRAGMENT TO MATCH SECTIONAL SYSTEM
 - (82) 1" LOW E' GLAZING
 - (82) 1/4" CLEAR GLAZING

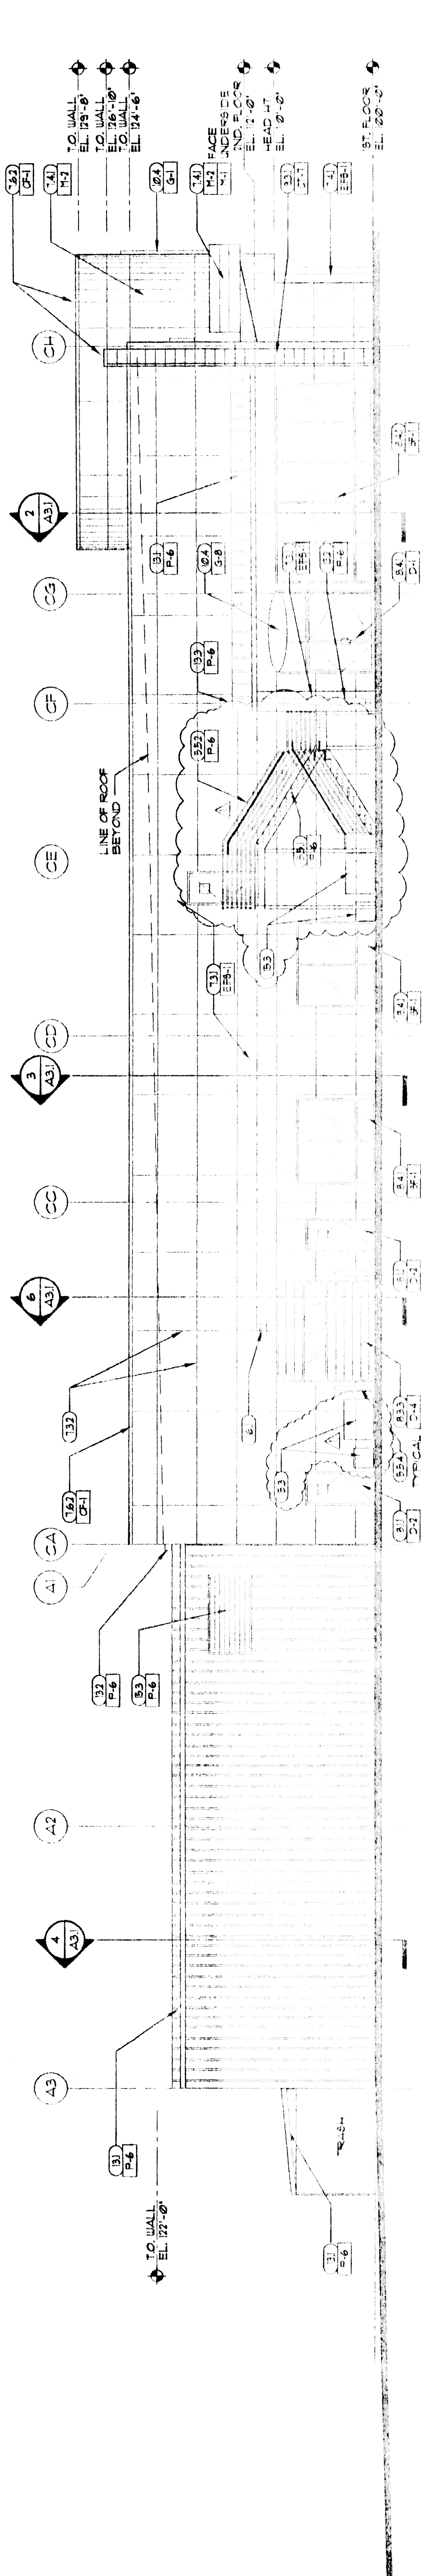

EAST ELEVATION
1/8" = 1'-0"

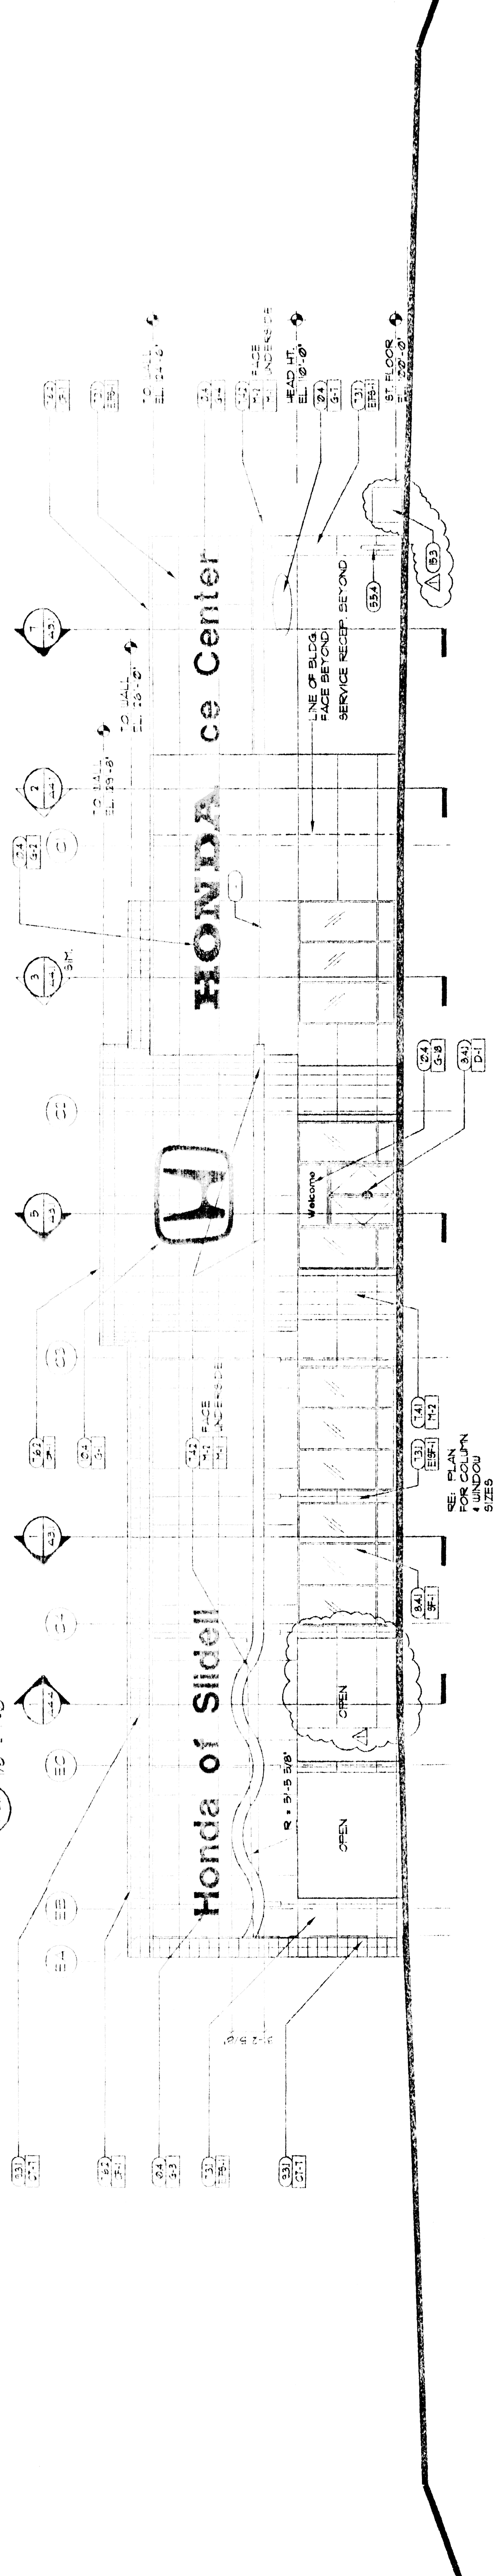

NORTH ELEVATION
1/8" = 1'-0"

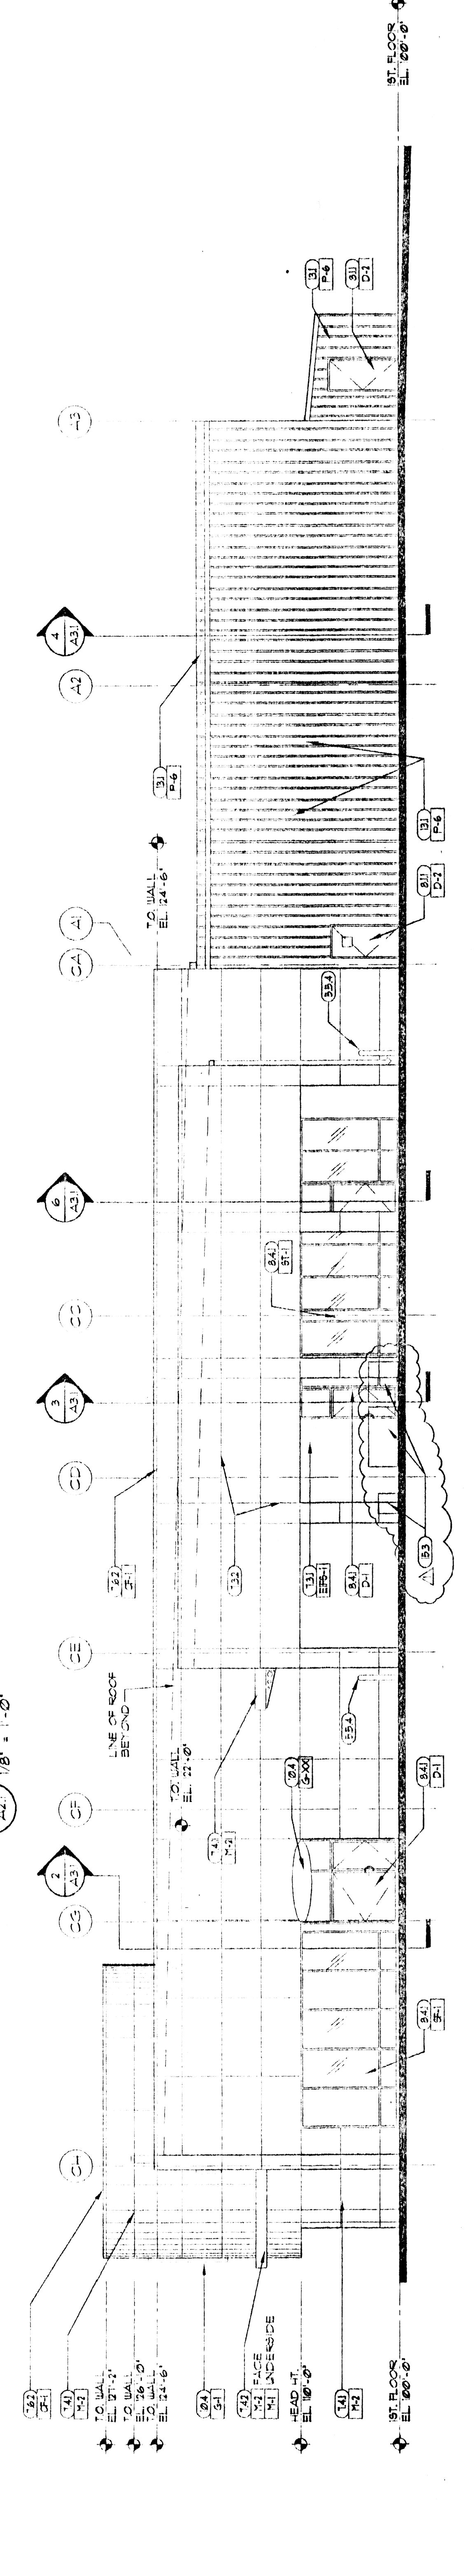

WEST ELEVATION
1/8" = 1'-0"

