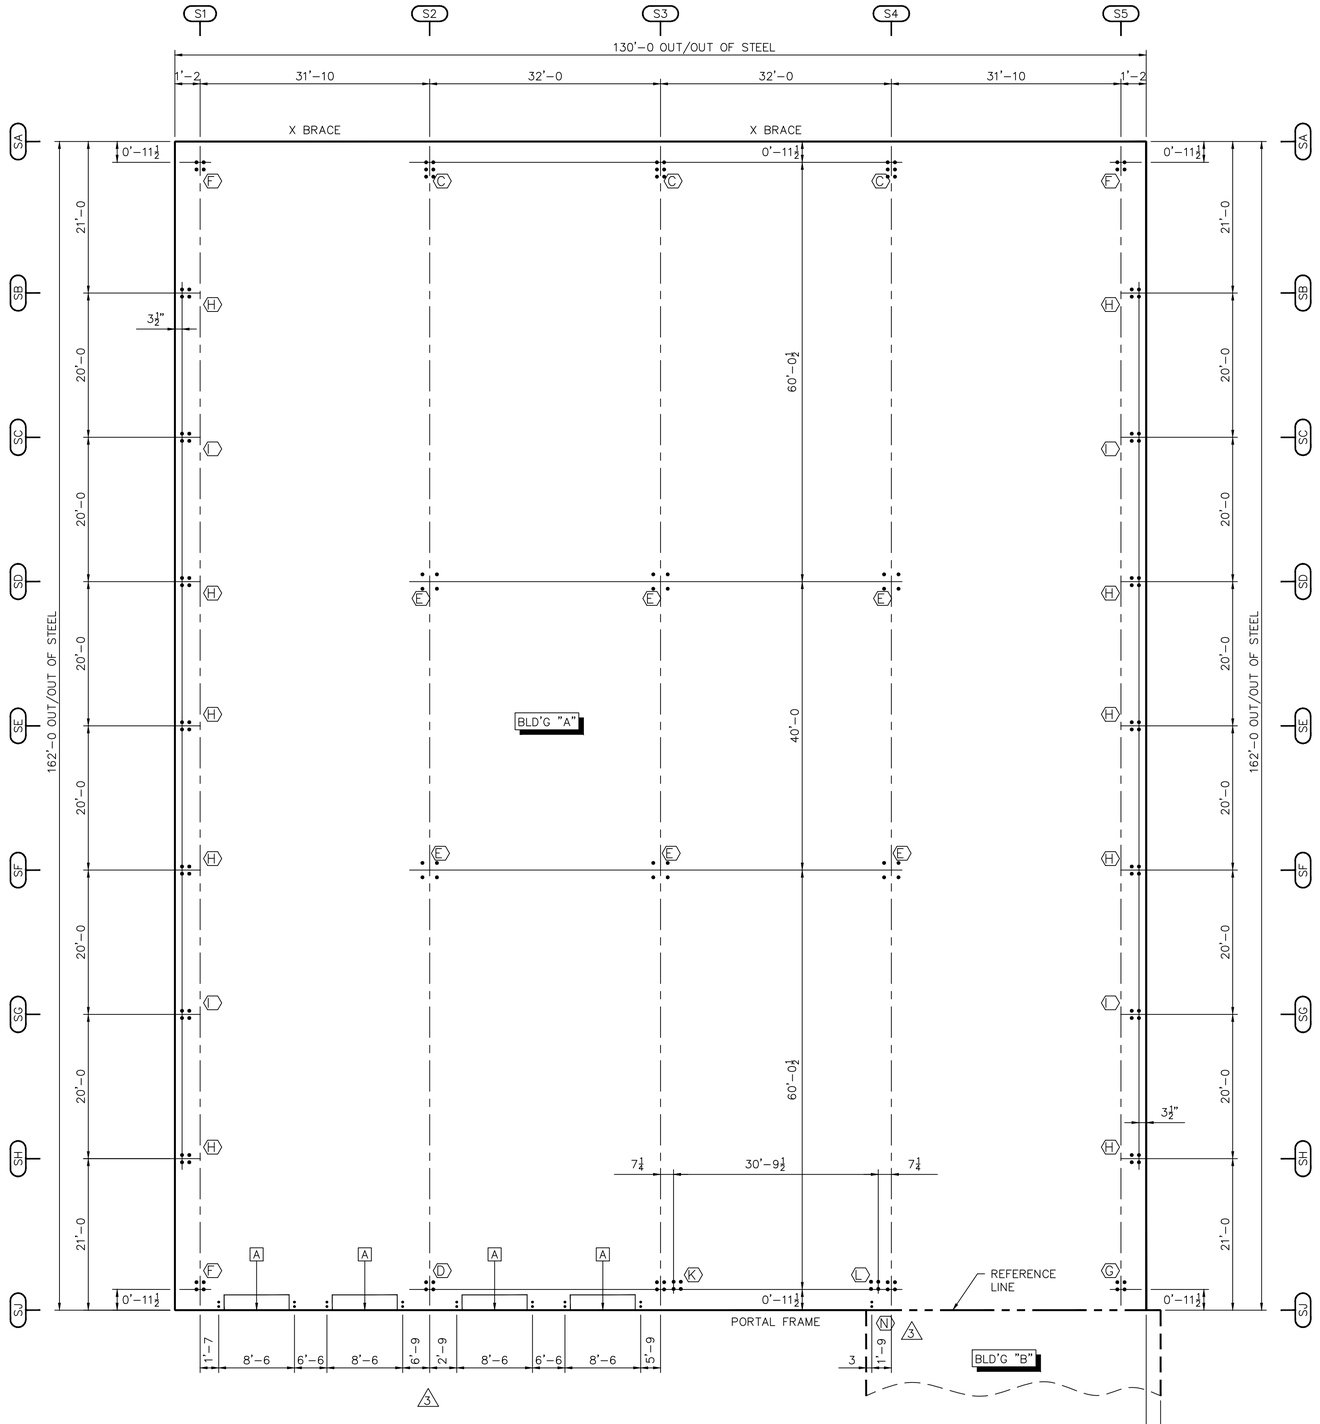

ANCHOR ROD SETTING PLAN

ANCHOR BOLTS TO BE DESIGNED BY FOUNDATON ENGINEER USING DIAMETERS SHOWN IN THIS TABLE.	
ANCHOR ROD DESCRIPTION	QUANTITY
¾ "ø DIAMETER X	18
¾ "ø DIAMETER X	190 (4)

ACCESSORY SCHEDULE			
MARK	DESCRIPTION	DETAIL	QUAN.
A	8'-0 X 10'-0 FRAMED OPENINGS	J	4

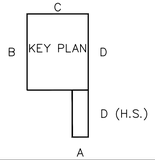

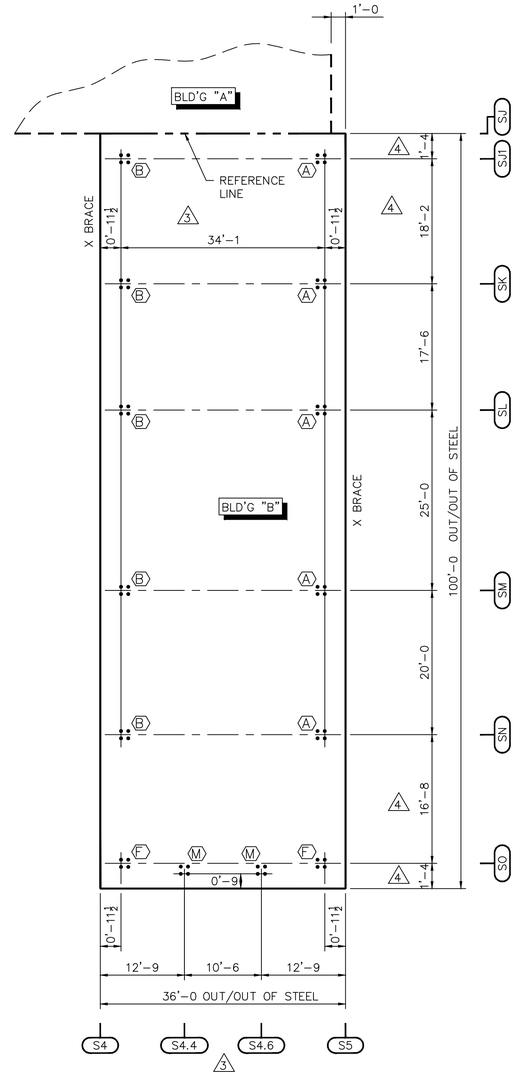

ANCHOR ROD SETTING PLAN

Anchor Rod Drawings

1) This drawing is for anchor rod placement only and is not foundation design.
2) Foundation must be square and level with all anchor rods true in size, location, and projection.
3) Projection shown must be held to keep threads clear of finished concrete.
4) This structural design data includes magnitude and location of design loads and suppose conditions, material properties, and type and size of major structural members necessary to show compliance with the Order Documents at the time of this issue. Any change to building loads or dimensions may change structural member sizes and locations shown. This structural design data will be superseded and voided by any future mailing.
5) Anchor rod size is determined by shear and tension at the bottom of the base plate. The length of the anchor rod and method of load transfer to the foundation are to be determined by the foundation engineer, and are not provided by the manufacturer.
6) Anchor rods are A36 or A307 material unless noted otherwise.

Revison	Date	Description	By	Ck'd
3	06/29/11	REVISED THRU SALES ORDER REVISON 3	KRK	JRS
4	08/01/11	REVISED THRU SALES ORDER REVISION 4	LSI	LSA

STAR BUILDING SYSTEMS
An NCI Company
P.O. BOX 94910
OKLAHOMA CITY, OK 73143
(405) 636-2010

Project Name & Location:
PINNACLE CASINO –
MANHATTAN CONSTRUCTION
BATON ROUGE, LA

Customer:
CASEY CIVIL LLC
COMMERCIAL
MANDEVILLE, LA

Drawing Status:
☐ Preliminary ☐ For Construction Permit
☐ For Approval ☒ For Erector Installation
REVISED

Scale:	NOT TO SCALE
Drawn by:	JRS 5/11/11
Checked by:	SNH 5/11/11
Project Engineer:	AK
Job Number:	12-B-63841
Sheet Number:	F1 of 4

The engineer whose seal appears hereon is an employee for the manufacturer for the materials described herein. Said seal or certification is limited to the products designed and manufactured by manufacturer only. The undersigned engineer is not the overall engineer of record for this project.