EAST WEST HALL

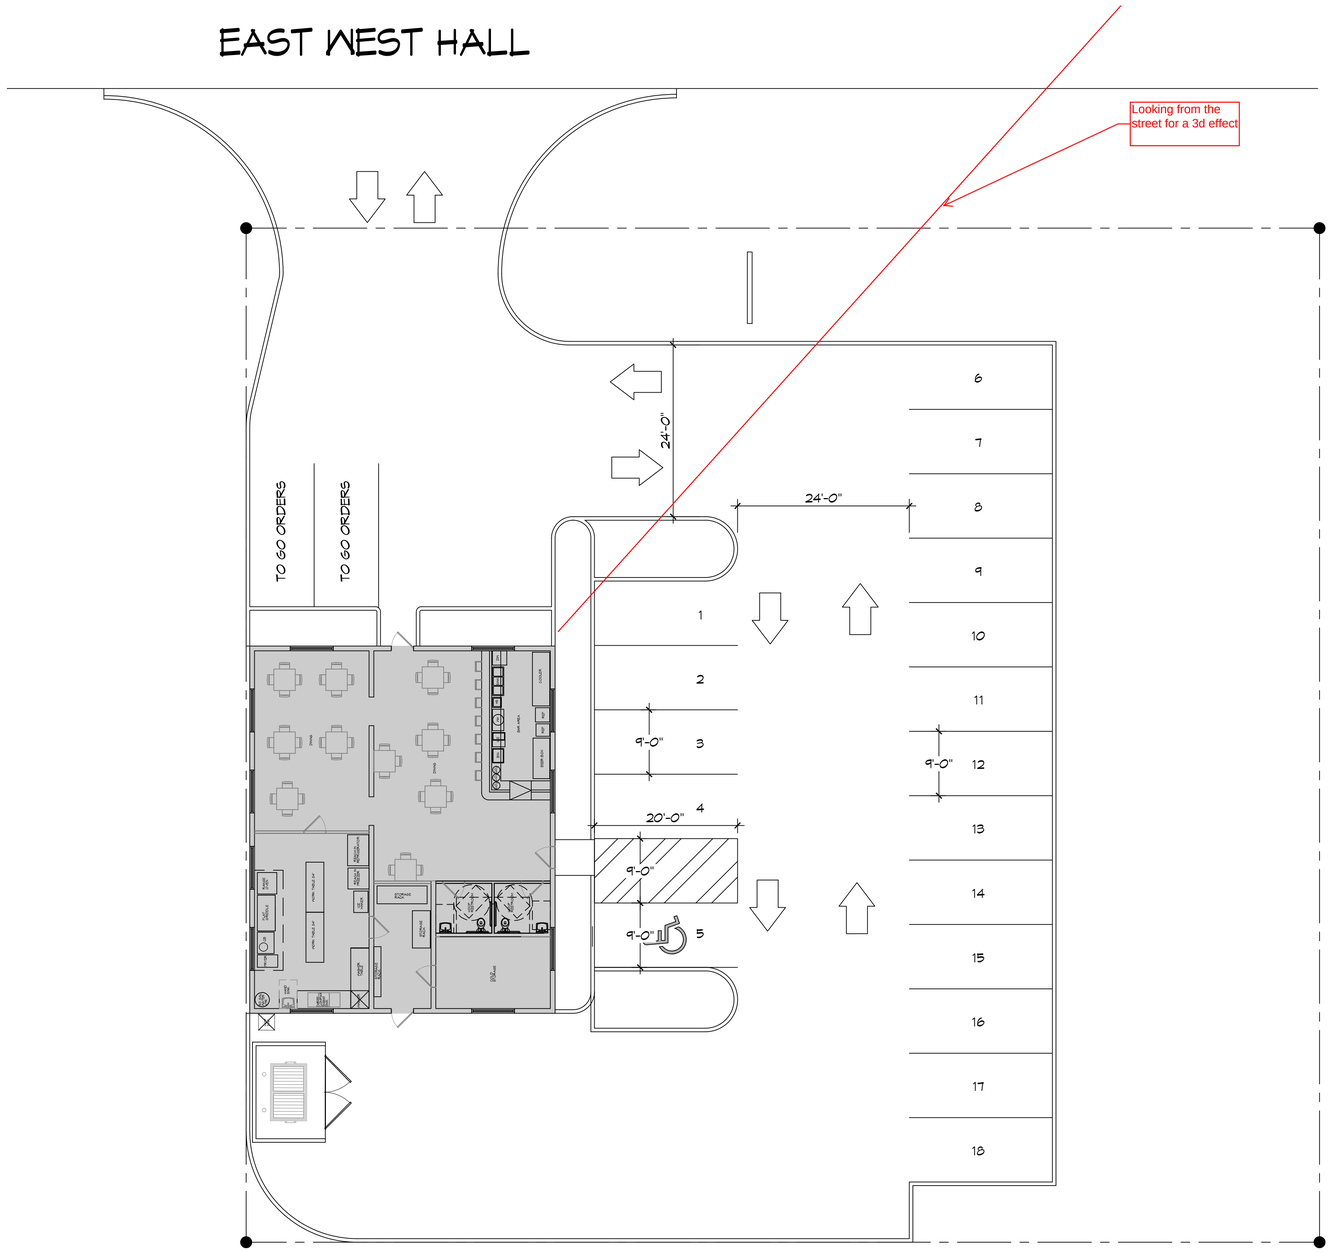

1 SITE PLAN
SCALE: 1" = 10'-0"

PARKING REQUIREMENTS

BUILDING = 2190 SQ. FT.

RESTAURANT 1 SPACE FOR EACH 150 SQ. FT. OF GROSS FLOOR AREA.
150 SQ. FT. / 2190 SQ. FT. = 14.6 PARKING SPACES

17 REGULAR PARKING SPACES PROVIDED
1 HANDICAP PARKING SPACES PROVIDED
TOTAL PARKING SPACES PROVIDED 18

TWO TO GO PARKING SPOTS

DAMMON ENGINEERING, INC.
LOUISIANA & MISSISSIPPI
www.dammonengineering.com
info@dammonengineering.com
PH: 985.649.5832
Chief Engineer: Brian Mistich, PE
554 Old Spanish Trail
Slidell, LA 70458

#	DESCRIPTION	REVISIONS	DATE

SEAL:

BUILDING LAYOUT
CECIL BOYD
153 EAST HALL
SLIDELL LA. 70459

DATE: 12-05-2022
JOB No:
DRAWN BY: CKD
CHECKED BY: JMS


SHEET TITLE:
SITE PLAN

DRAWING NUMBER:
C101

SHEET No: 1 of 3

FILE NAME: J:\C_Commercial\Cecil Boyd Cement\Drawings\Current Drawings\C101 - Site Plan.dwg PLOT DATE & TIME: Wednesday, December 14, 2022 10:14:49 AM

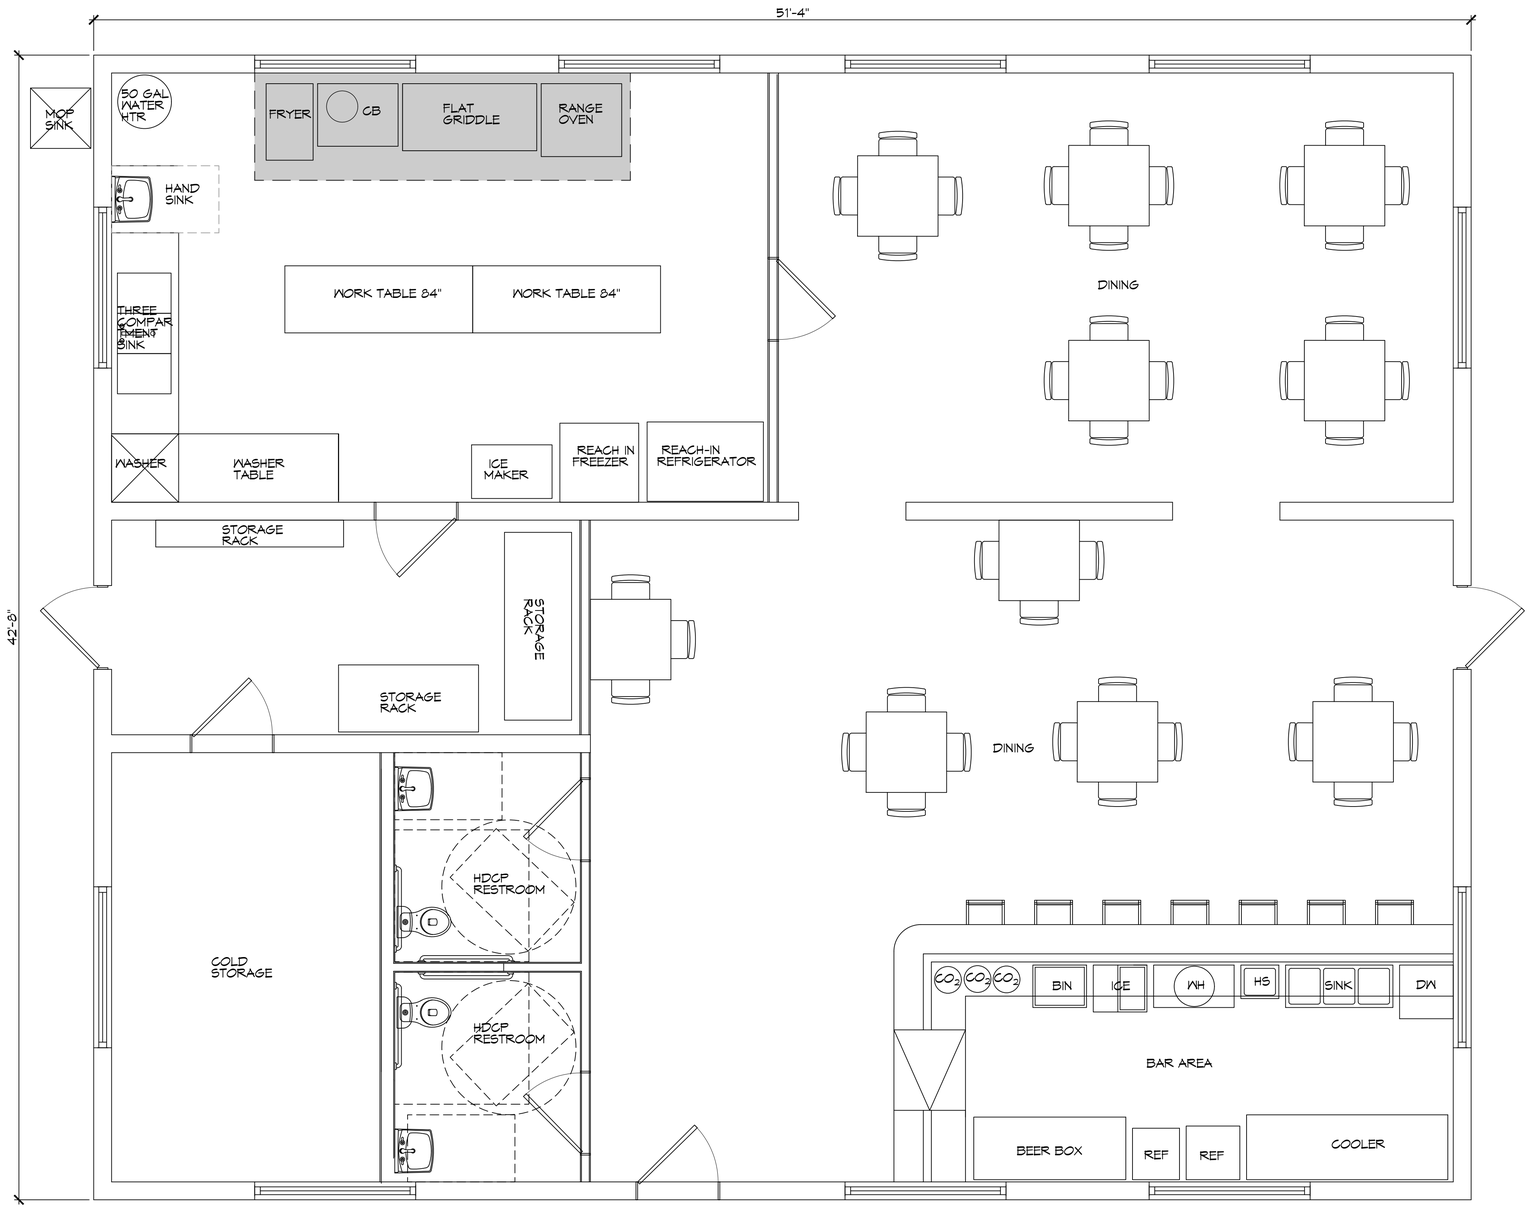

N

2 FLOOR PLAN

SCALE: 3/8"= 1'-0"

DAMMON ENGINEERING, INC.
LOUISIANA & MISSISSIPPI

Chief Engineer: Brian Mistich, PE
5544 Sisson Trail
Slidell, LA 70458

www.dammonengineering.com
info@dammonengineering.com
PH: 985.649.5832

#	DESCRIPTION	DATE

REVISIONS

SEAL:

BUILDING LAYOUT

CECIL BOYD

195 EAST HALL
SLIDELL LA 70458

JOB No:

DATE: 12-08-2022

DRAWN BY: CAD

CHECKED BY: JMS



SHEET TITLE:
FLOOR PLAN

DRAWING NUMBER:

A101

SHEET No: 2 of 3

FILE NAME: J:\- Commercial\Cecil Boyd Concept\Drawings\Current Drawings\A101 - Floor Plan.dwg PLOT DATE & TIME: Wednesday, December 14, 2022 12:14:53 AM

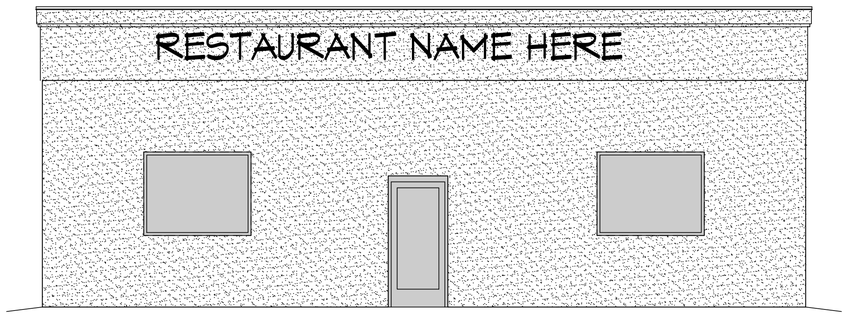

3 FRONT ELEVATION
SCALE: 3/16"=1'-0"

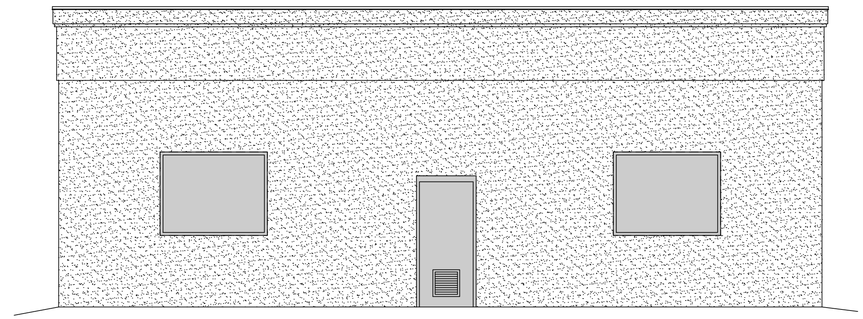

4 REAR ELEVATION
SCALE: 3/16"=1'-0"

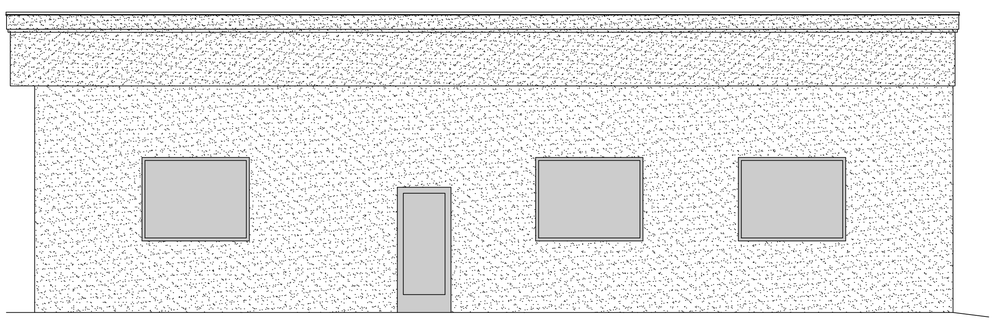

5 LEFT ELEVATION
SCALE: 3/16"=1'-0"

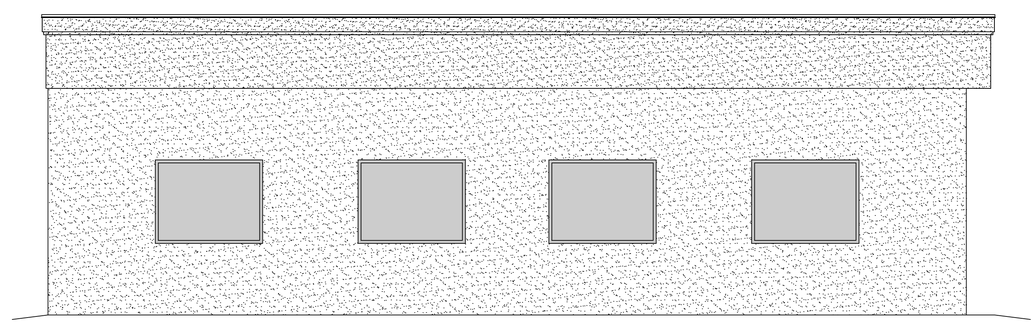

6 RIGHT ELEVATION
SCALE: 3/16"=1'-0"

DAMMON ENGINEERING, INC.
LOUISIANA & MISSISSIPPI
www.dammonengineering.com
info@dammonengineering.com
PH: 985.649.5832
Chief Engineer: Brian Mistich, PE
504 Old Spanish Trail
Slidell, LA 70458

REVISIONS

#	DESCRIPTION	DATE

SEAL:

BUILDING LAYOUT

CECIL BOYD

159 EAST HALL
SLIDELL LA 70458

JOB No:	DATE: 12-09-2022
DRAWN BY: CCD	CHECKED BY: JAS



SHEET TITLE:
EXTERIOR ELEVATIONS

DRAWING NUMBER:
A102

SHEET No: 3 of 3

FILE NAME: J:_Commercial\Cecil Boyd Consult\Drawings\Current Drawings\A102 - Exterior Elevations.dwg PLOT DATE & TIME: Wednesday, December 14, 2022 10:14:52 AM