

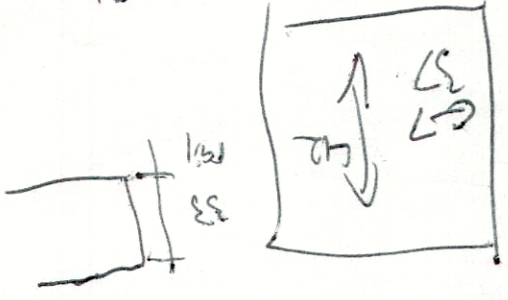




022 22
0819 @ 5700

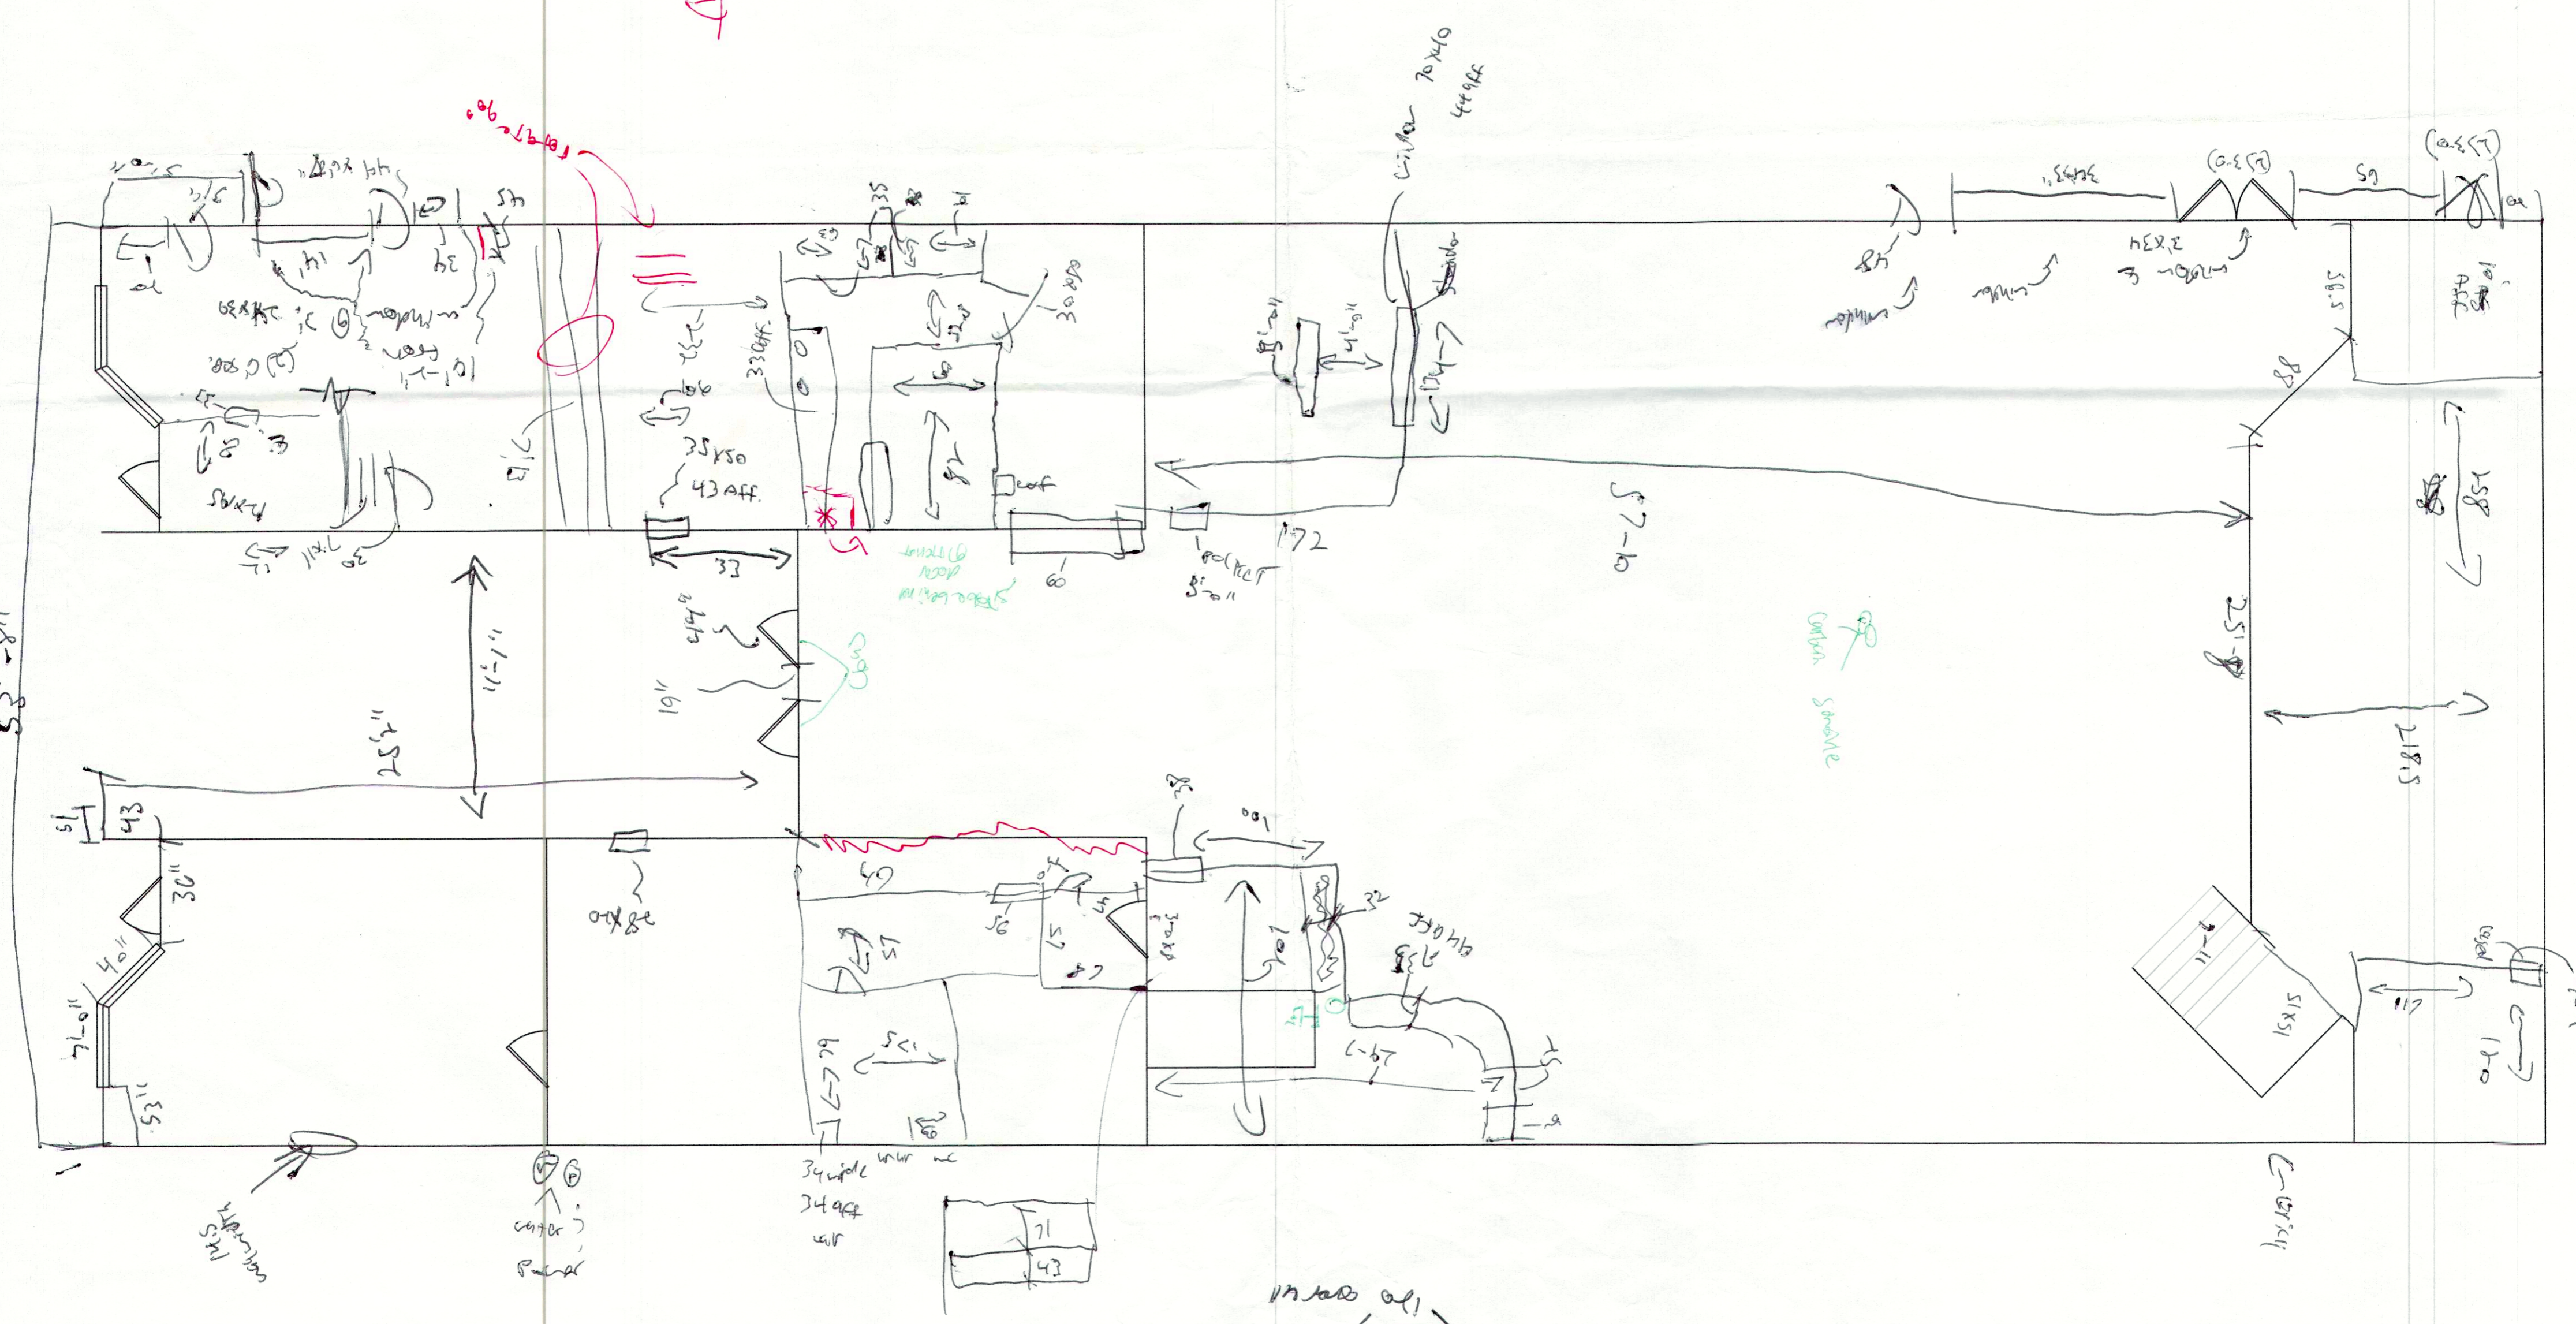

MAIN COLS

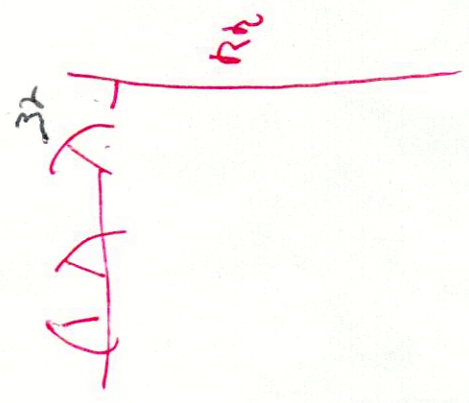

STAIR

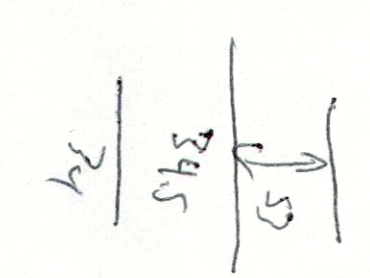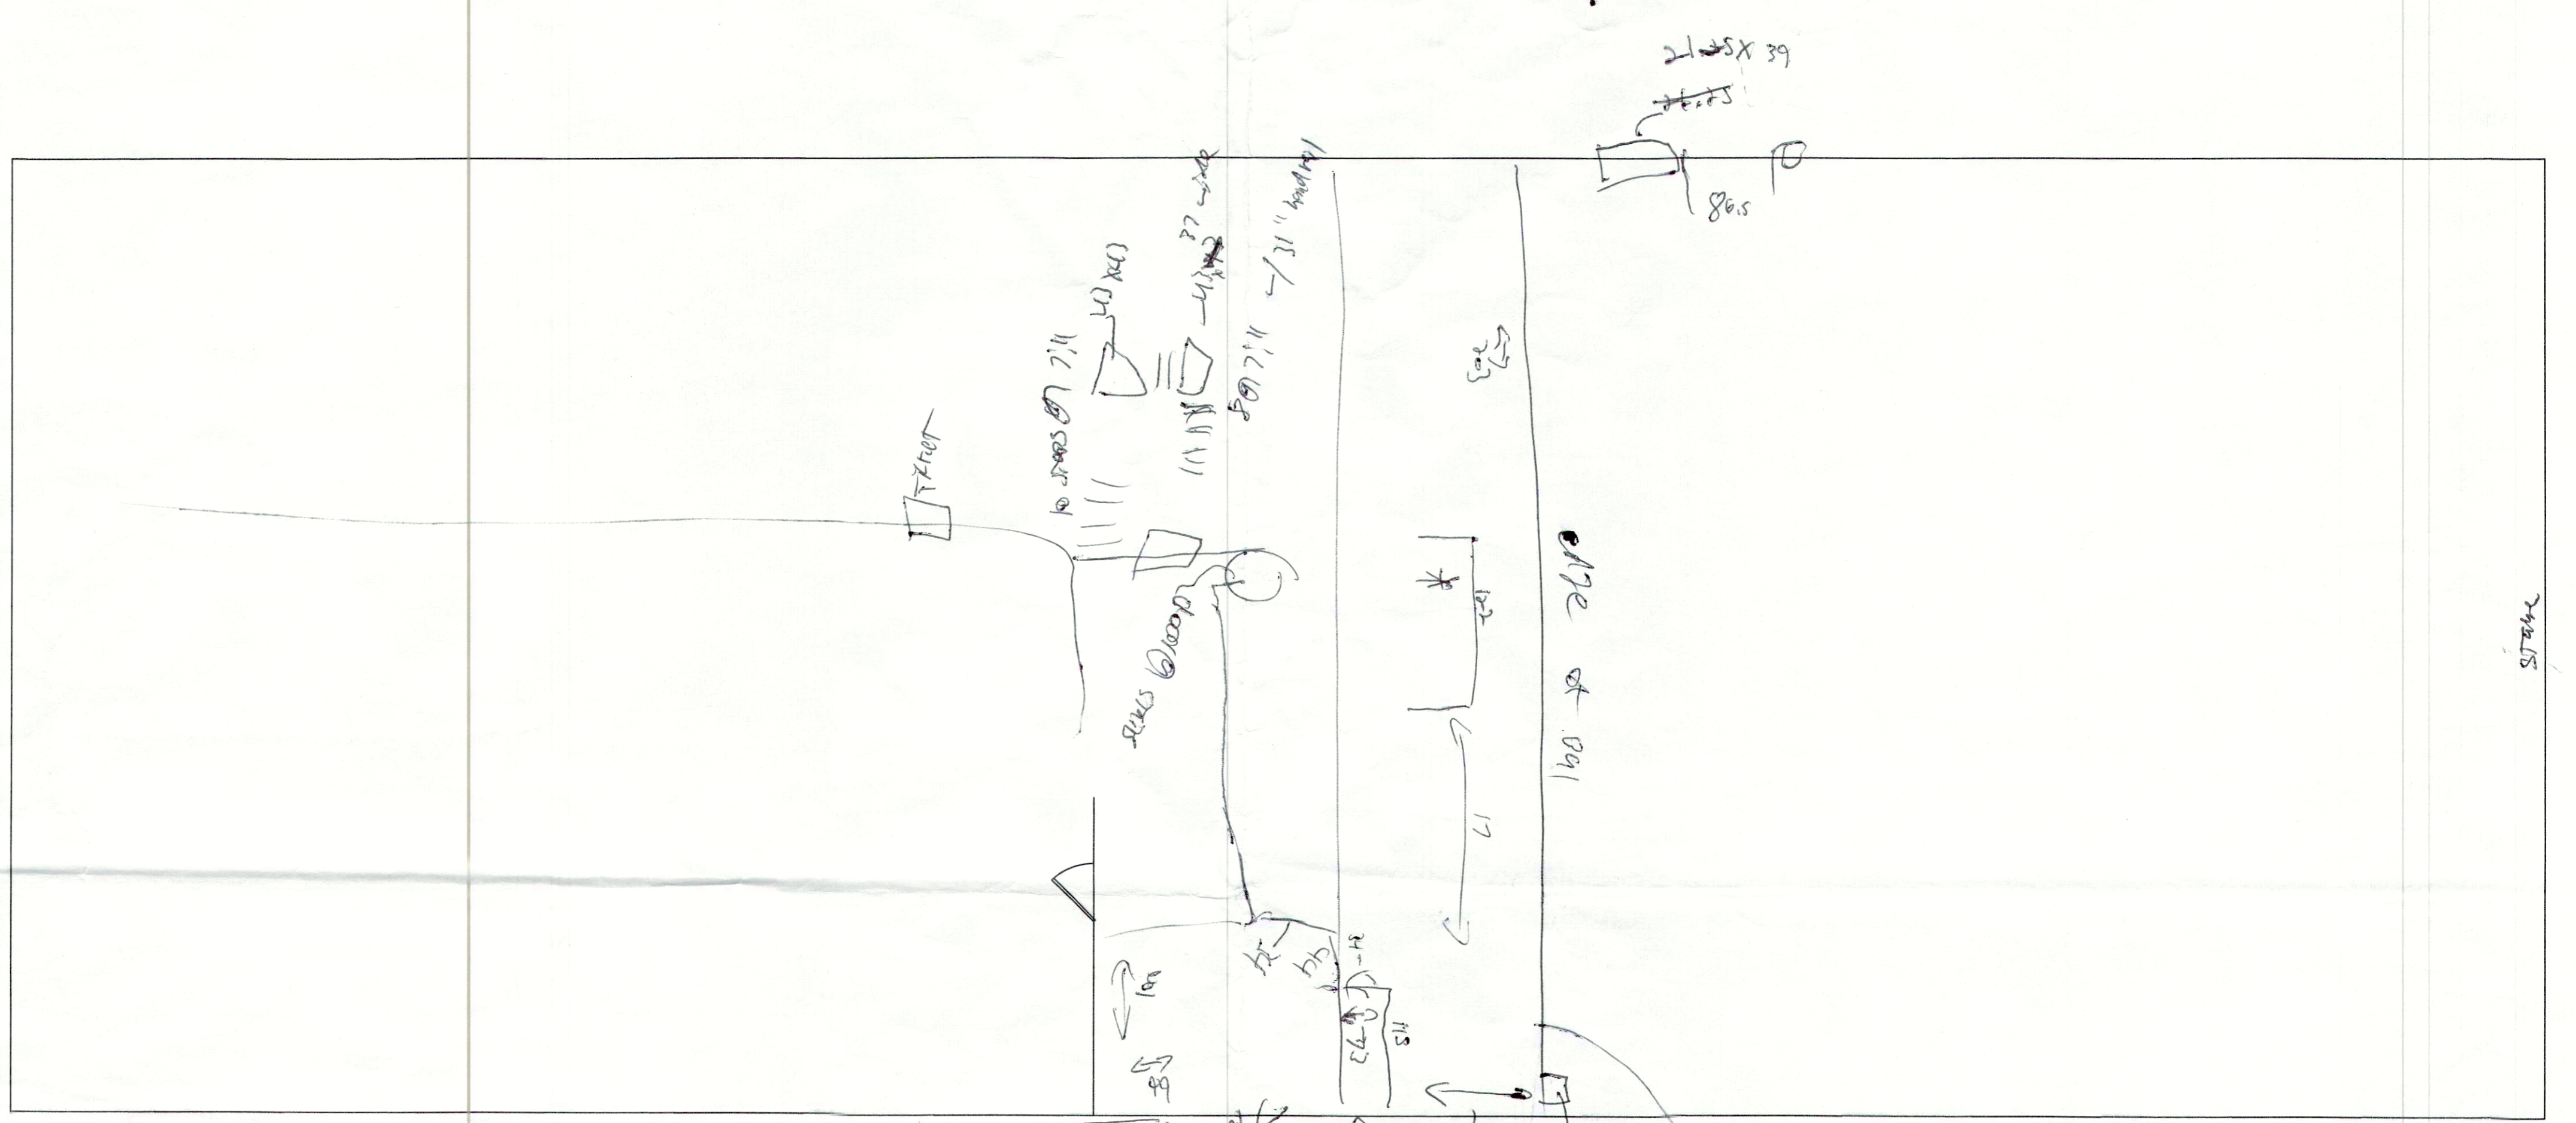

9' C STAIR

